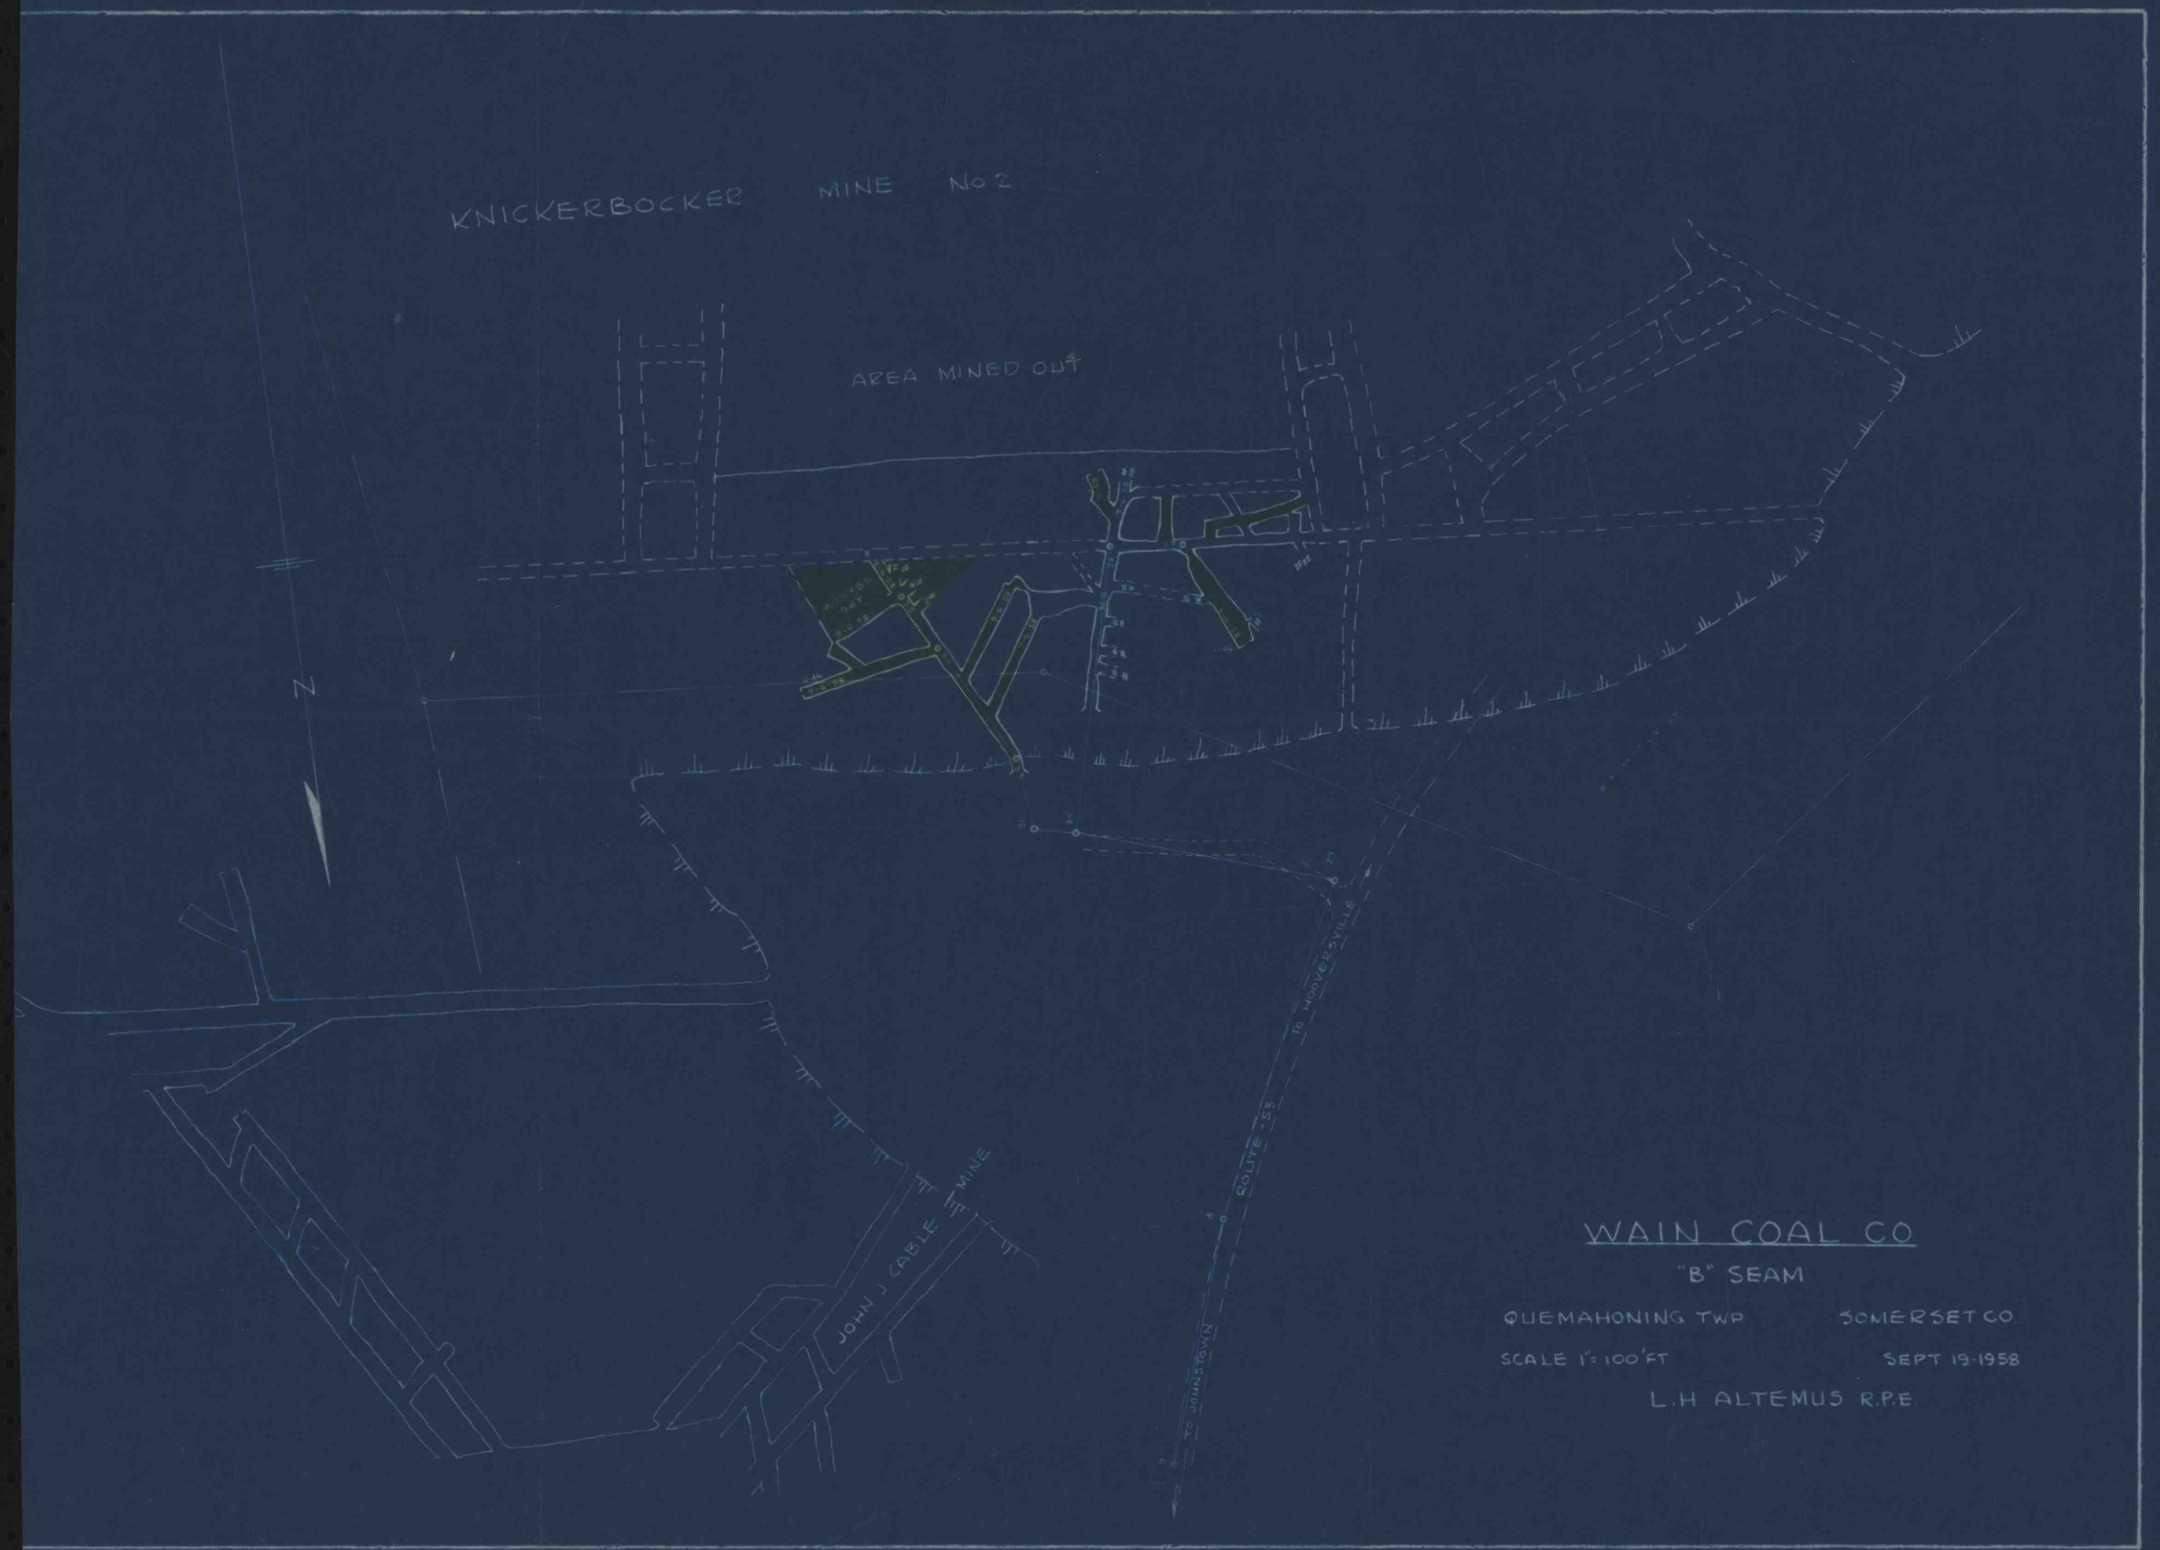
KNICKERBOCKER MINE No 2
AREA MINED OUT
N
JOHN J CABLE MINE
TO JOHNSTOWN
ROUTE 53
TO HOOVERSVILLE
WAIN COAL CO
"B" SEAM
QUEMAHONING TWP
SOMERSET CO
SCALE 1" = 100' FT
SEPT 19-1958
L.H ALTEMUS R.P.E

C-70-2