


KNICKERBOCKER MINE No. 2

AREA MINED OUT

WORKED OUT

JOHN J. CABLE MINE

ROUTE 53
TO HOOVERVILLE
TO JOHNSTOWN

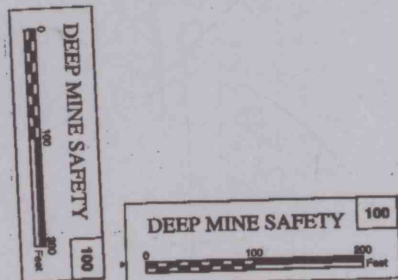

WAIN COAL CO.

"B" SEAM

QUEMAHONING TWP SOMERSET CO.

SCALE 1" = 100' FT SEPT. 19-1958

L.H. ALTEMUS R.P.E.

C-70-2

3597