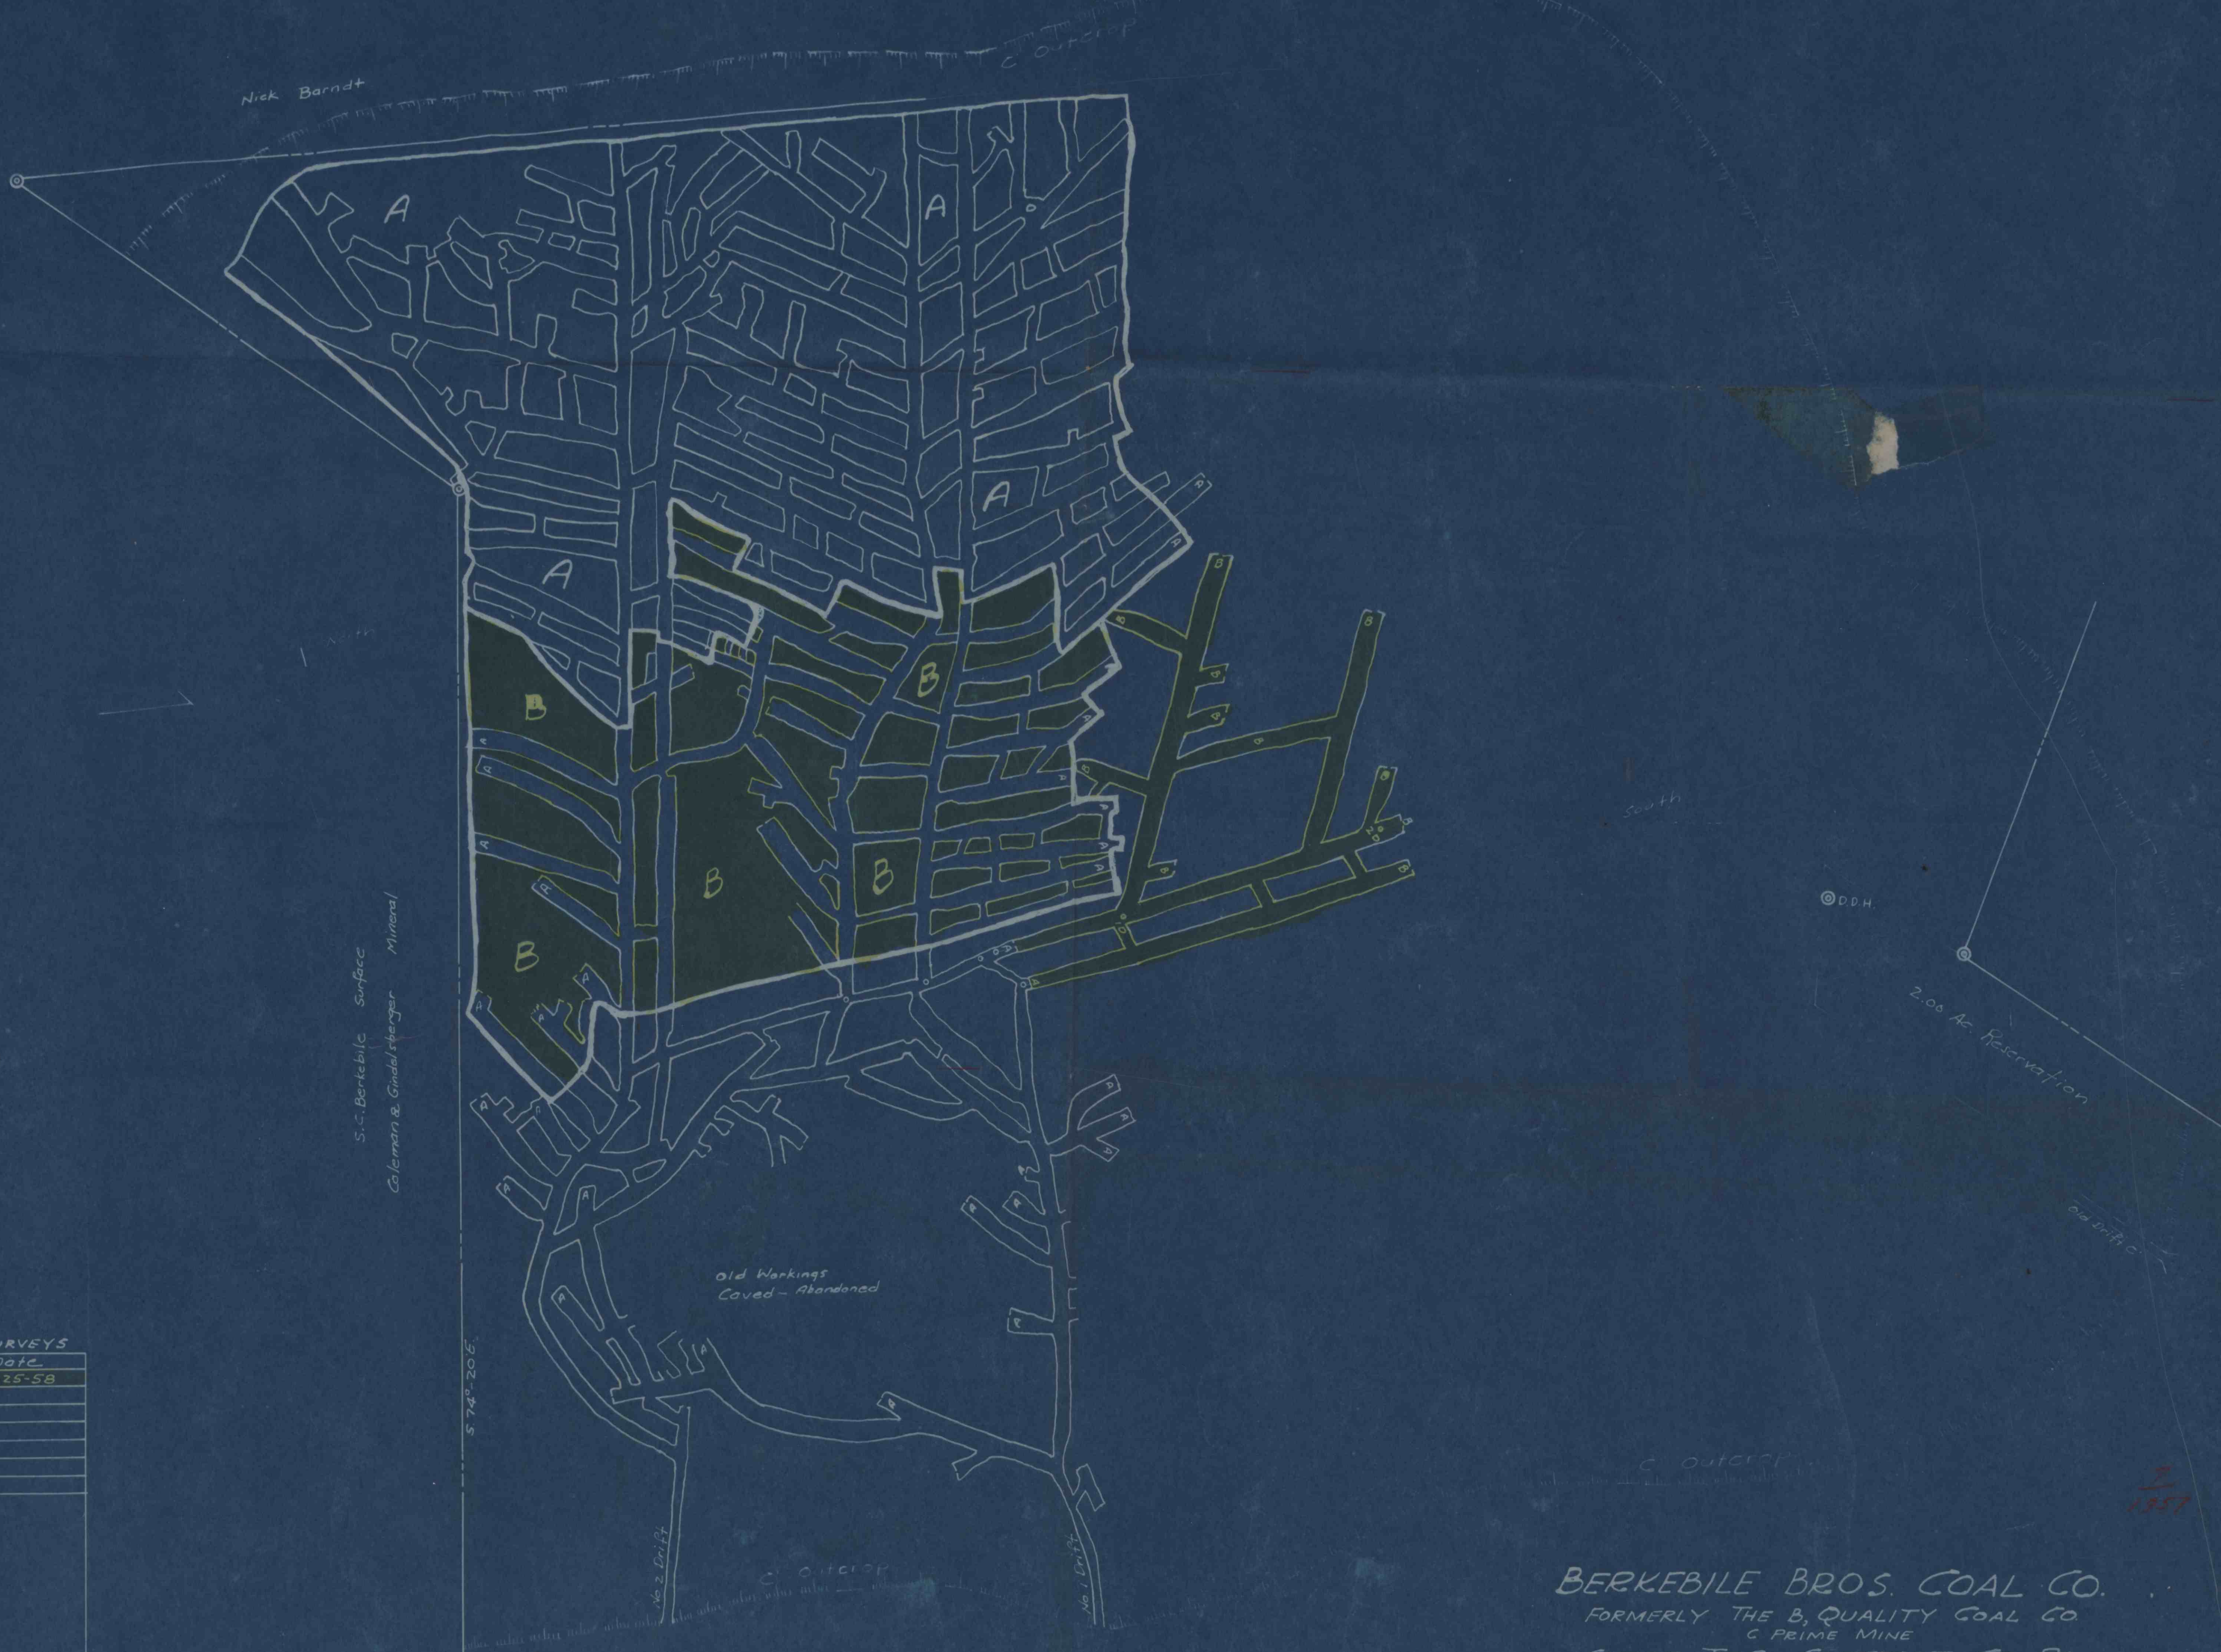

INDEX TO SURVEYS

Survey	Date
B	9-25-58

BERKEBILE BROS. COAL CO.

FORMERLY THE B, QUALITY COAL CO.
C PRIME MINE
SHADE TWP., SOMERSET CO., PA.
SCALE 1" = 100' - REVISED BY S.E. DICKEY & CO. - SEPT. 27, 1958
CIVIL AND MINING ENGINEERS
JOHNSTOWN, PA

8-A-181
F.B. 325 Pg. 47

Posted 10-14-1958

7
1957