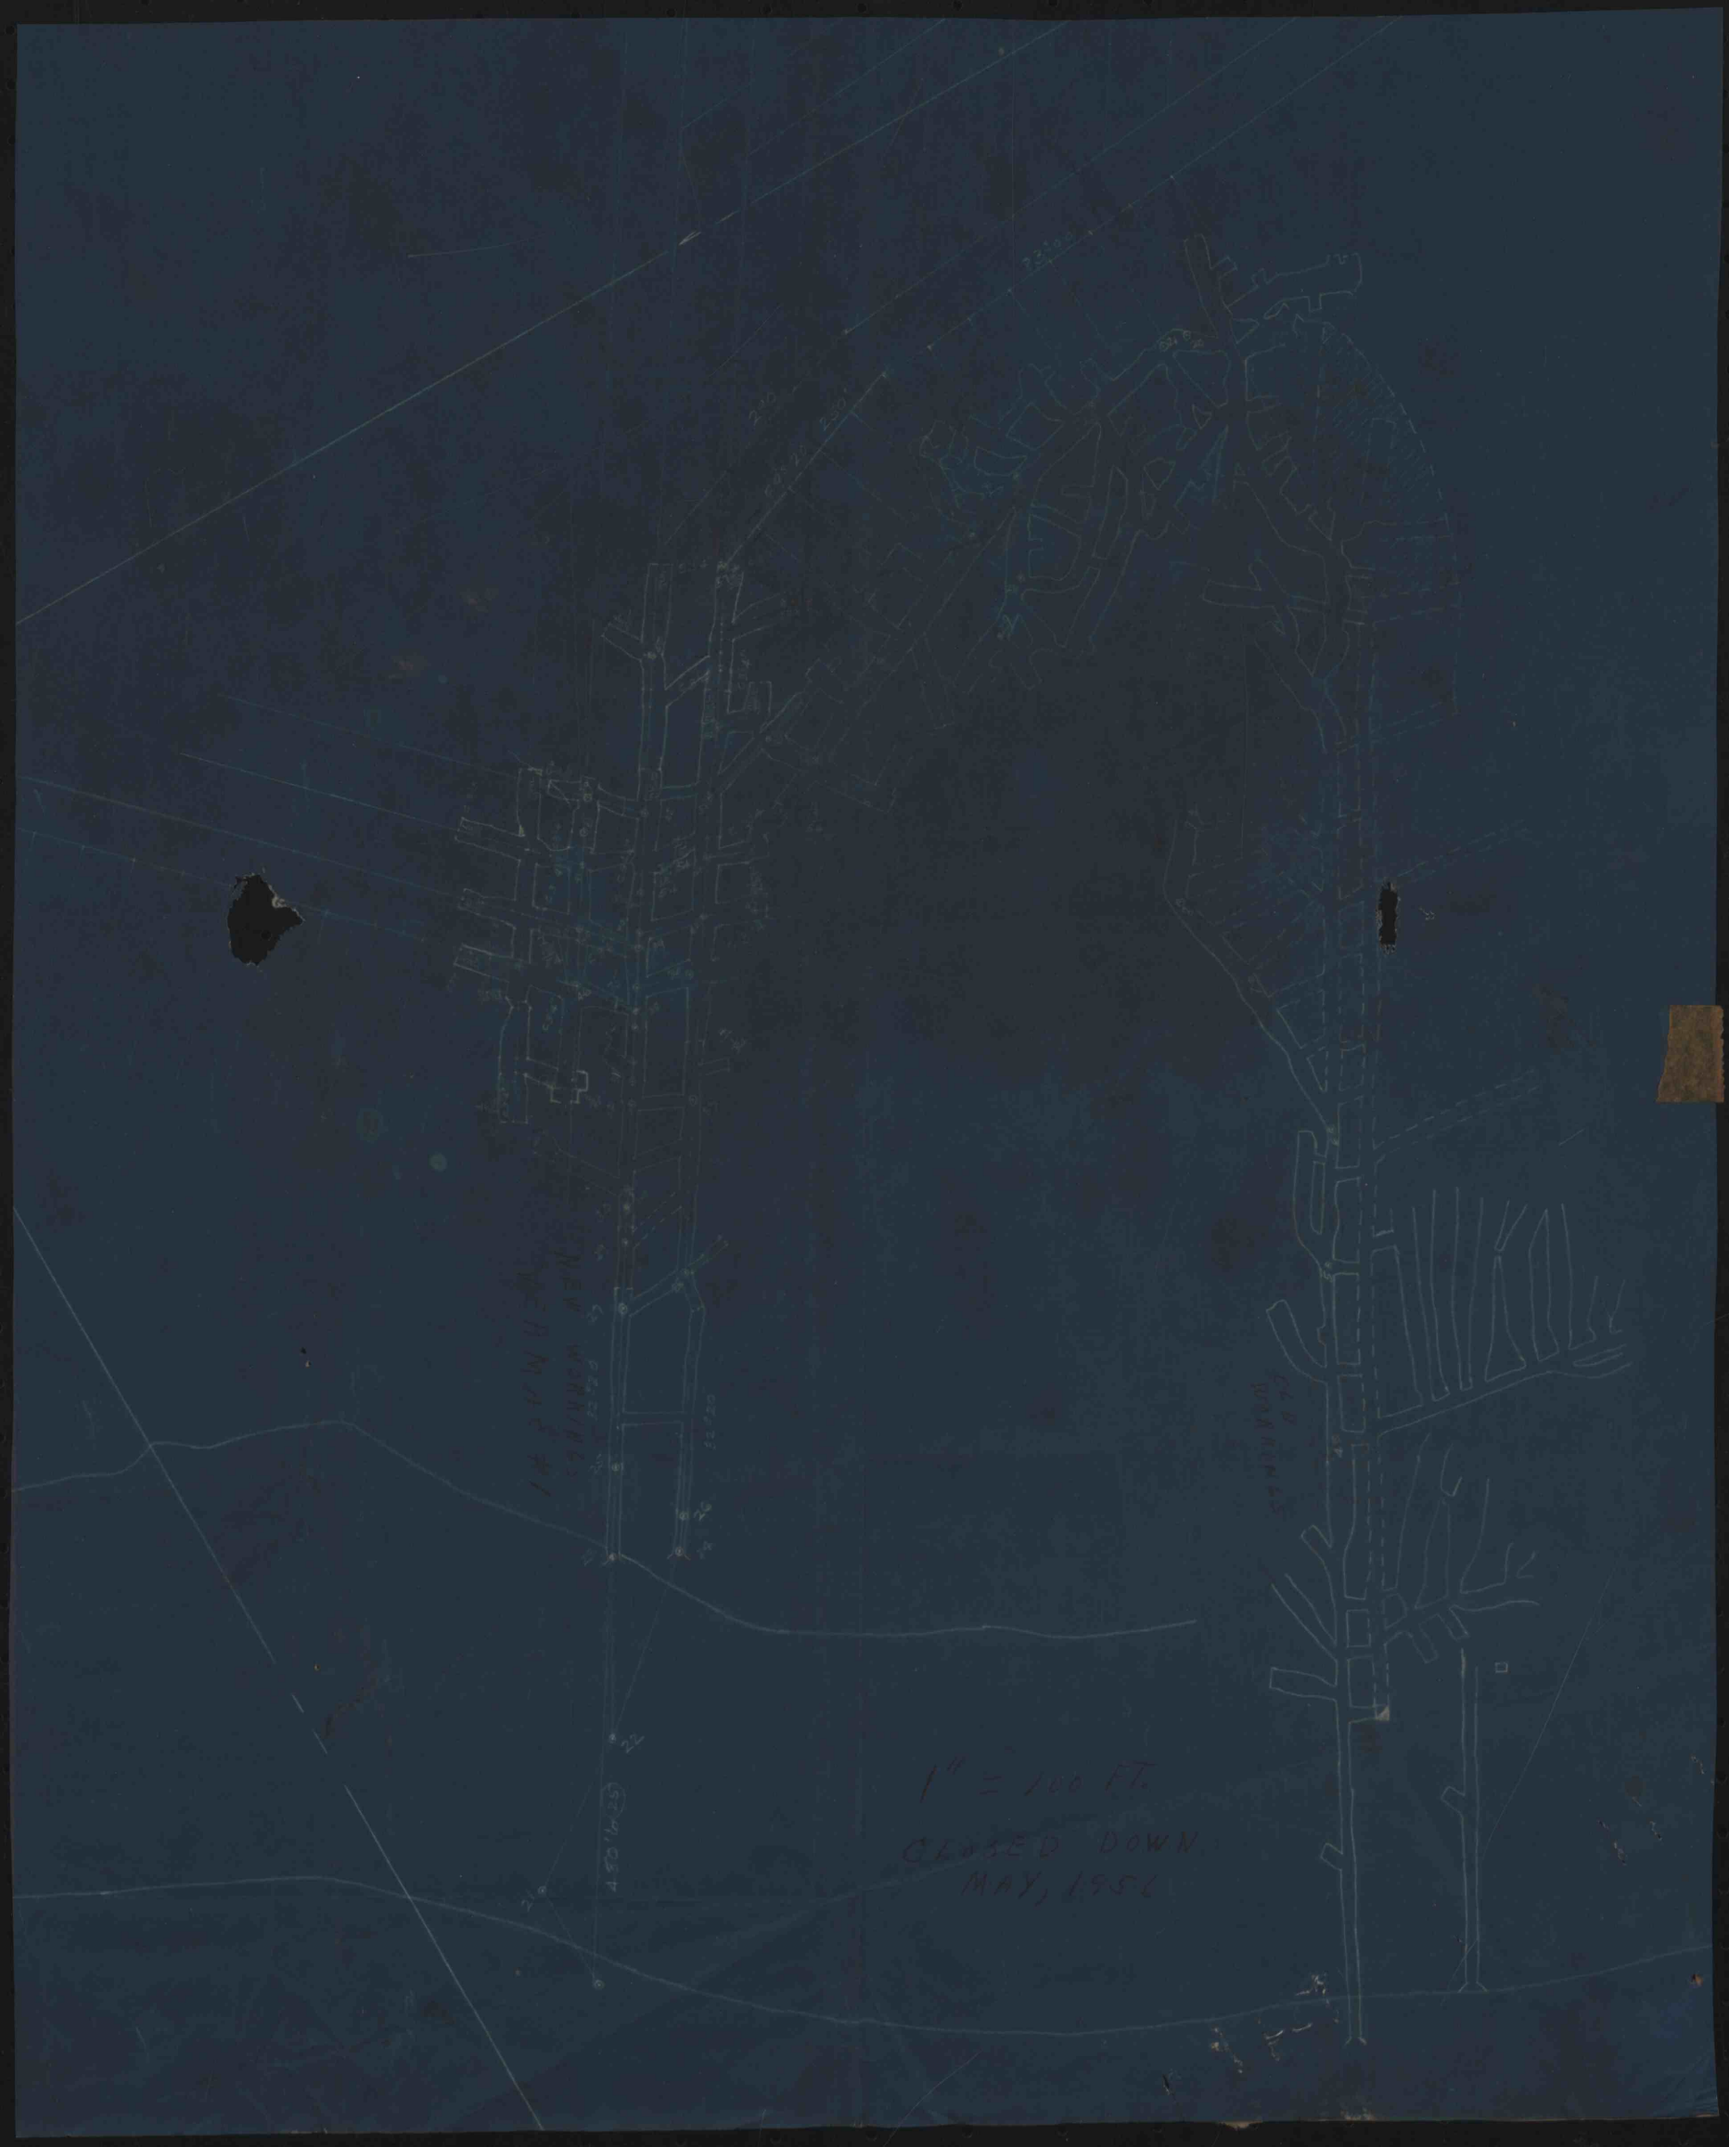
1" = 100 FT.
MAY, 1956