


Mining W.C. Co. Cool
12-17-54 to 7-14-55 = 0.02 AC.

Mined B.W.C.M. Co.
Out

Mined out
by previous operator

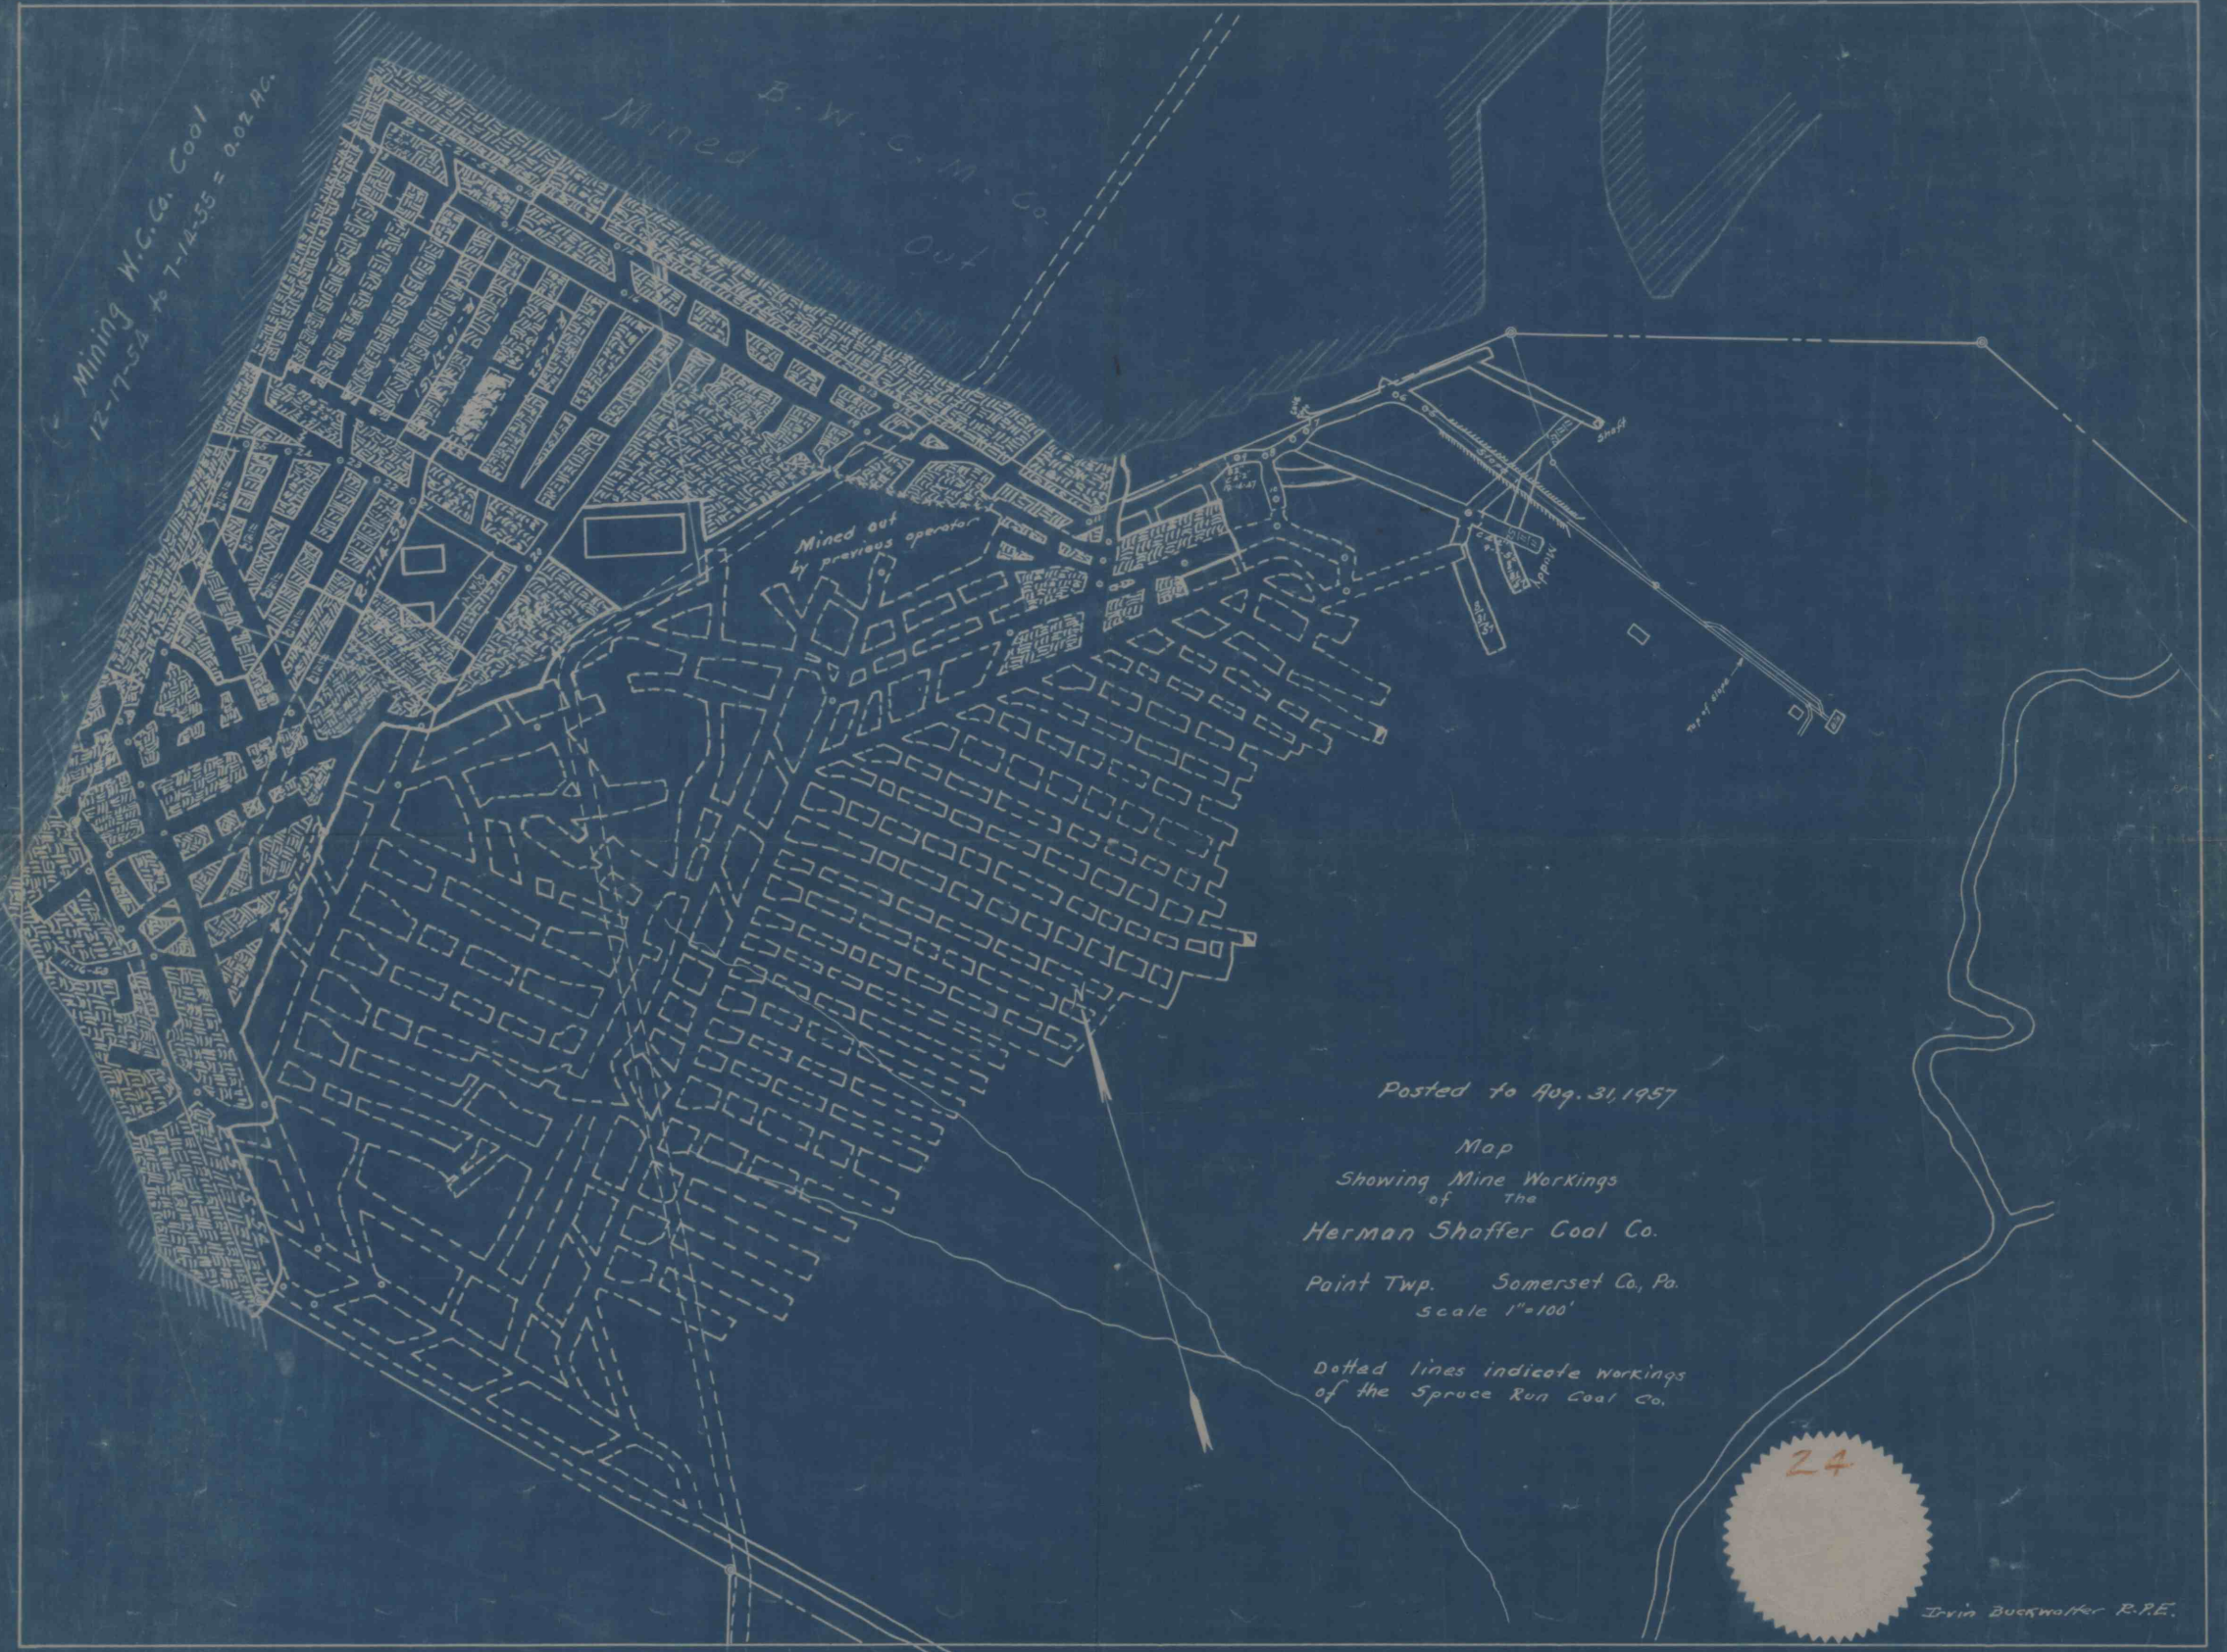

Posted to Aug. 31, 1957

Map
Showing Mine Workings
of The
Herman Shaffer Coal Co.

Point Twp. Somerset Co., Pa.
scale 1"=100'

Dotted lines indicate workings
of the Spruce Run Coal Co.

24

Irvin Buckwalter R.P.E.