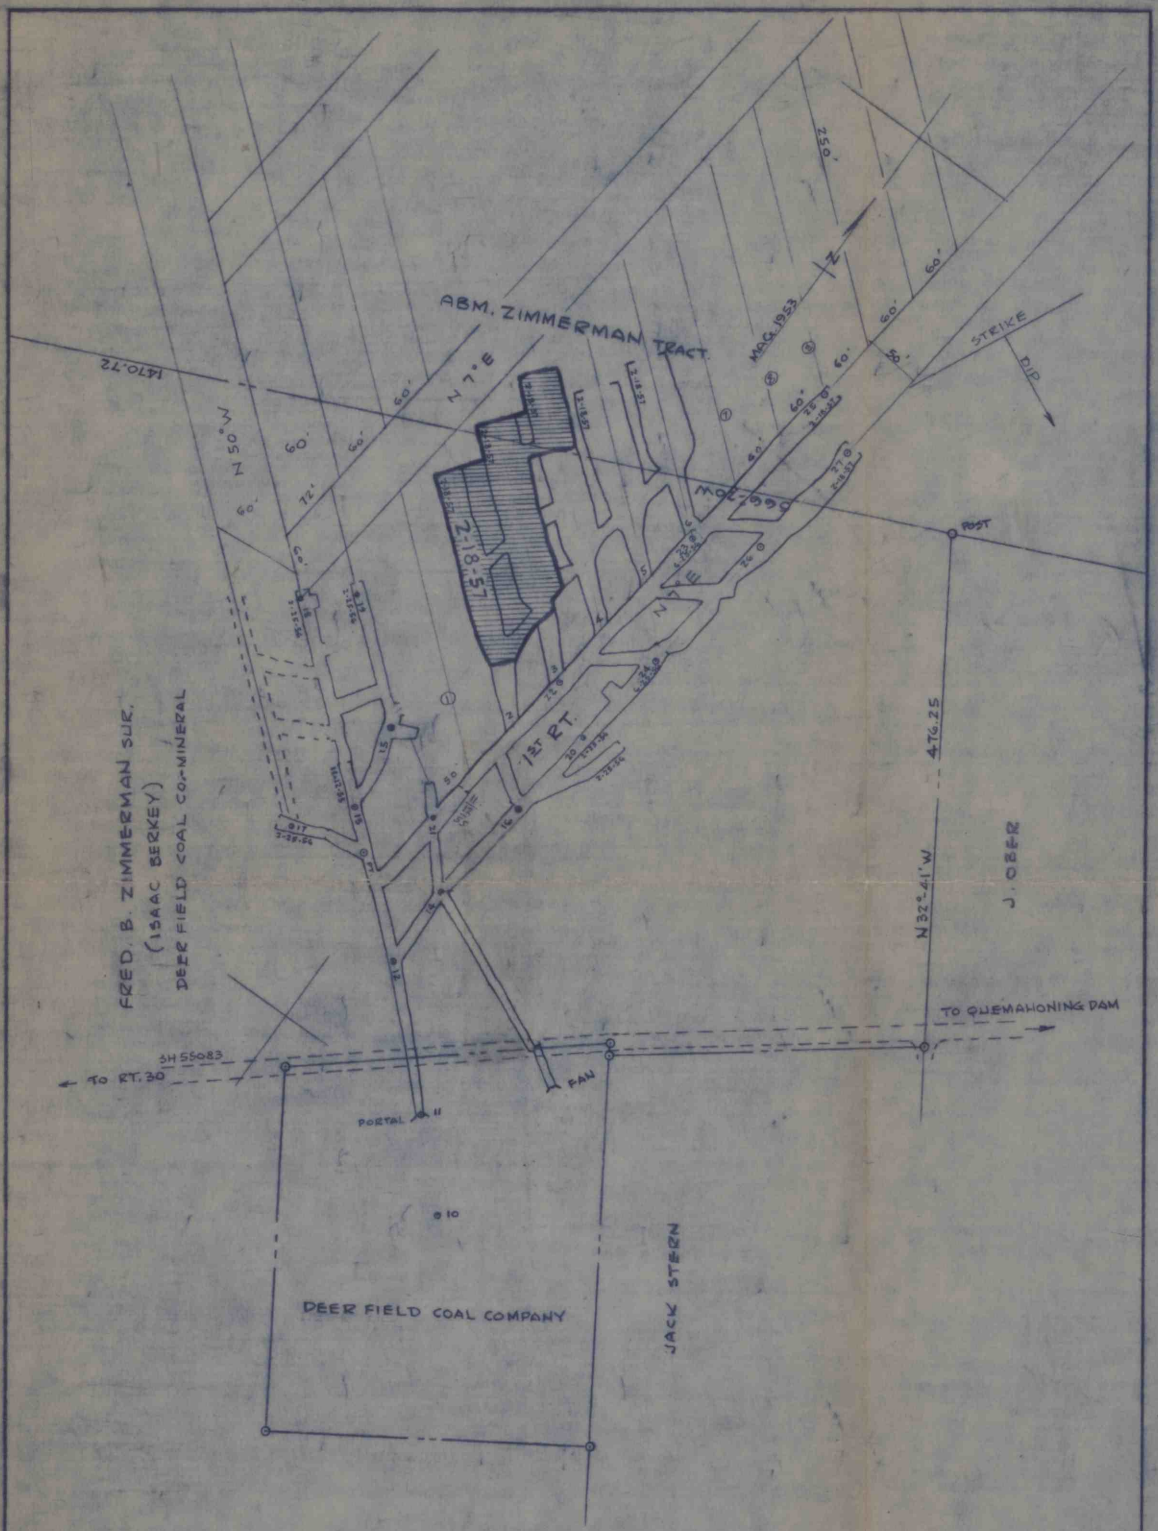

HIGGINS RUN COAL CO.
MINING OPERATION
"C" PRIME SEAM
QUEMAHONING TWP. SOMERSET Co. PA
SCALE-1"=100' 11-19-55
L. H. ALTEMUS R.P.E.

DIST 20

11-A-74