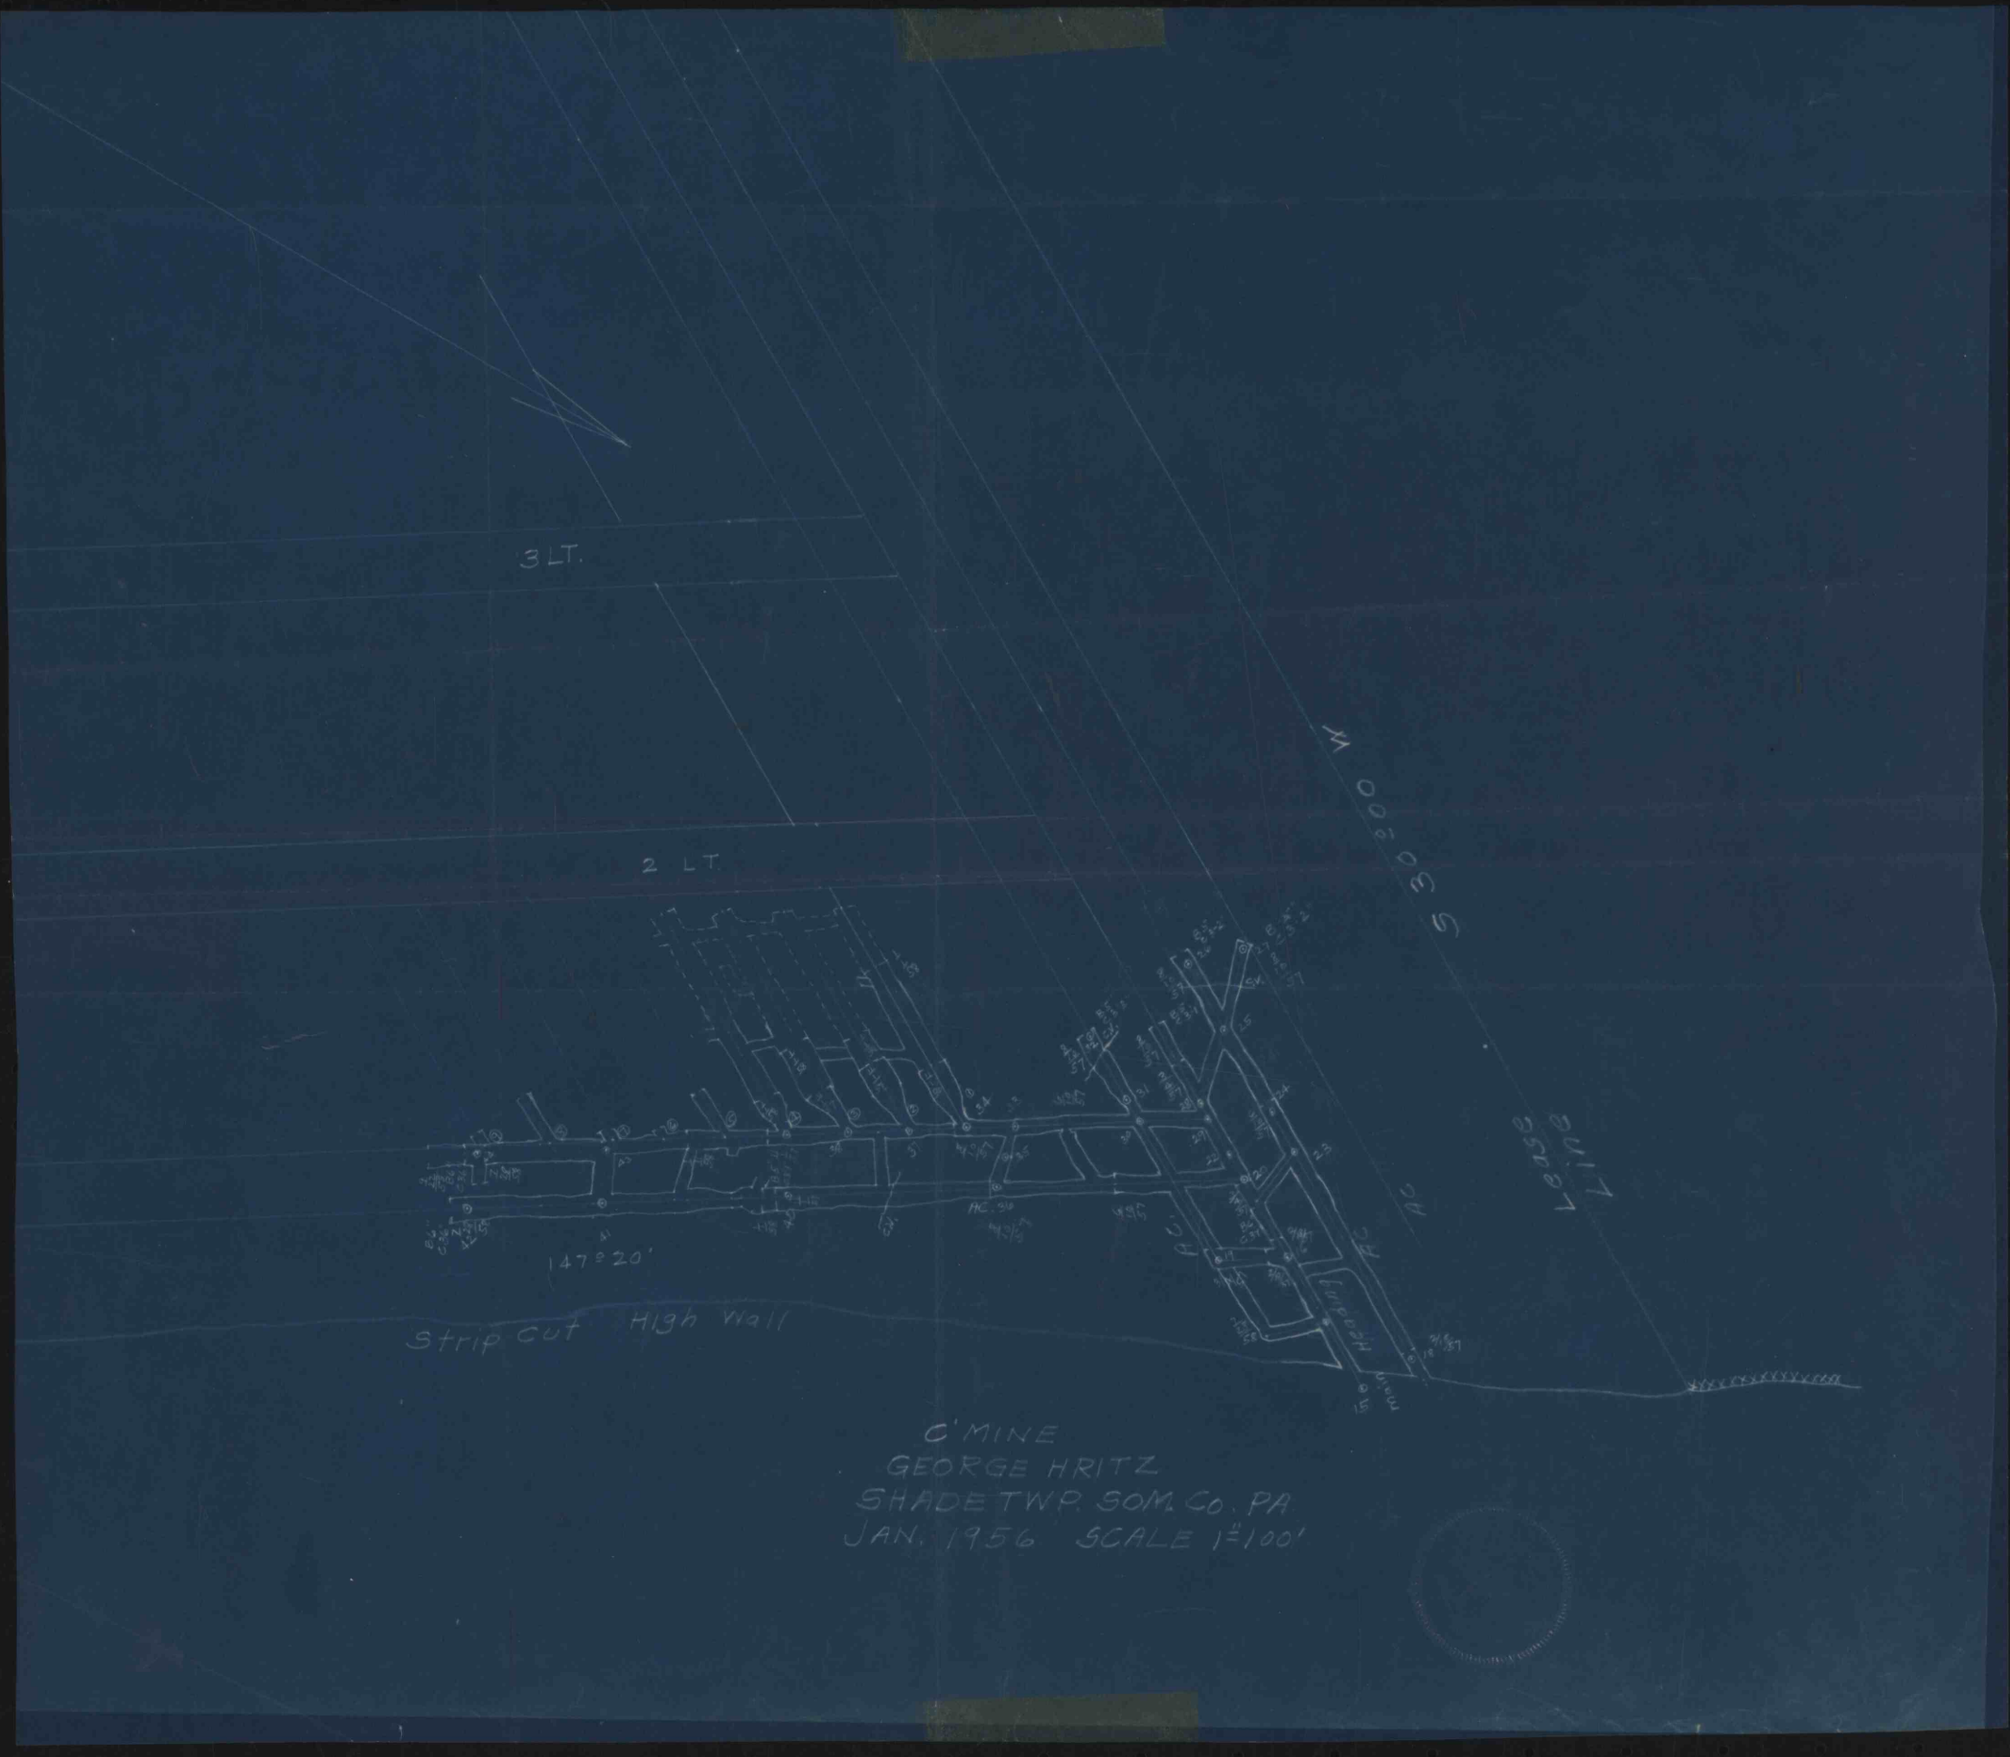
3 LT.
2 LT.
Lease Line
147 = 20'
Strip Cut High Wall
C MINE
GEORGE HRITZ
SHADE TWP. SOM. CO. PA
JAN. 1956 SCALE 1" = 100'