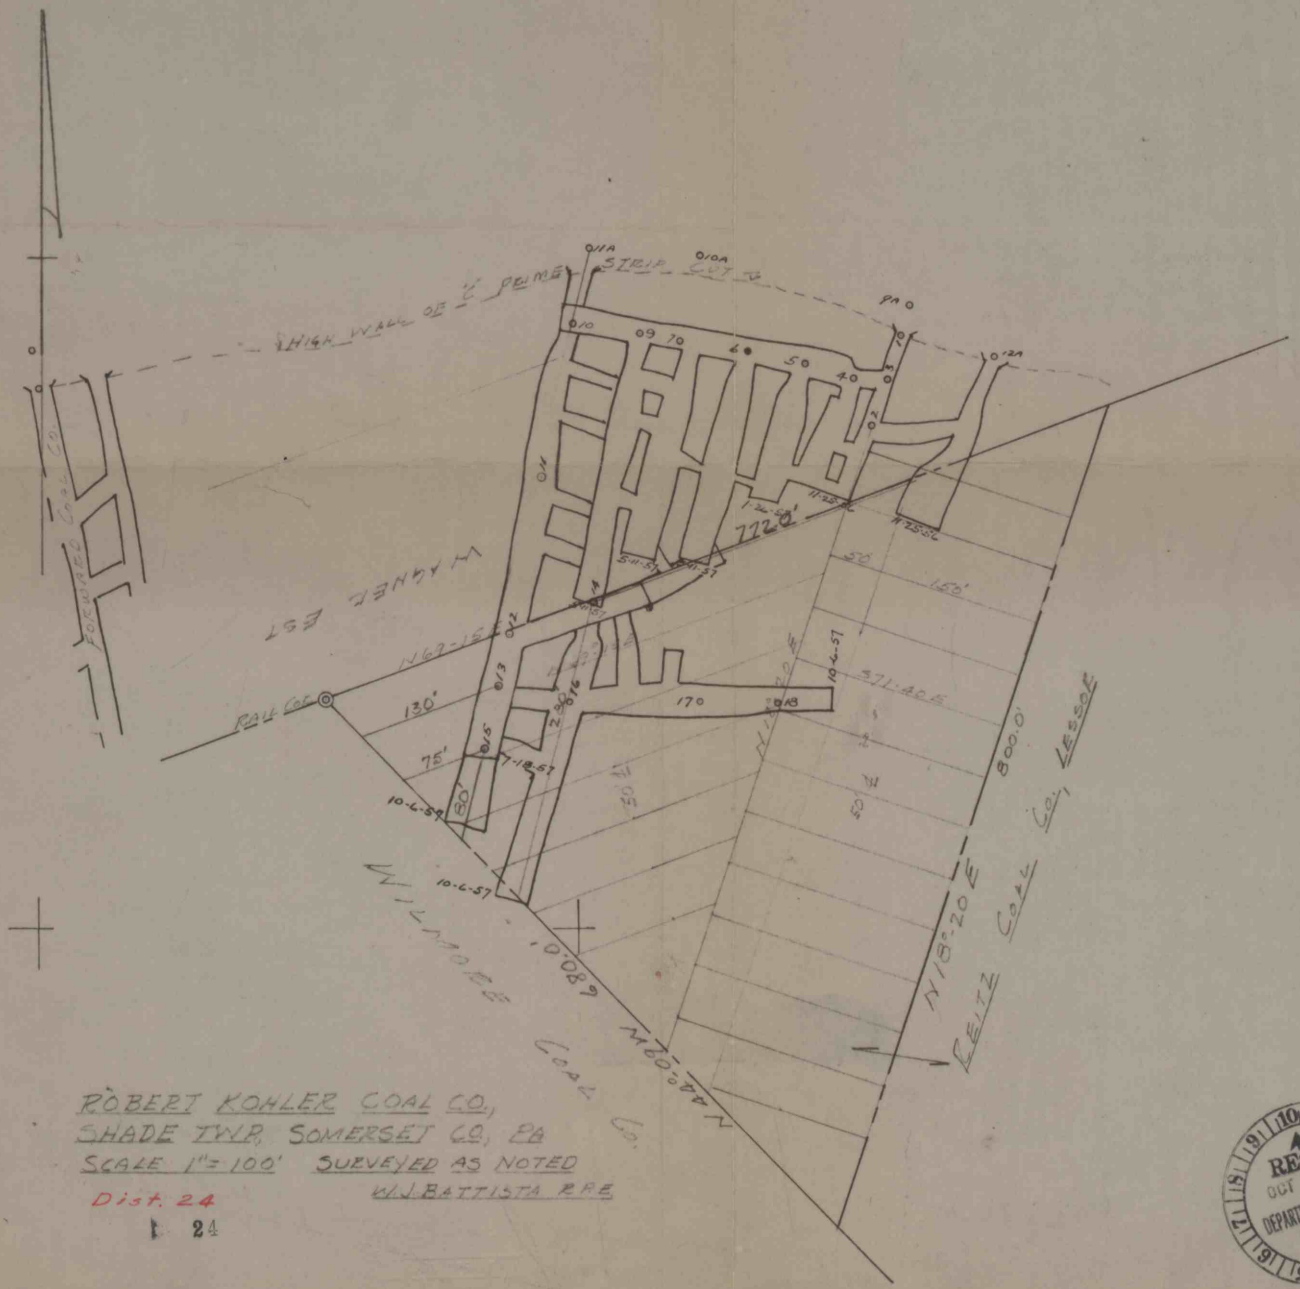

ROBERT KOHLER COAL CO.,
SHADE TWP. SOMERSET CO. PA
SCALE 1"= 100' SURVEYED AS NOTED
W.J. BATTISTA R.P.E.

Dist. 24

24

REC'D
OCT 25 1957
DEPARTMENT OF MINES