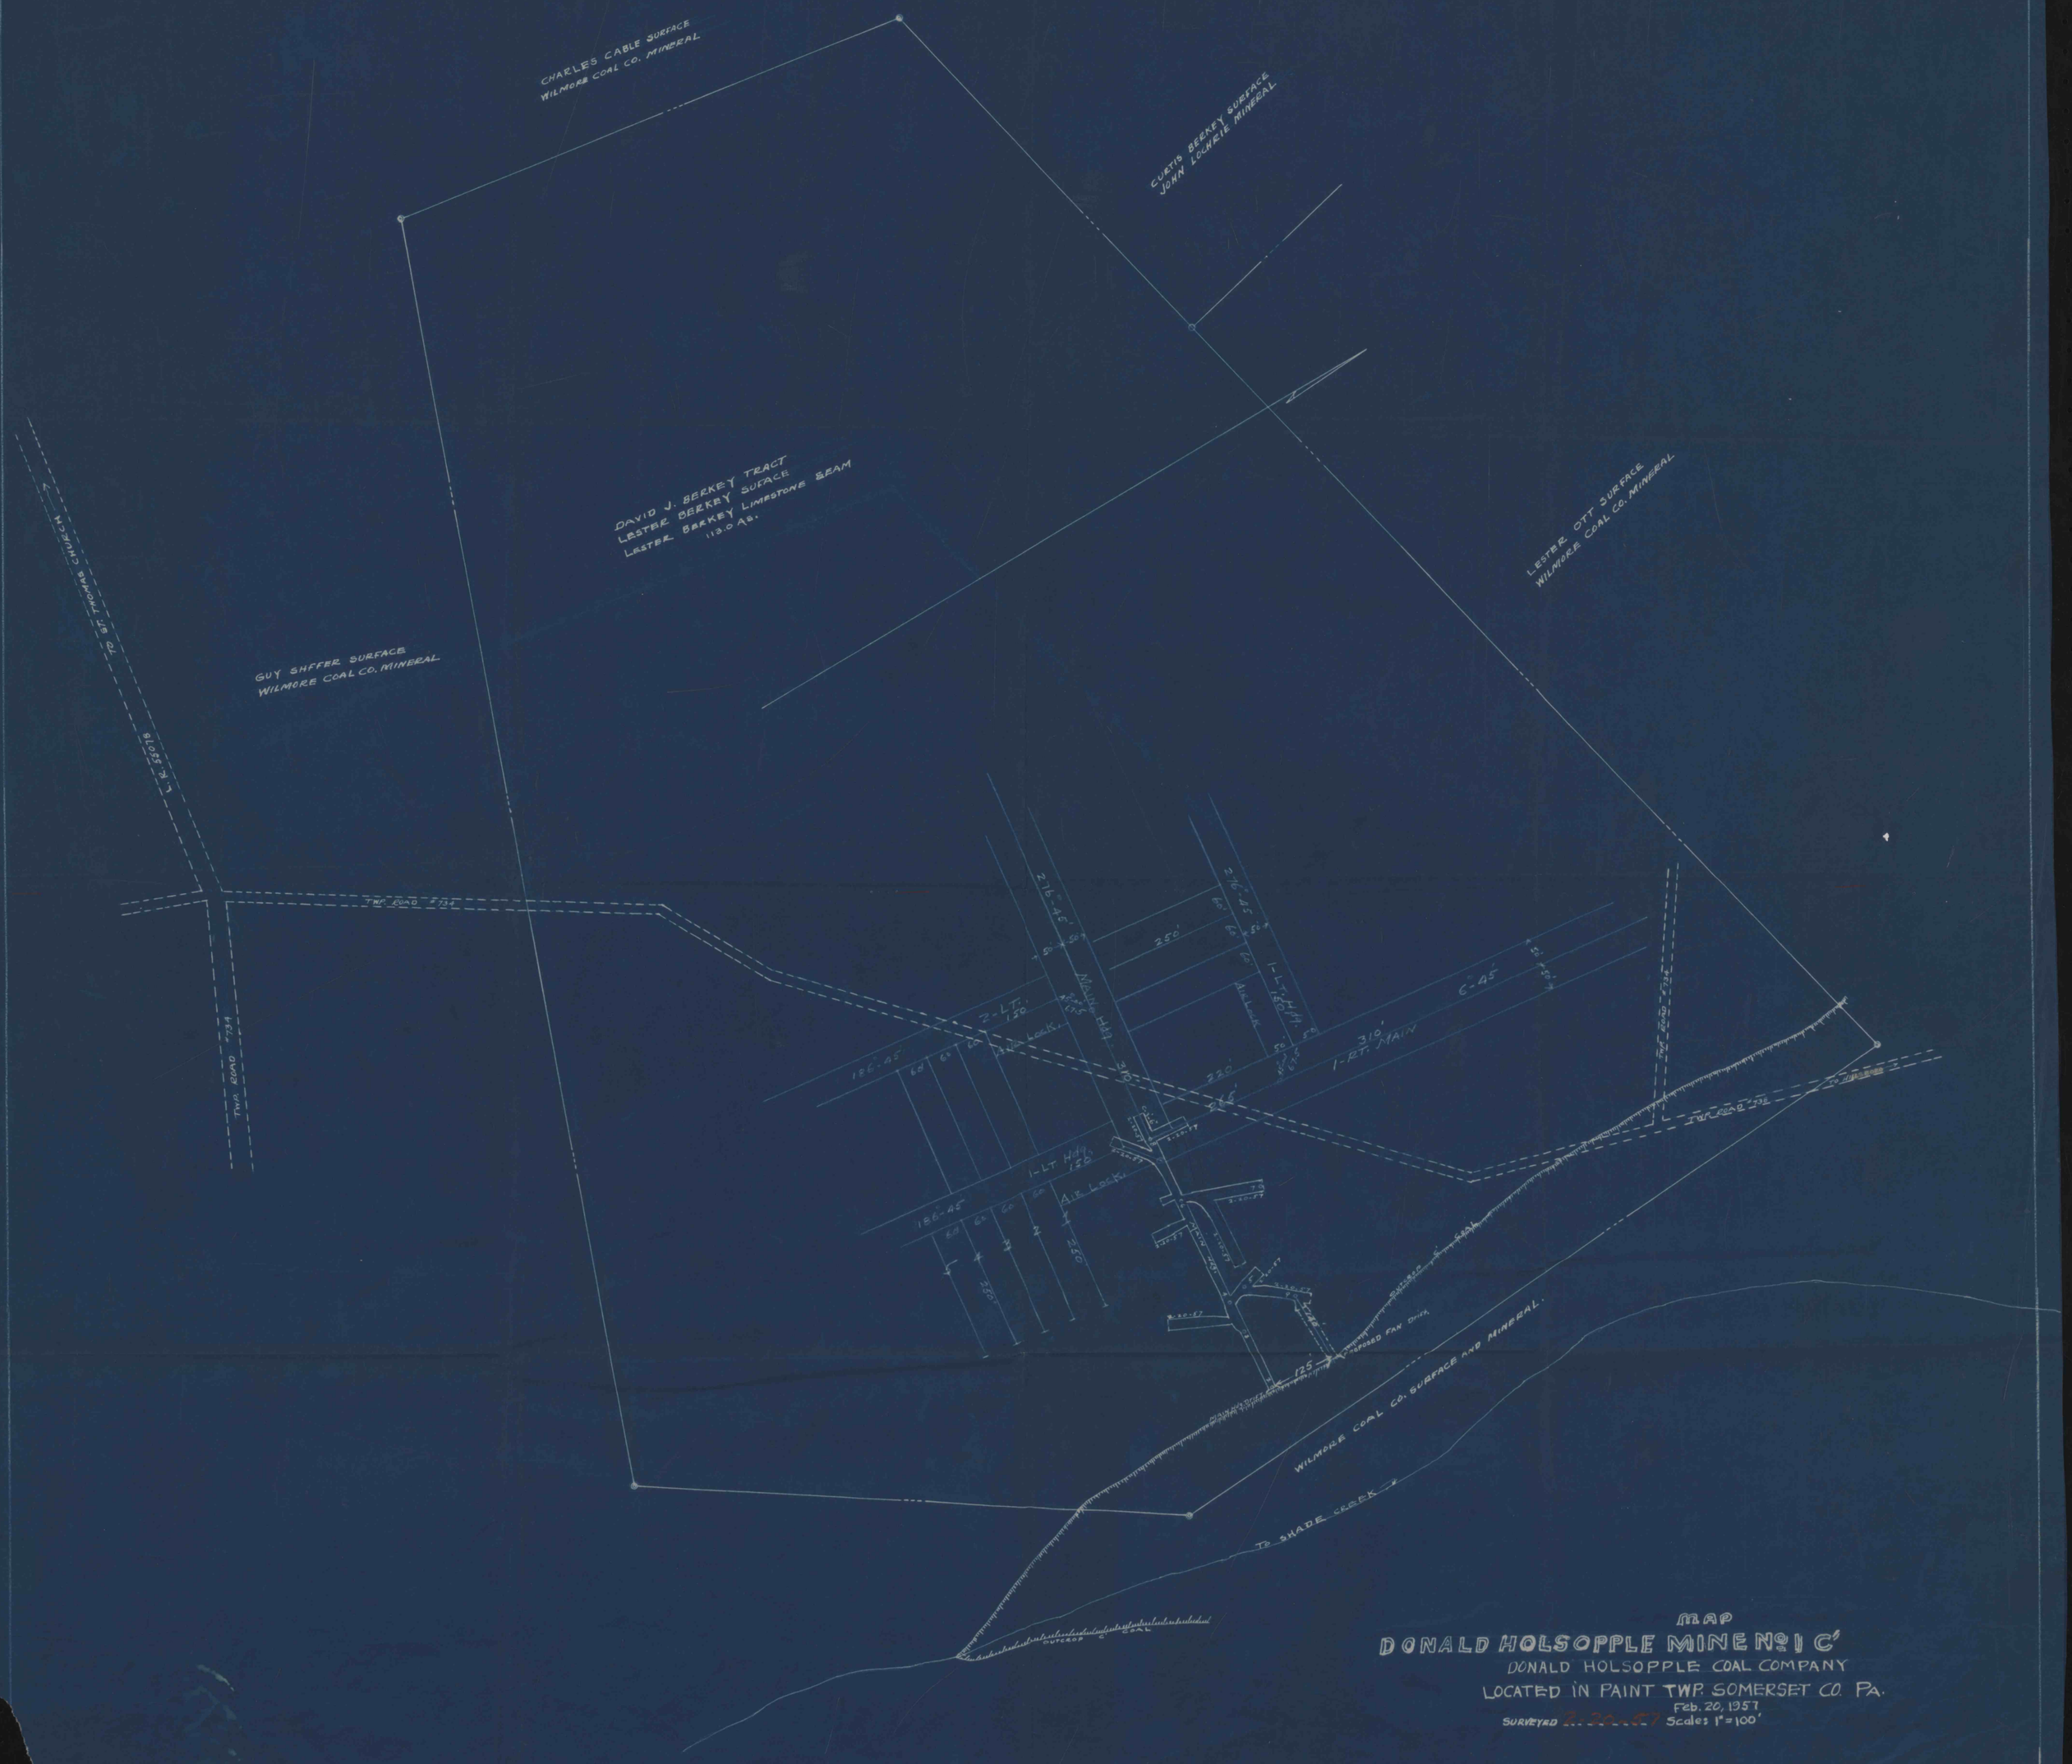

MAP

DONALD HOLSOPPLE MINE No. 1 C'

DONALD HOLSOPPLE COAL COMPANY

LOCATED IN PAINT TWP. SOMERSET CO. PA.

Feb. 20, 1957

SURVEYED 2-20-57 Scale: 1" = 100'