

ROAD


S42°06'E

ORIGINAL TRACT

W. J. STUFF

NOTE
295 FT FROM LINE
TO PROPERTY LINE

MAGNETIC 1932

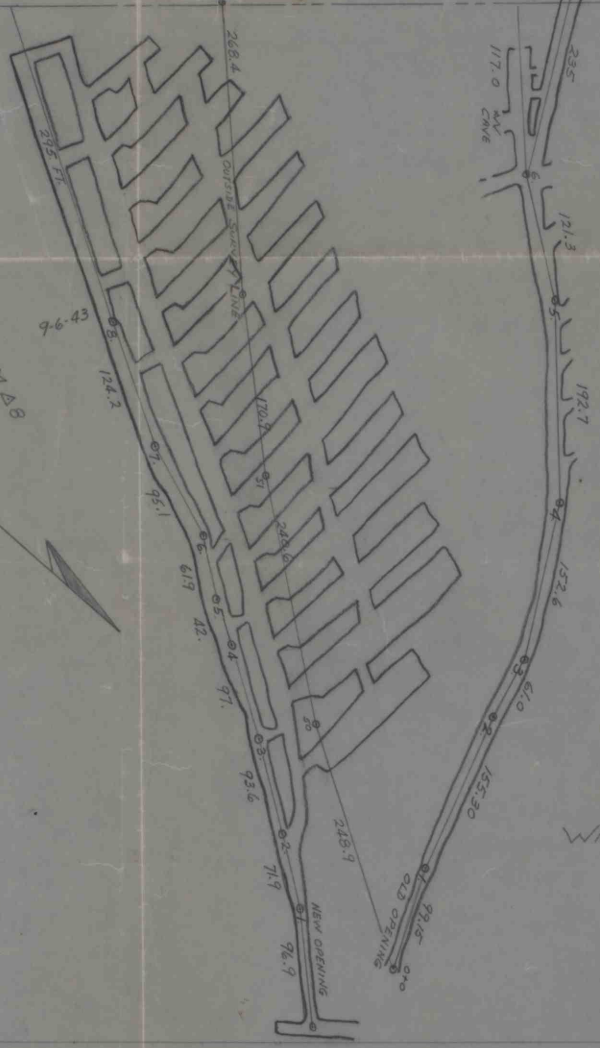

W. J. STUFF

WILLIAM STUFF MINE
E. SEAM
SCALE 1"=100'

HENRY SHIFFER

CHARLES REAM

Stuff Coal Co., W. J.
Stuff
Somerset Co., District 7
1956 Annual

