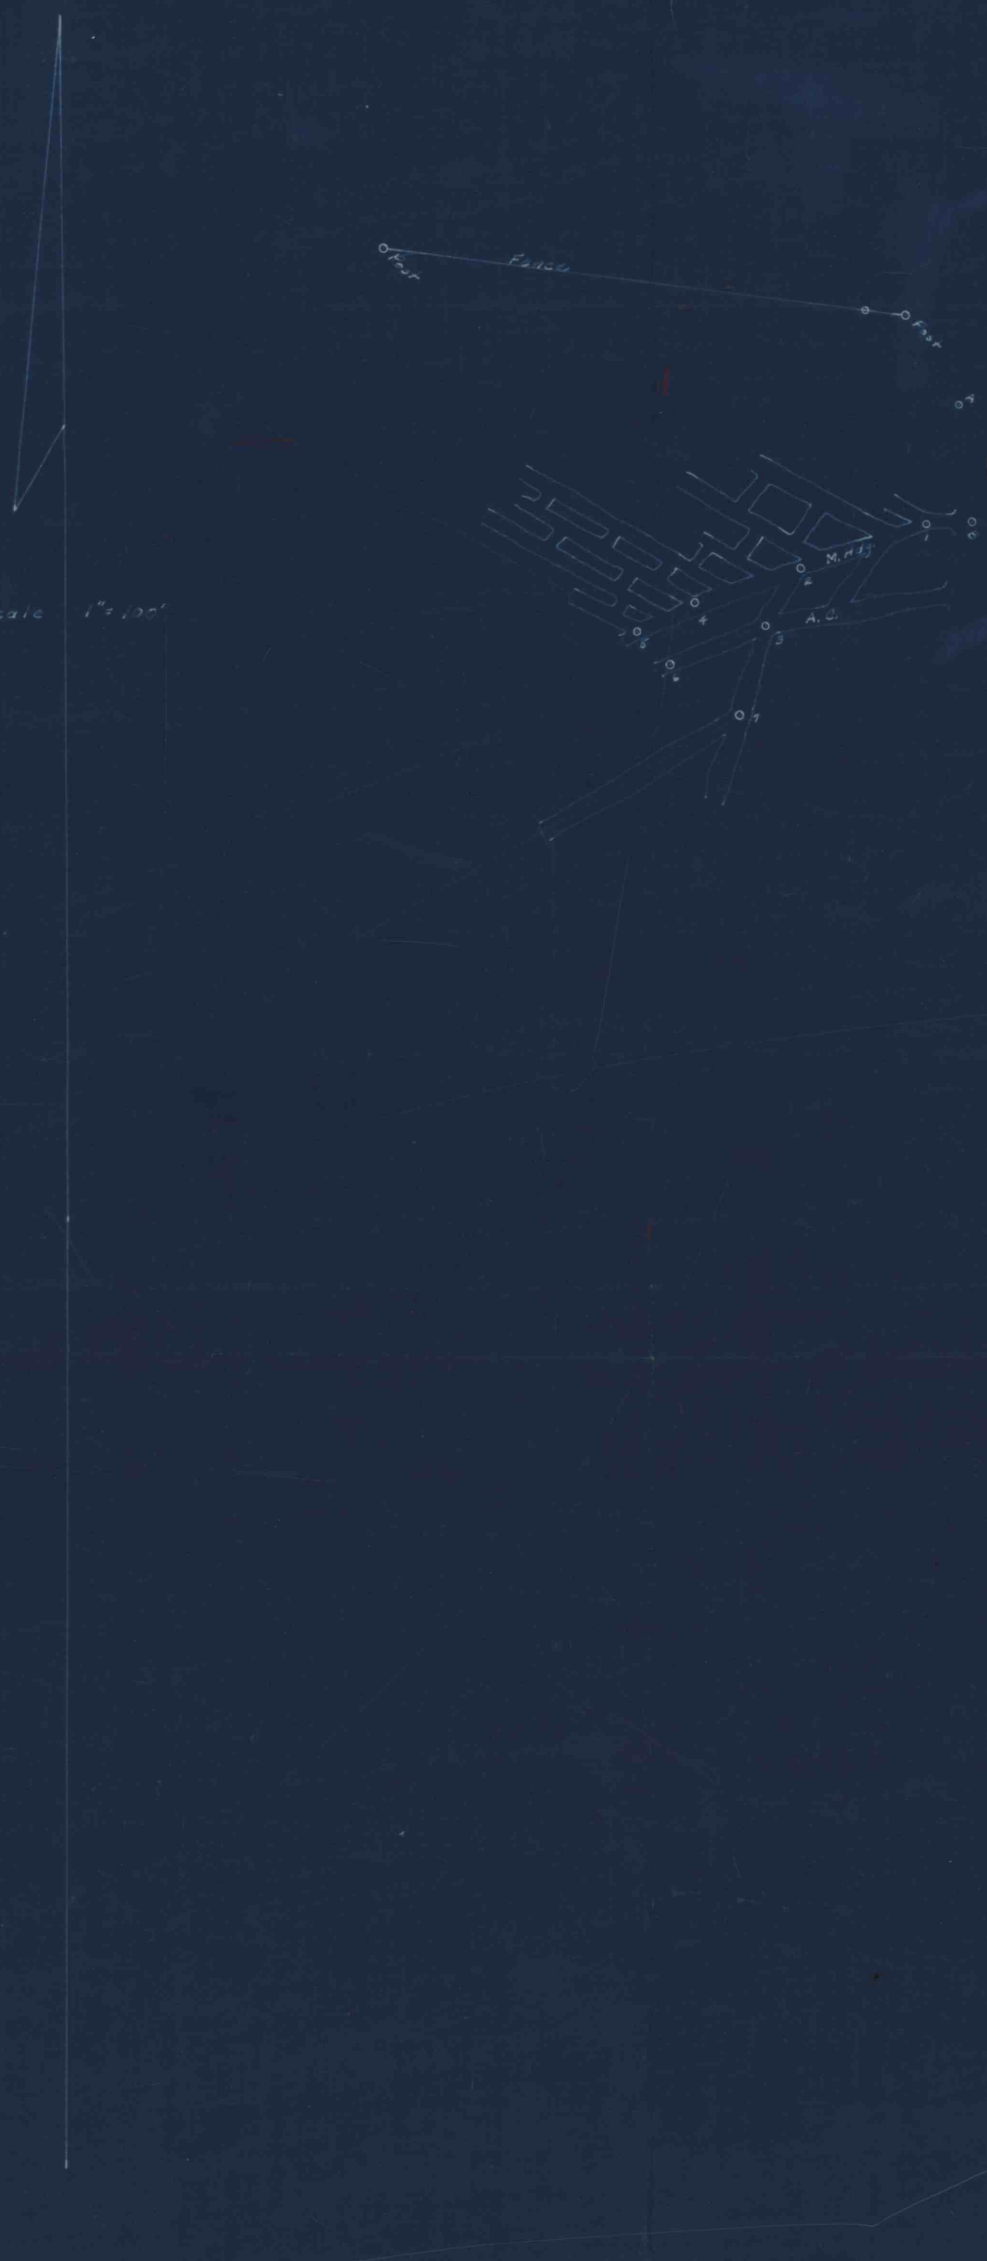

Frank Eckman Mine
Vera Huston Property
Milford Twp. Somerset Co. Pa.
1.2 Miles East of New Centerville Boro.

Record of Surveys

Date	Name
1st Sept. 1967	Wayne Sisler R.S.