


NICK IONNE LANDS

N 63° 56' 45\"/>


HANOVER TWP
SCHOOL LANDS
712 AC.

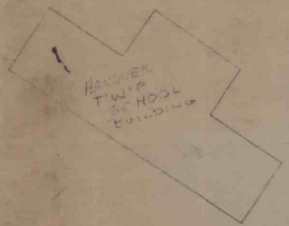

DEULAH GARDNER
10 AC. SUR.

Barnhart, Henry 17-1956
Barnhart No. 1 WAS

GARDNER FARM
25.519 AC
SUR.

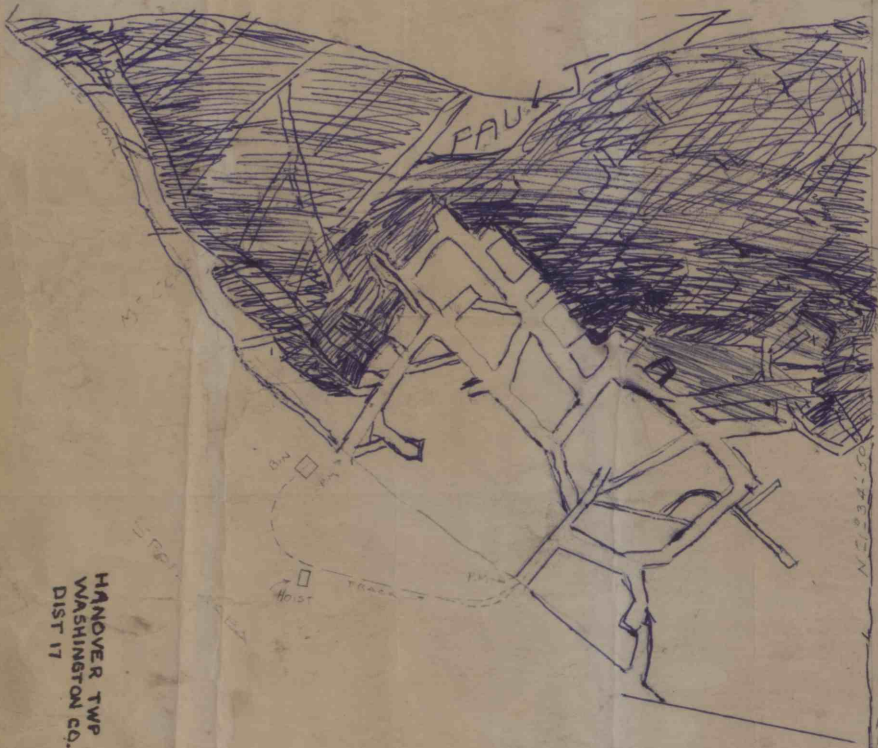

HANOVER TWP
WASHINGTON CO.
DIST 17

BARNHART CORL CO.
HARRISBURG, PA.
NEA SWREMENTS
UP TO DATE
8/24/57

PLAN
SHOWING
MINING OPERATION
McCRACKEN FARM
HANOVER TWP. WASH. CO. PA.
Nov, 1955

1" = 100'

GEN'L ENGR'G
WEIRTON, W.VA.