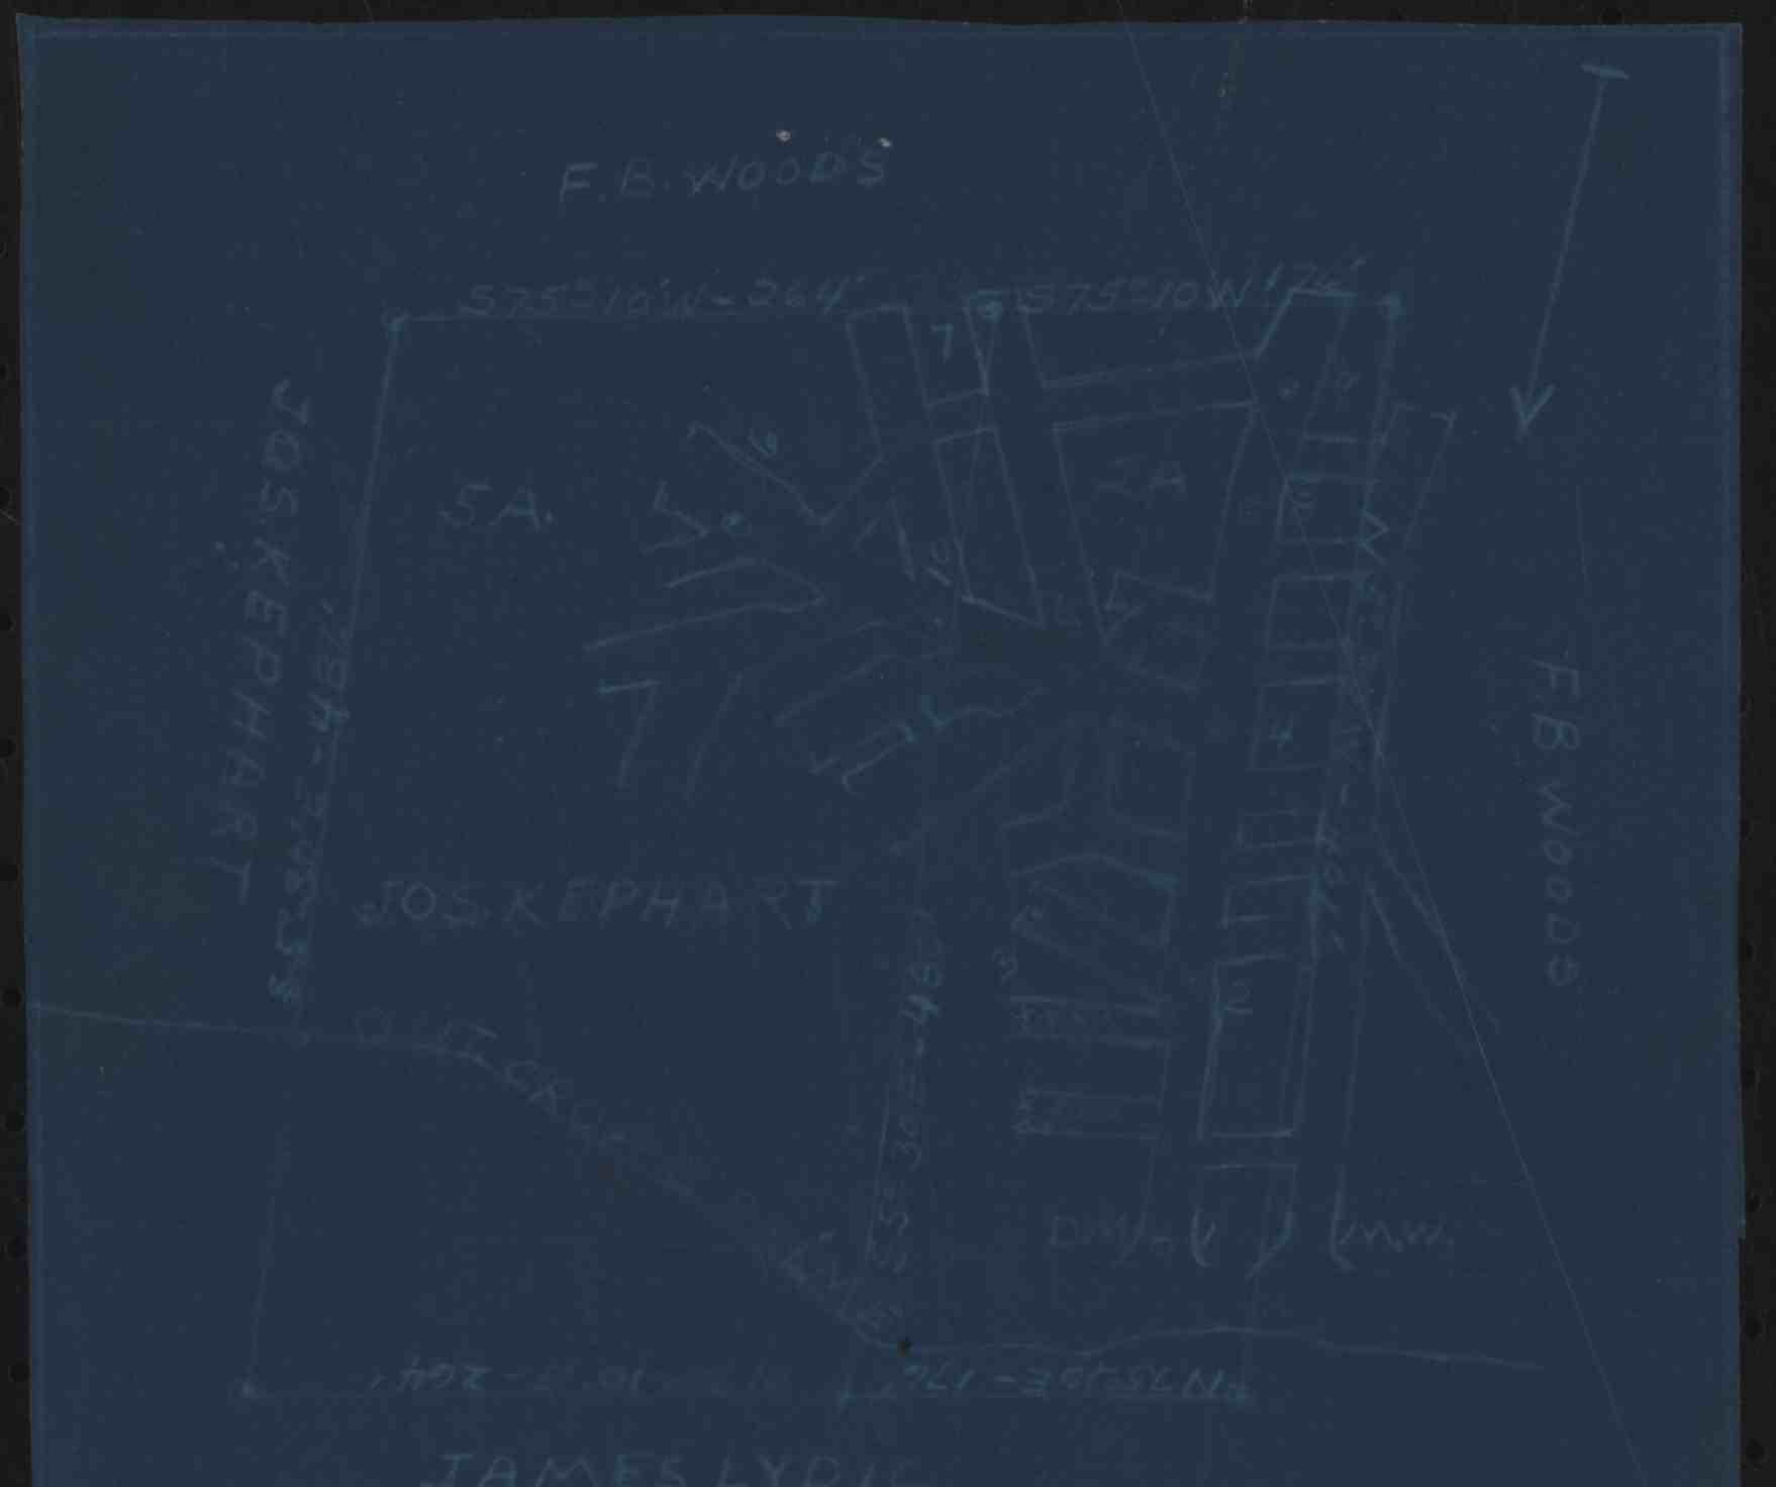

CAMEL COAL CO.
SUSQUEHANNA TWP.
CAMBRIA CO. PA
"PRINCE SEAM"
SCALE 1"=100'