J. McCullough

S 42°22
E 37.62.5

Elizabeth Christy

N 4°20.E
660.0

S 37°30.E
330.0

Todd R. & Eleanor F. Christy
Cont. Approx. 66 Acs

Hilltop
Mine worked out
Finished

Main Cleavage

Est. Mouth

Fall

Fall

Fall

Cut crop line

Jamison & Schaeffer

N 82°00.E
401.5'

J. A. Clawson

N 21°.E
537.5'

N 33°.00.W
337.25

S 28°.15'W
453.75'

N 49°15'W
2165.3

Heirs of J.J. McNight

Fetterman Coal Co. Indiana, Pa
Coal lease & workings
South Bend Twp. Armstrong Co.
Upper Freeport Vein
Map by J.A. Clawson Co. 2183-E
Jan. 1951 Scale 1" = 100'

DIST #2

Location Map

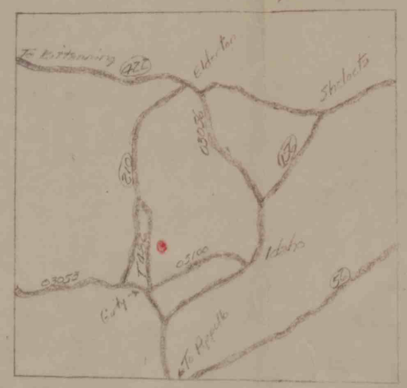

Super Creek Trib. of Crooked Creek "Approx. location"