
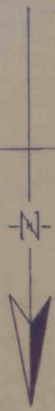


MINE MAP
J.K. SHERRY ²
COAL MINE ^{dist. 2}

Rcdbank Township, Armstrong County, Pa.
Scale 1" = 100' October 18, 1957
Walter J. Zimmerman Surveyor Engineer
Punxsutawney, Pa.

Sherry & Yarger Coal Co.
S & Y
1956 Annual District 2

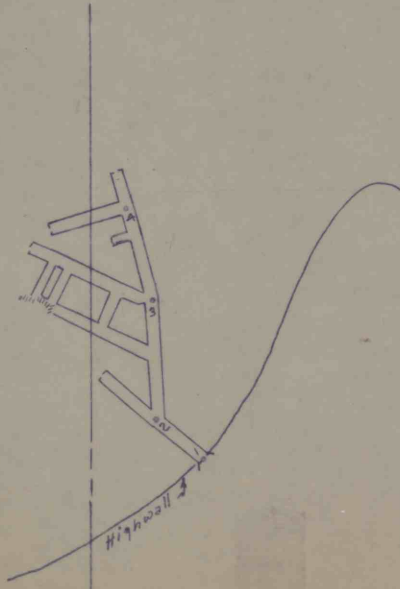

Geo. Ellenberger

Lameier Yarger

