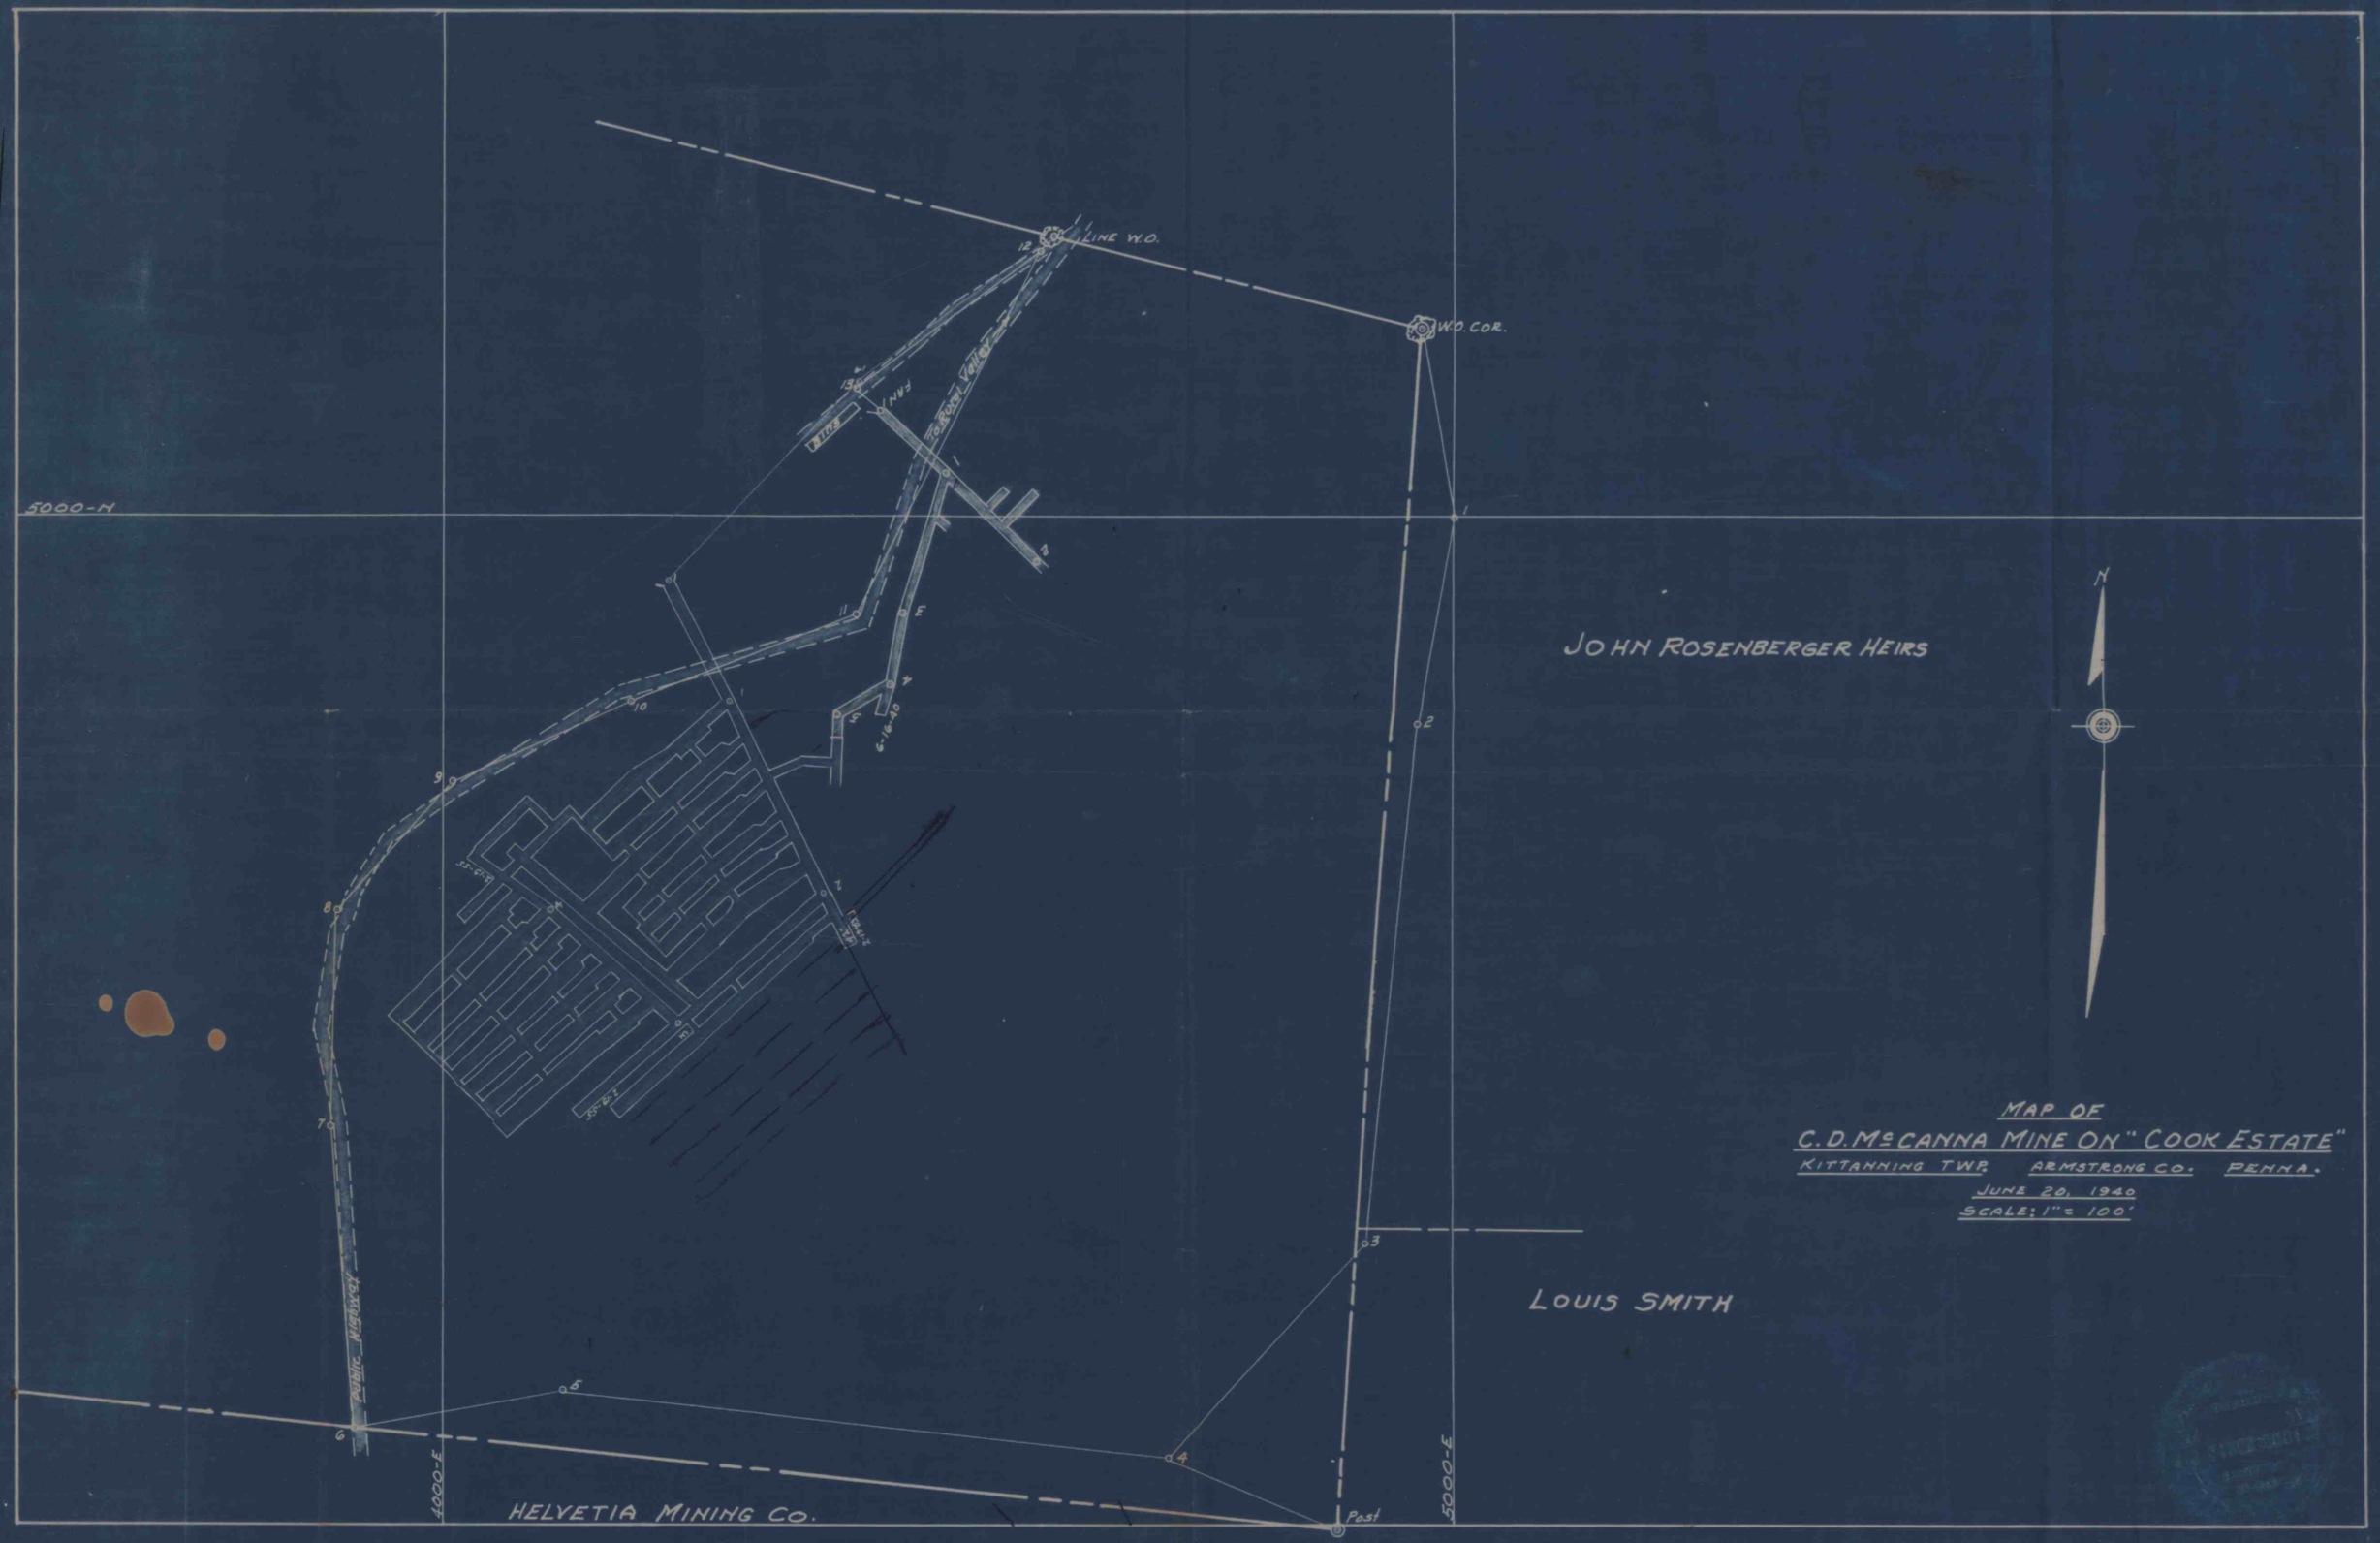

LINE W.O.
W.O. COR.
5000-N
JOHN ROSENBERGER HEIRS
N
MAP OF
C.D. McCANNA MINE ON "COOK ESTATE"
KITTANNING TWP. ARMSTRONG CO. PENNA.
JUNE 20, 1940
SCALE: 1" = 100'
LOUIS SMITH
Public Highway
4000-E
5000-E
HELVETIA MINING CO.
Post