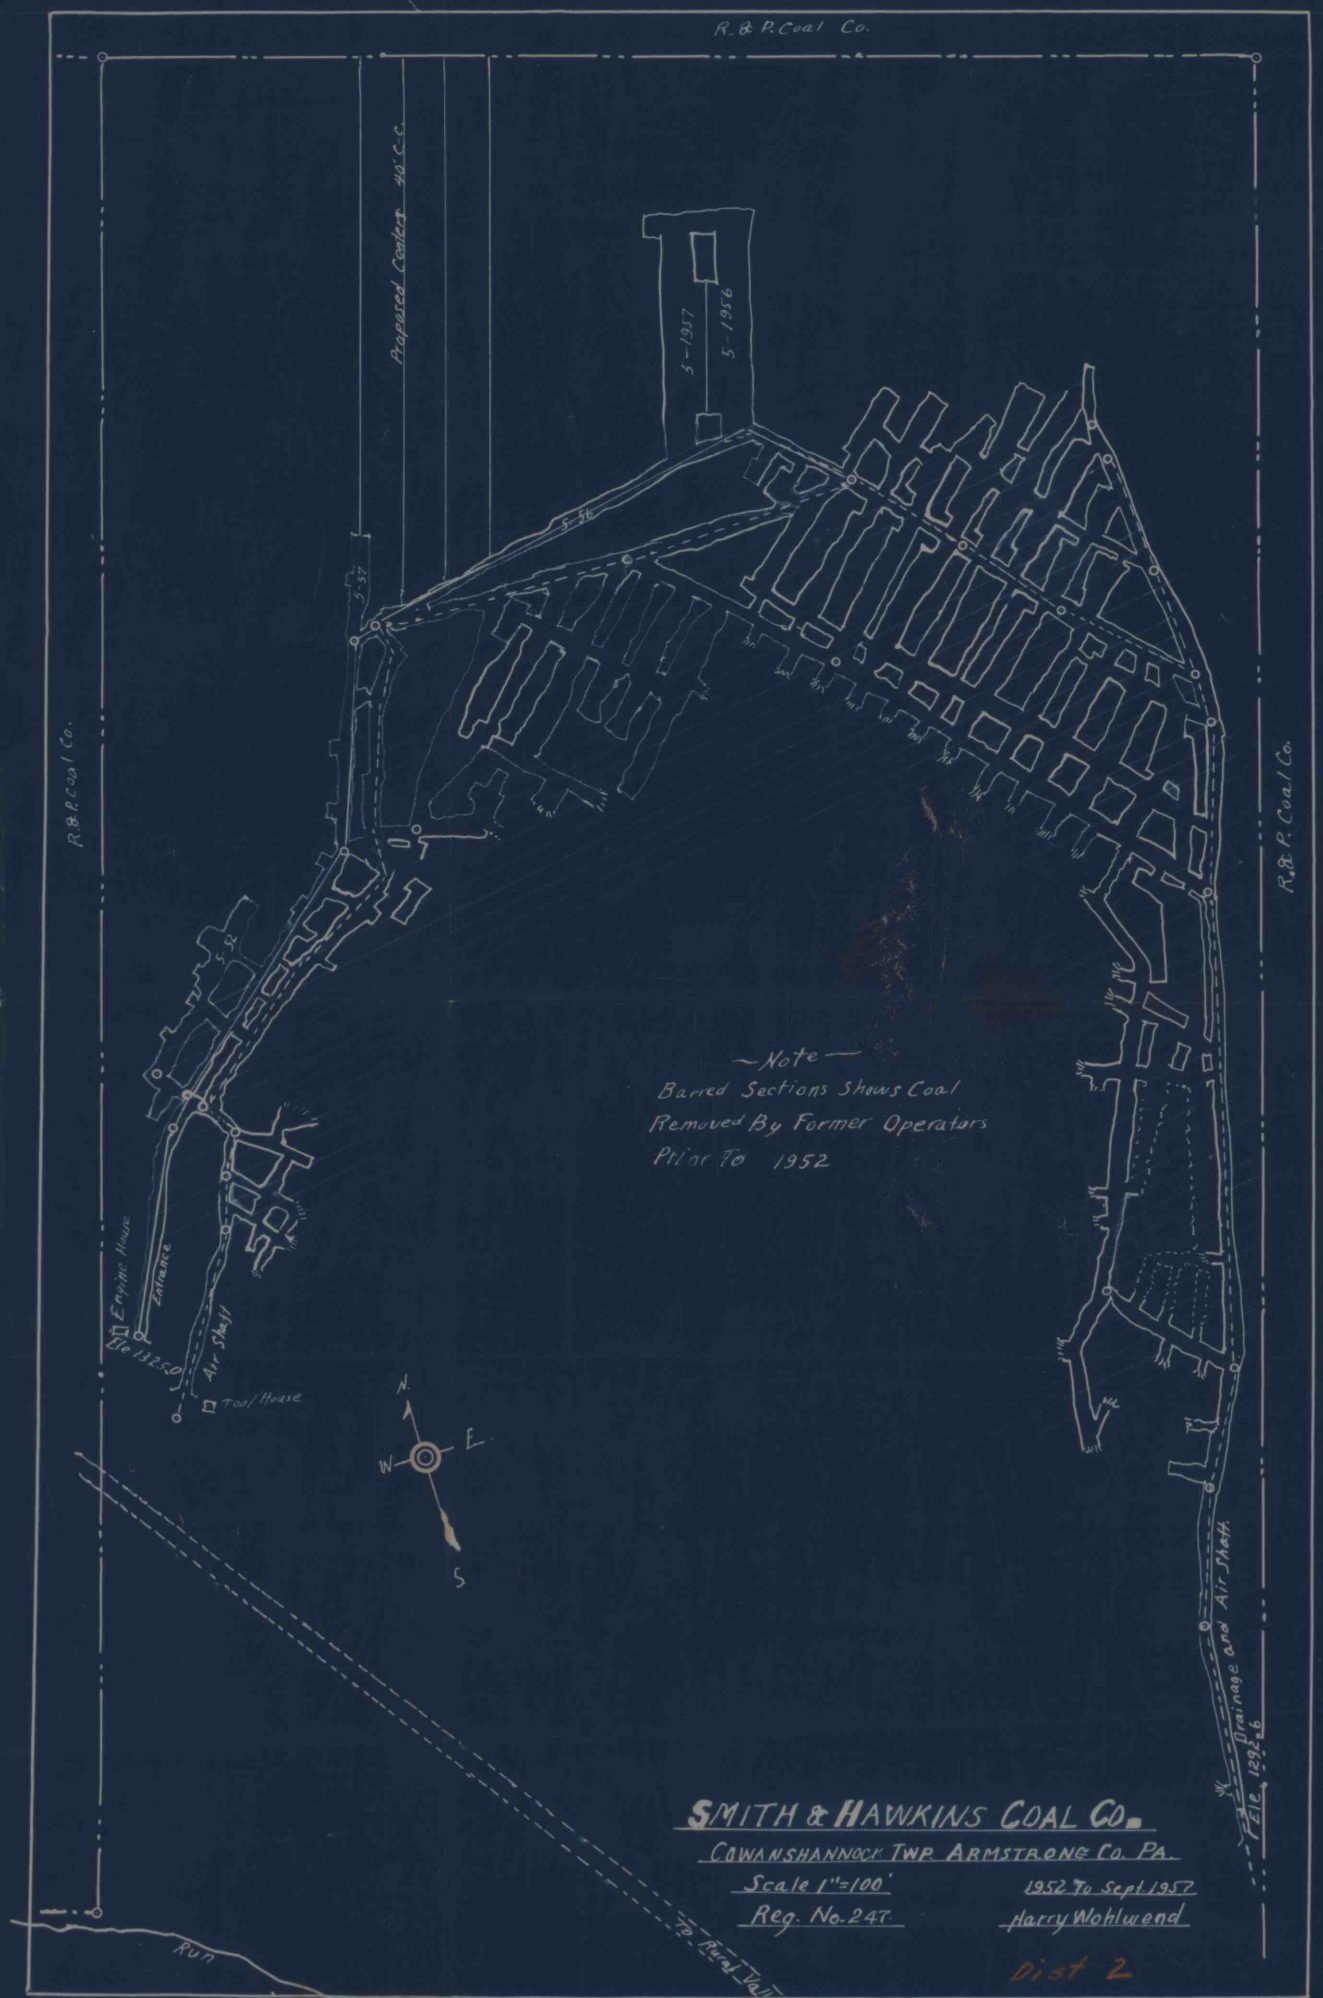
R. & P. Coal Co.
Proposed Center 40 C.C.
5-1957
5-1956
5-56
5-57
5-52
R. & P. Coal Co.
R. & P. Coal Co.
Note
Barred Sections Shows Coal
Removed By Former Operators
Prior To 1952
Engine House
Entrance
Air Shaft
Elv 1325.0
Tool House
N
E
W
S
Drainage and Air Shaft
Elv 1292.6
To Road Valley
Run
R. & P. Coal Co.
SMITH & HAWKINS COAL CO.
COWANSHANNOCK TWP. ARMSTRONG CO. PA.
Scale 1"=100'
Reg. No. 247
1952 To Sept. 1957
Harry Wohlwend
Dist 2