


DOVERSPIKE

H. T. COOK
ESTATE

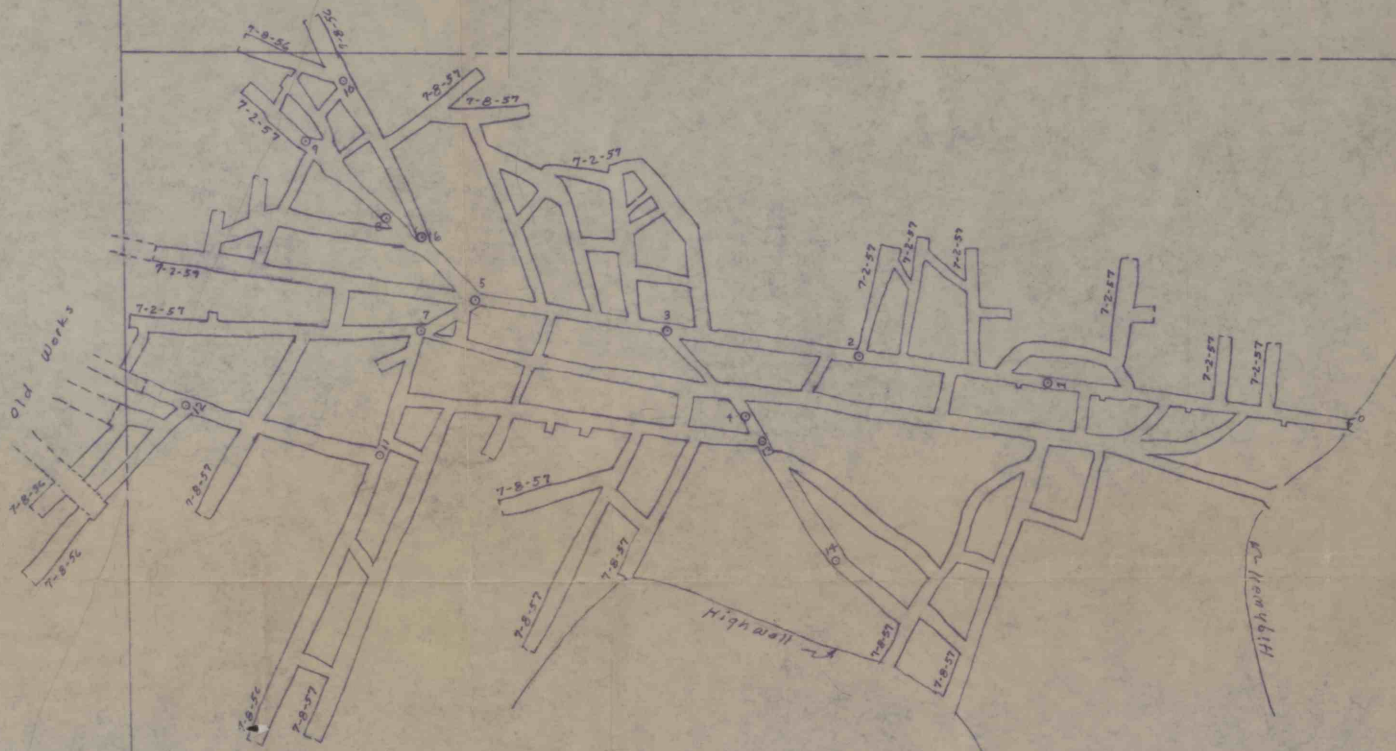

KEMERER

Smith Coal Co.
 Smith #3
 1956 Annual District 2



MINE MAP
 SMITH COAL CO.
 MINE NO. 4

Redbank Township, Armstrong County, Pa.
 Scale 1"=100' July 8, 1957
 Walter J. Zimmerman Surveyor Engineer Punxsutawney, Pa.

