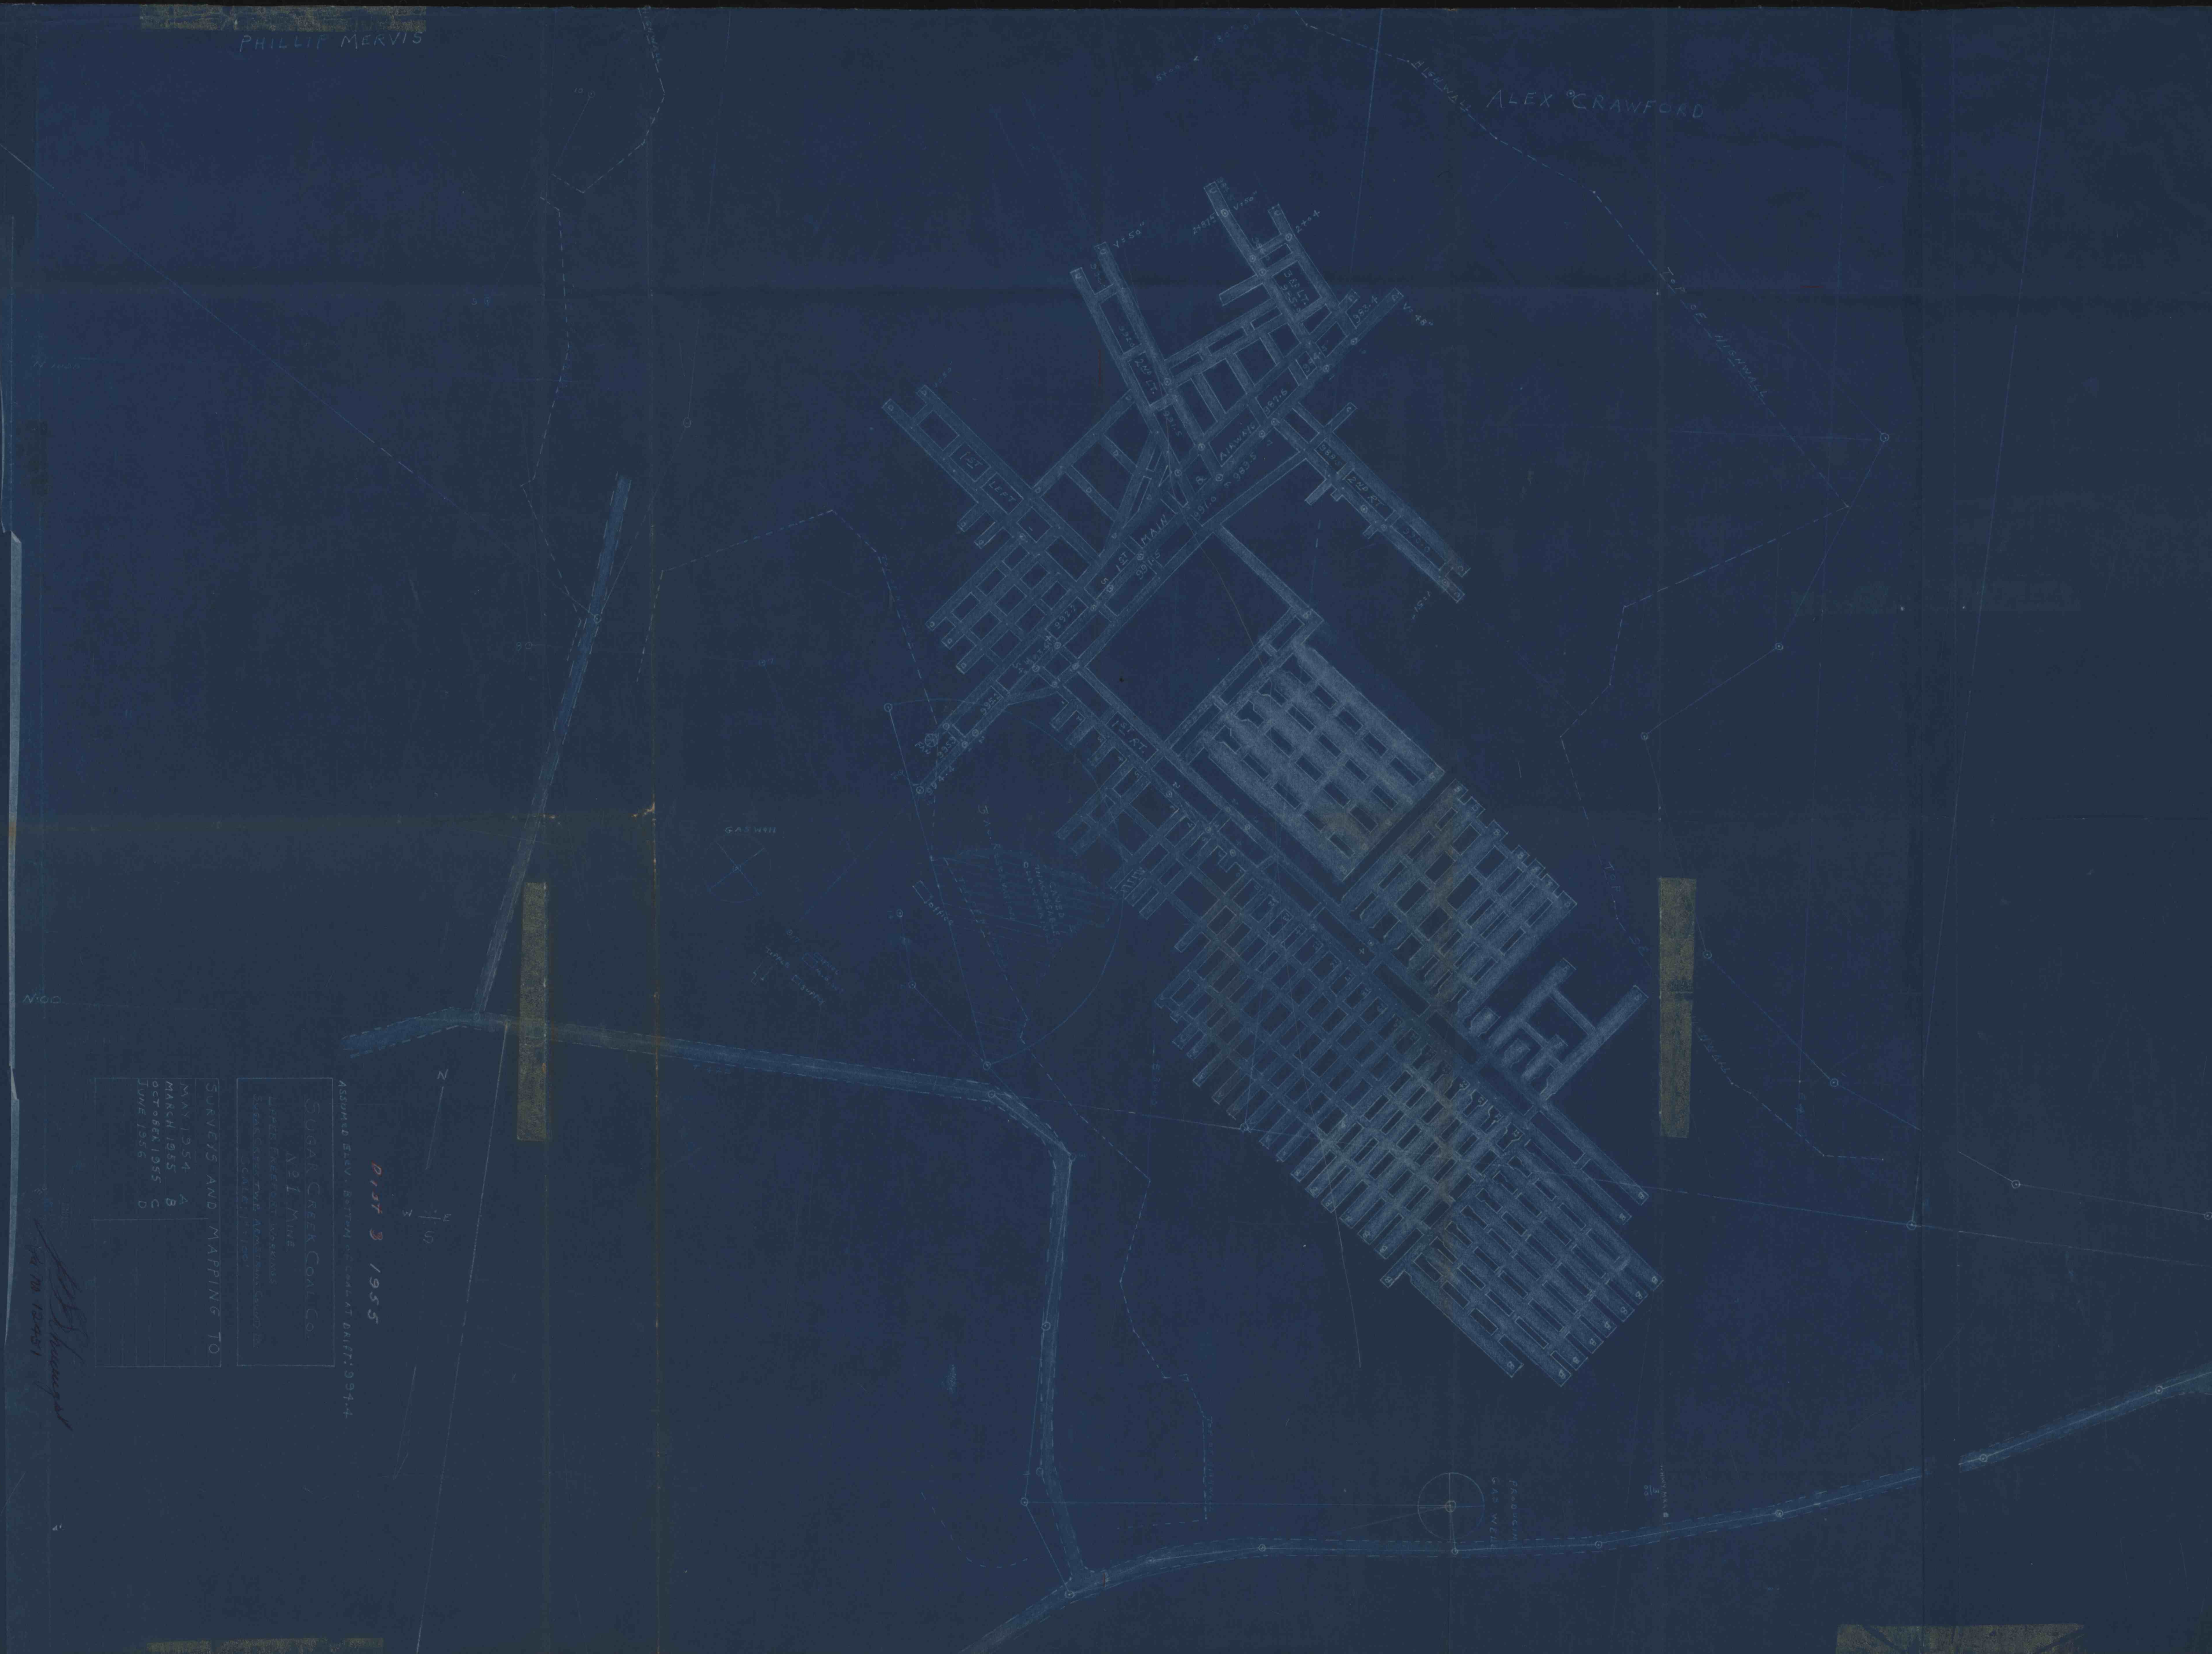

PHILLIP MERVIS
ALEX CRAWFORD
HIGHWALL
TOP OF HIGHWALL
1ST LEFT
2ND LT.
3RD LT.
1ST MAIN
AIRWAY
2ND RT.
1ST RT.
V=50"
V=48"
GAS WELL
CAVED
INACCESSABLE
OLD WORKINGS
OFFICE
SUPPLY
TIPPLE
PRODUCING GAS WELL
N 1000
N 00
N
S
E
W
SURVEYS AND MAPPING TO
MAY 1954 A
MARCH 1955 B
OCTOBER 1955 C
JUNE 1956 D
SUGAR CREEK COAL CO.
No 1 MINE
UPPER FREEPORT WORKINGS
ASSUMED ELEV. BOTTOM OF COAL AT DRIFT: 994.4
DIST 3 1955