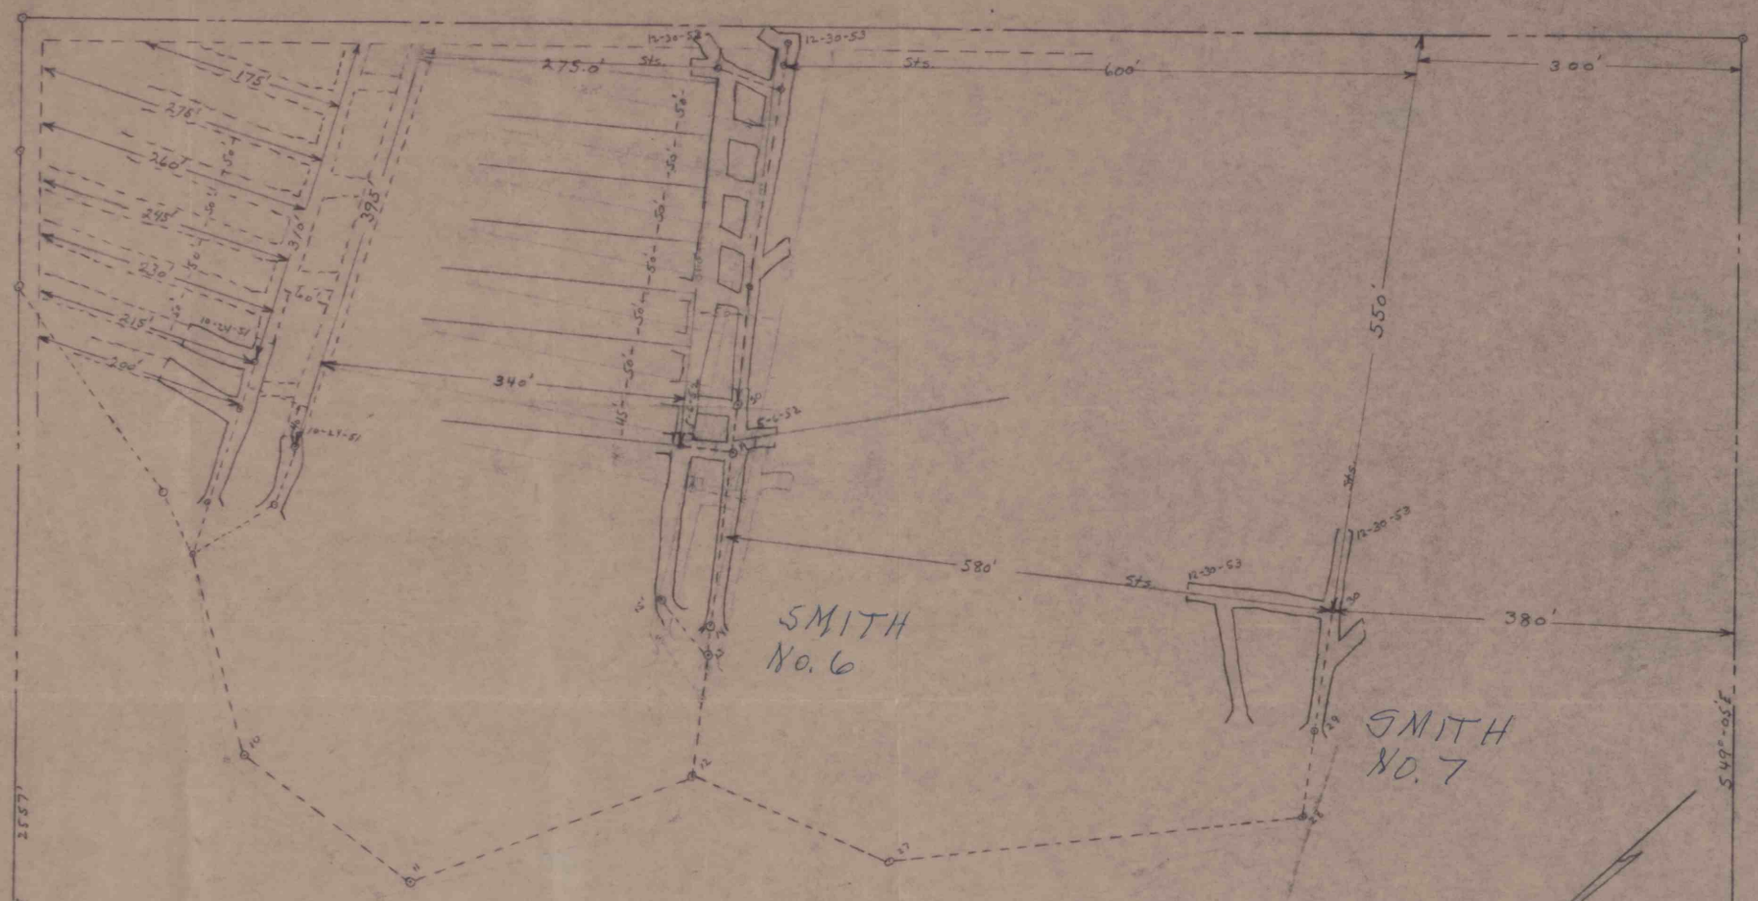

MINES AND PROPERTY OF

GEORGE F. SMITH

SITUATE PLUMCREEK TWP. ARMSTRONG CO. Dist 2

SCALE 1"=100' OCT. 24, 1951

PAUL L. BOTSFORD REG. PRO. ENGR.

Smith Coal Co., George
Smith #6
Smith #7
Armstrong Co. District 2
1956 Annual