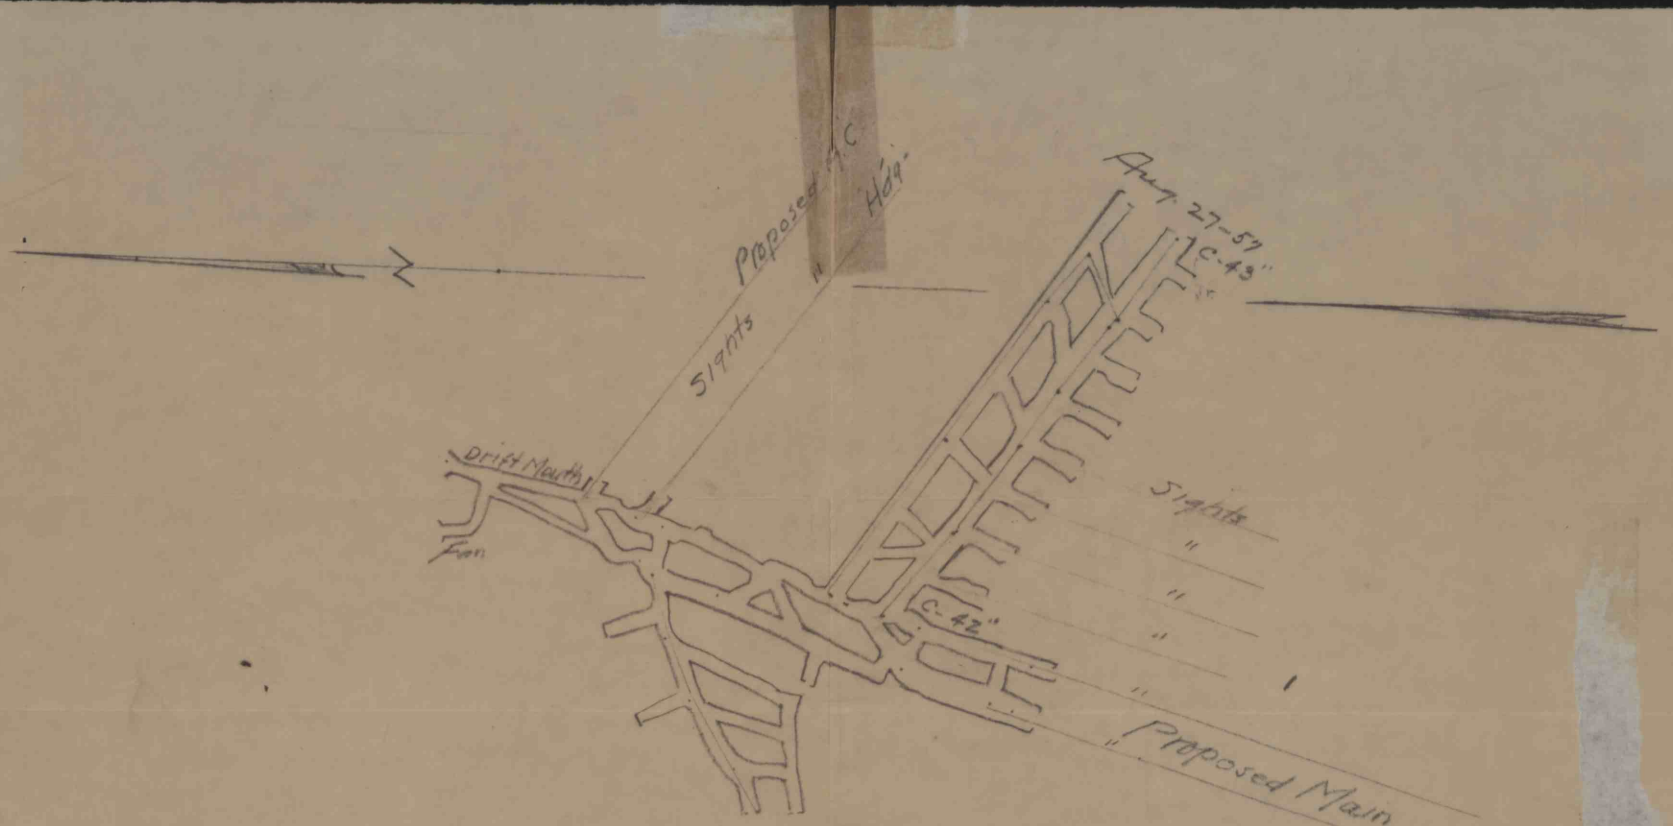

Map Showing Property of Louis Ducca.

Situate Armstrong Co., Pa.-Plumcreek Twp.

Scale-1"=100'

Aug. 27-1957

(From Surveys-prints and office records)

P.B. Jones. Reg." 1691

Ducca Coal Co.
Ducca
1956 Annual
District 2