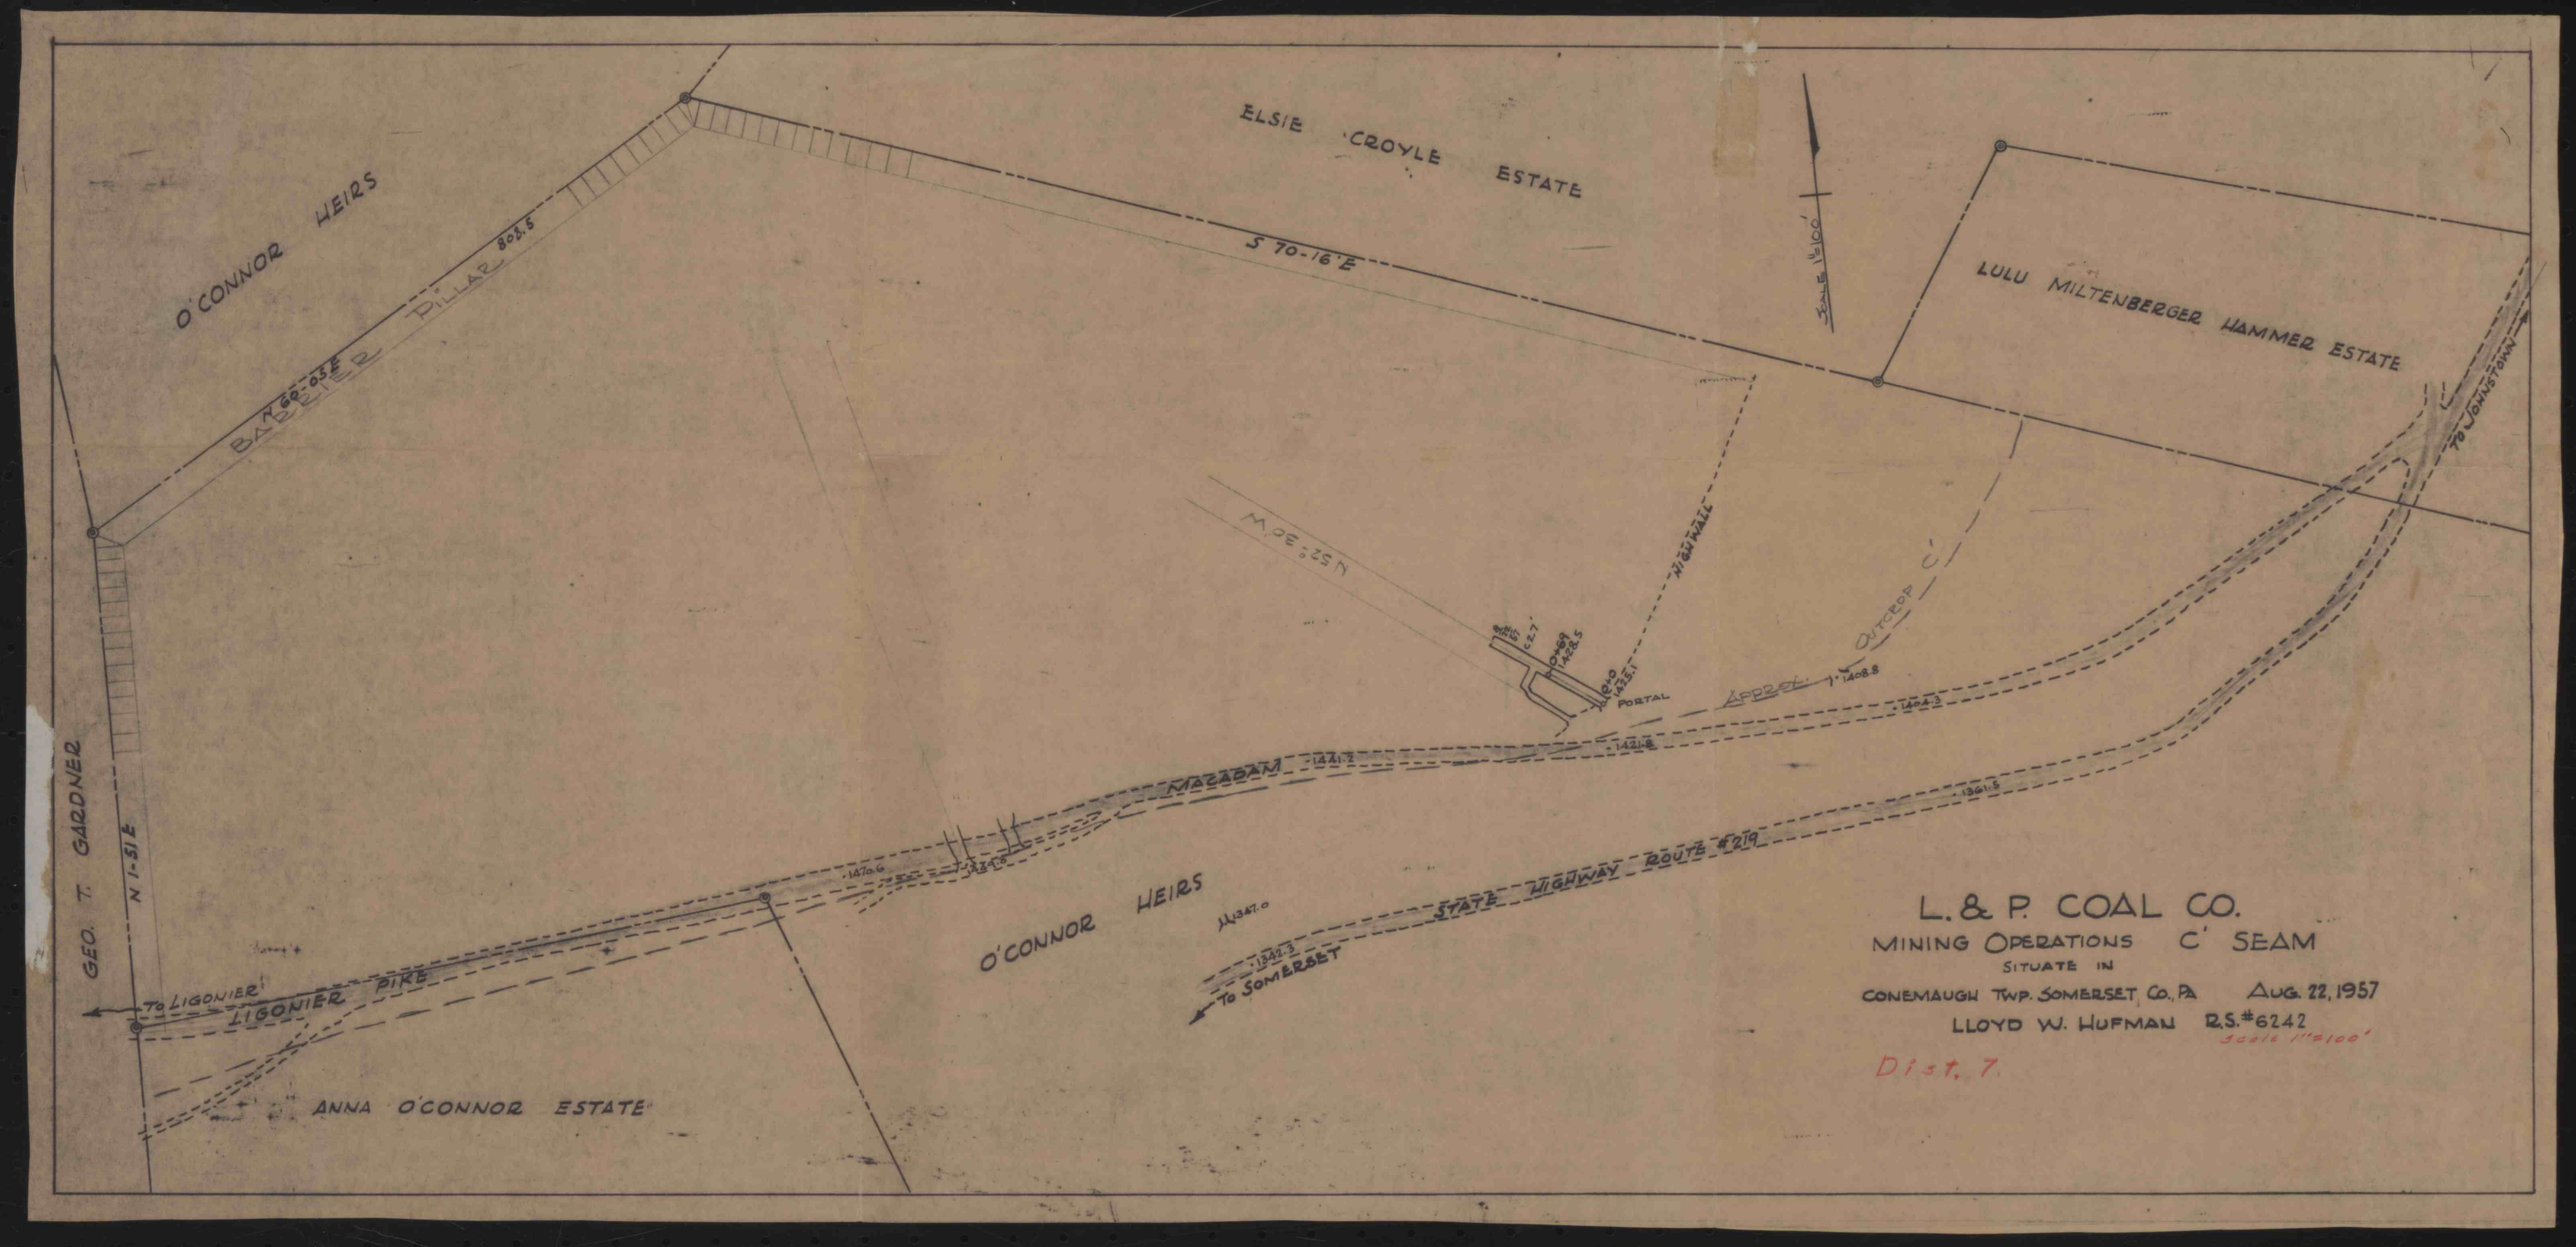

L. & P. COAL CO.

MINING OPERATIONS C' SEAM

SITUATE IN

CONEMAUGH TWP. SOMERSET CO. PA AUG. 22, 1957

LLOYD W. HUFMAN R.S.#6242 Scale 1"=100'

Dist. 7.