

MEYERSDALE COAL CO.

MAP OF

WELLS CREEK MINE,

AT

WELLS CREEK, SOMERSET CO. PA.

Scale one inch = 100 FT.

LISTED PA. FEBRUARY 12, 1908, *James H. McLaughlin* Coal. Exec.

Original survey by *William Stephenson*

May 1904 Survey by *C. P. Collins*


June 24, 1910

*Abandoned since 1917.*

*C. Prime seam.*

*See other print for boundary line.*

*N.B. All bearings unless otherwise stated subject to rock survey. The map is to be a true scale of the original.*

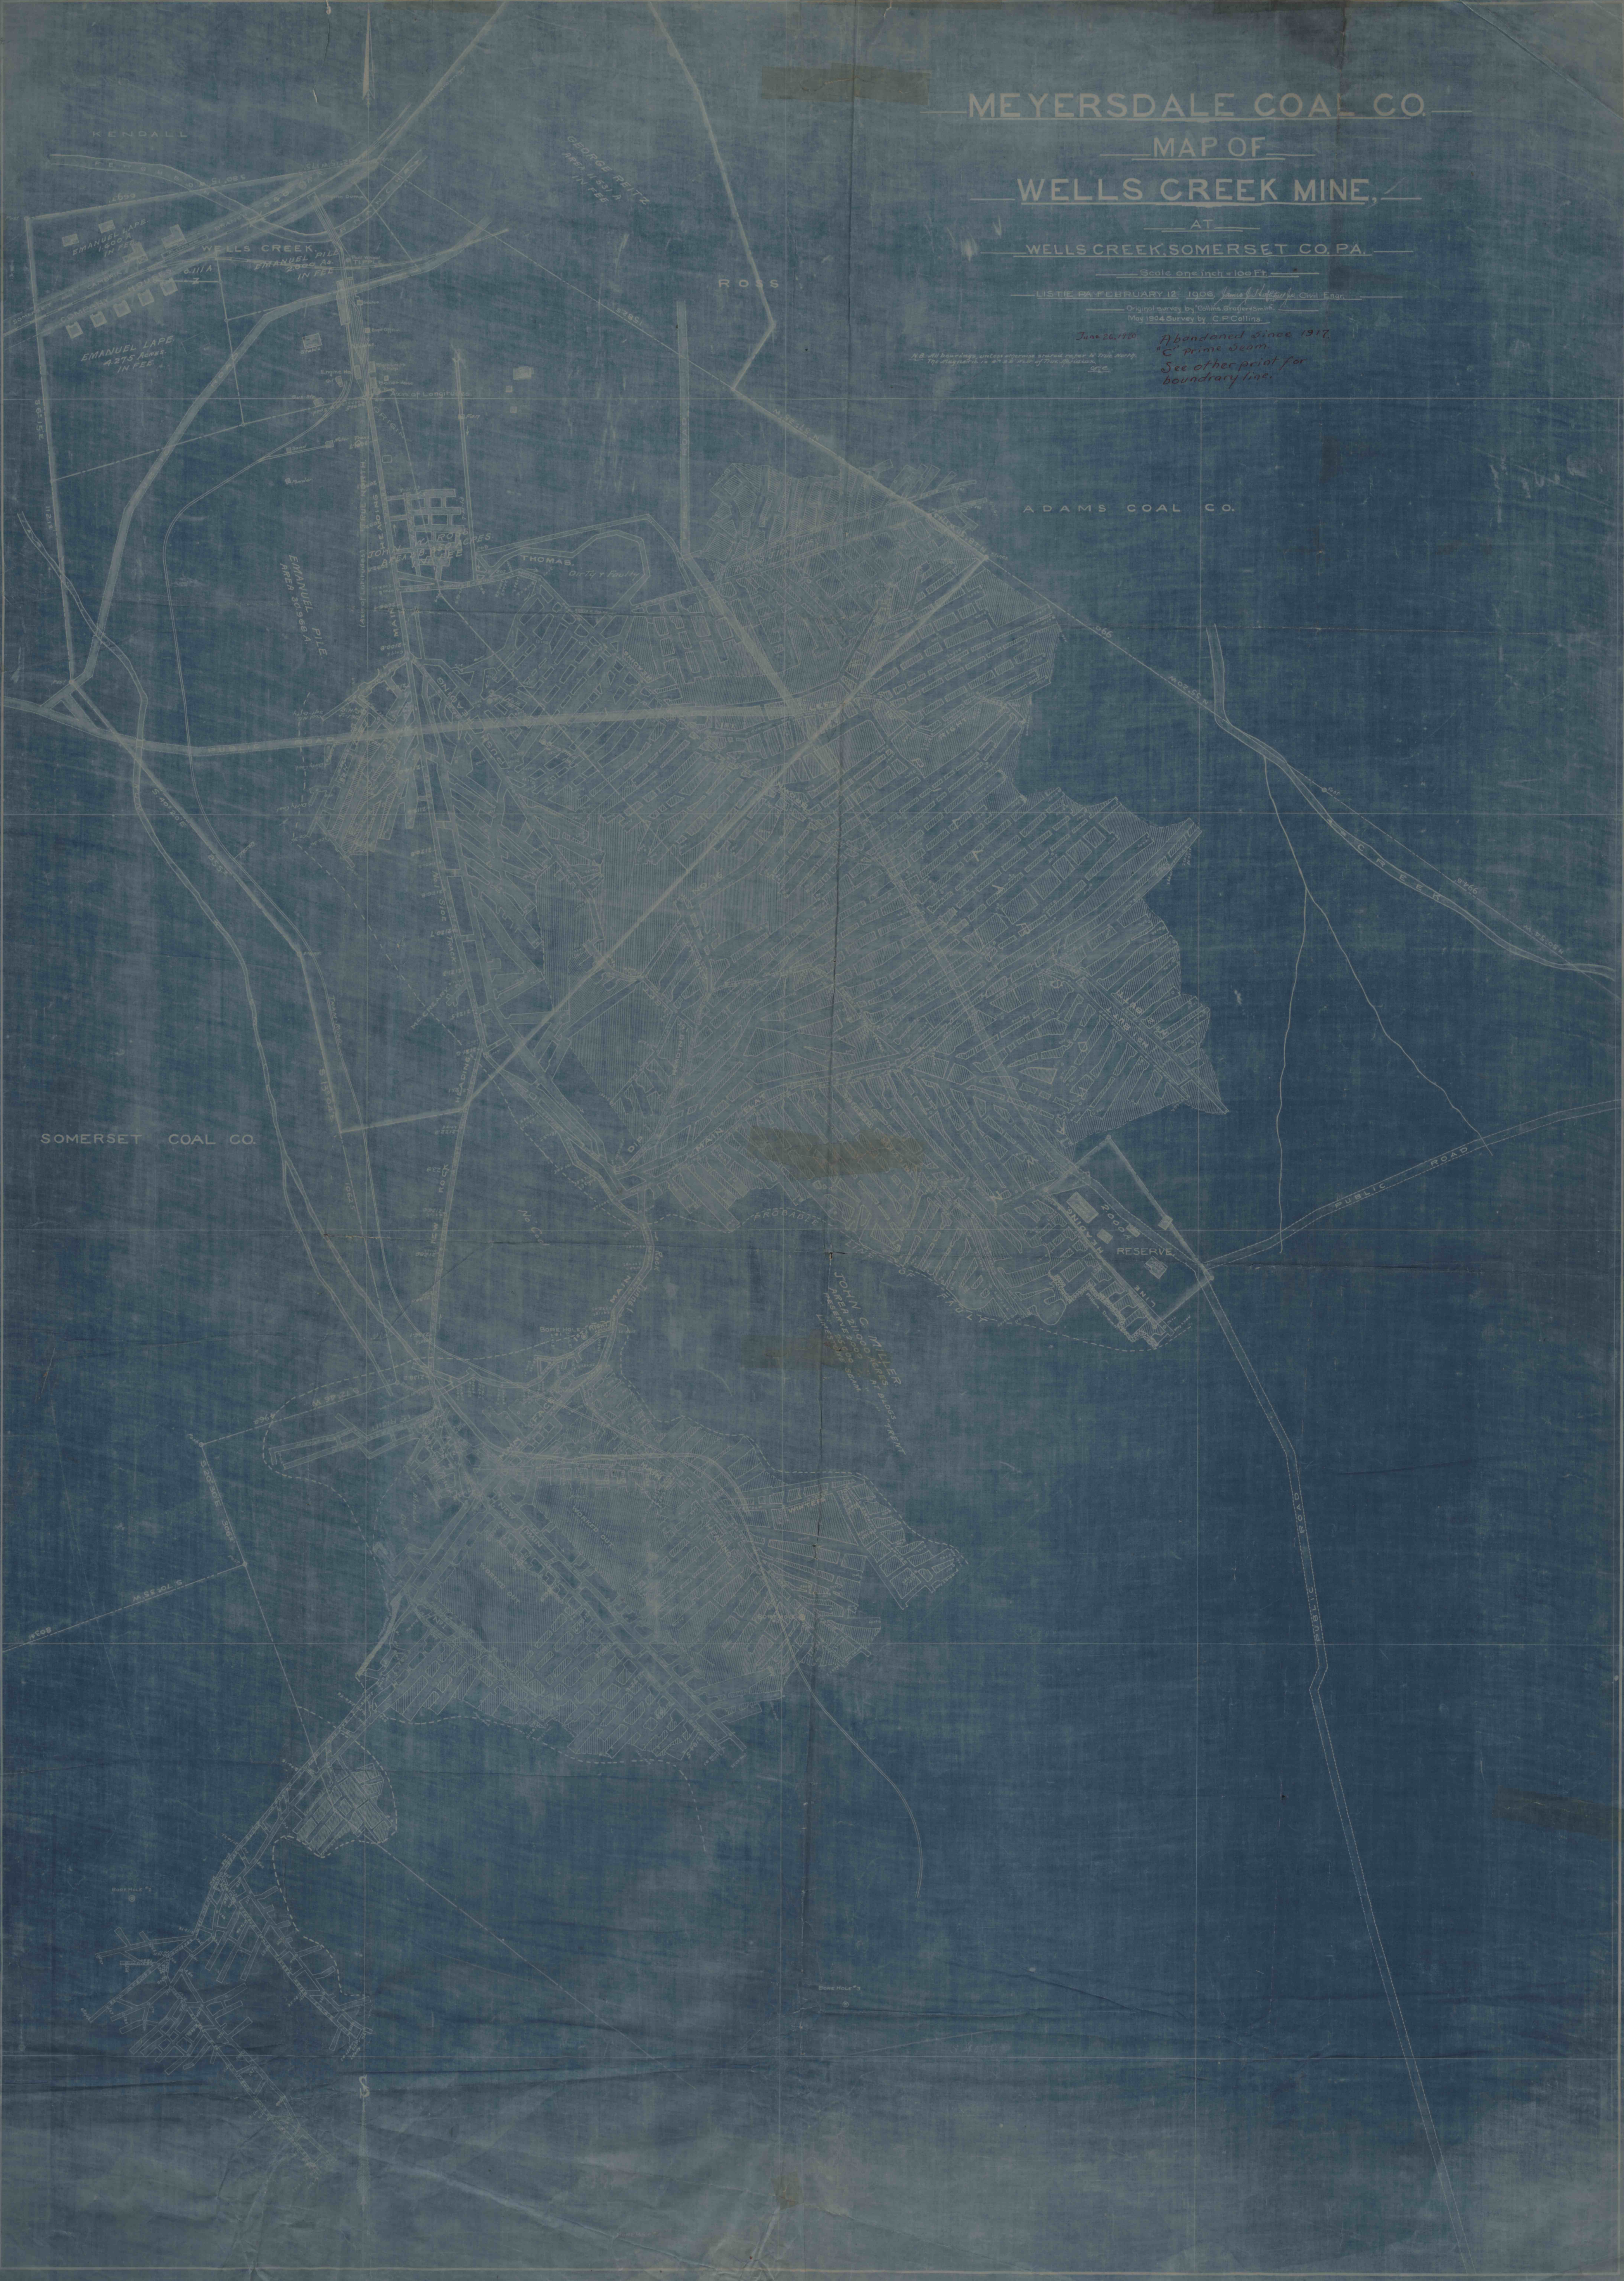

SOMERSET COAL CO.

ADAMS COAL CO.

ROSS

KENDALL