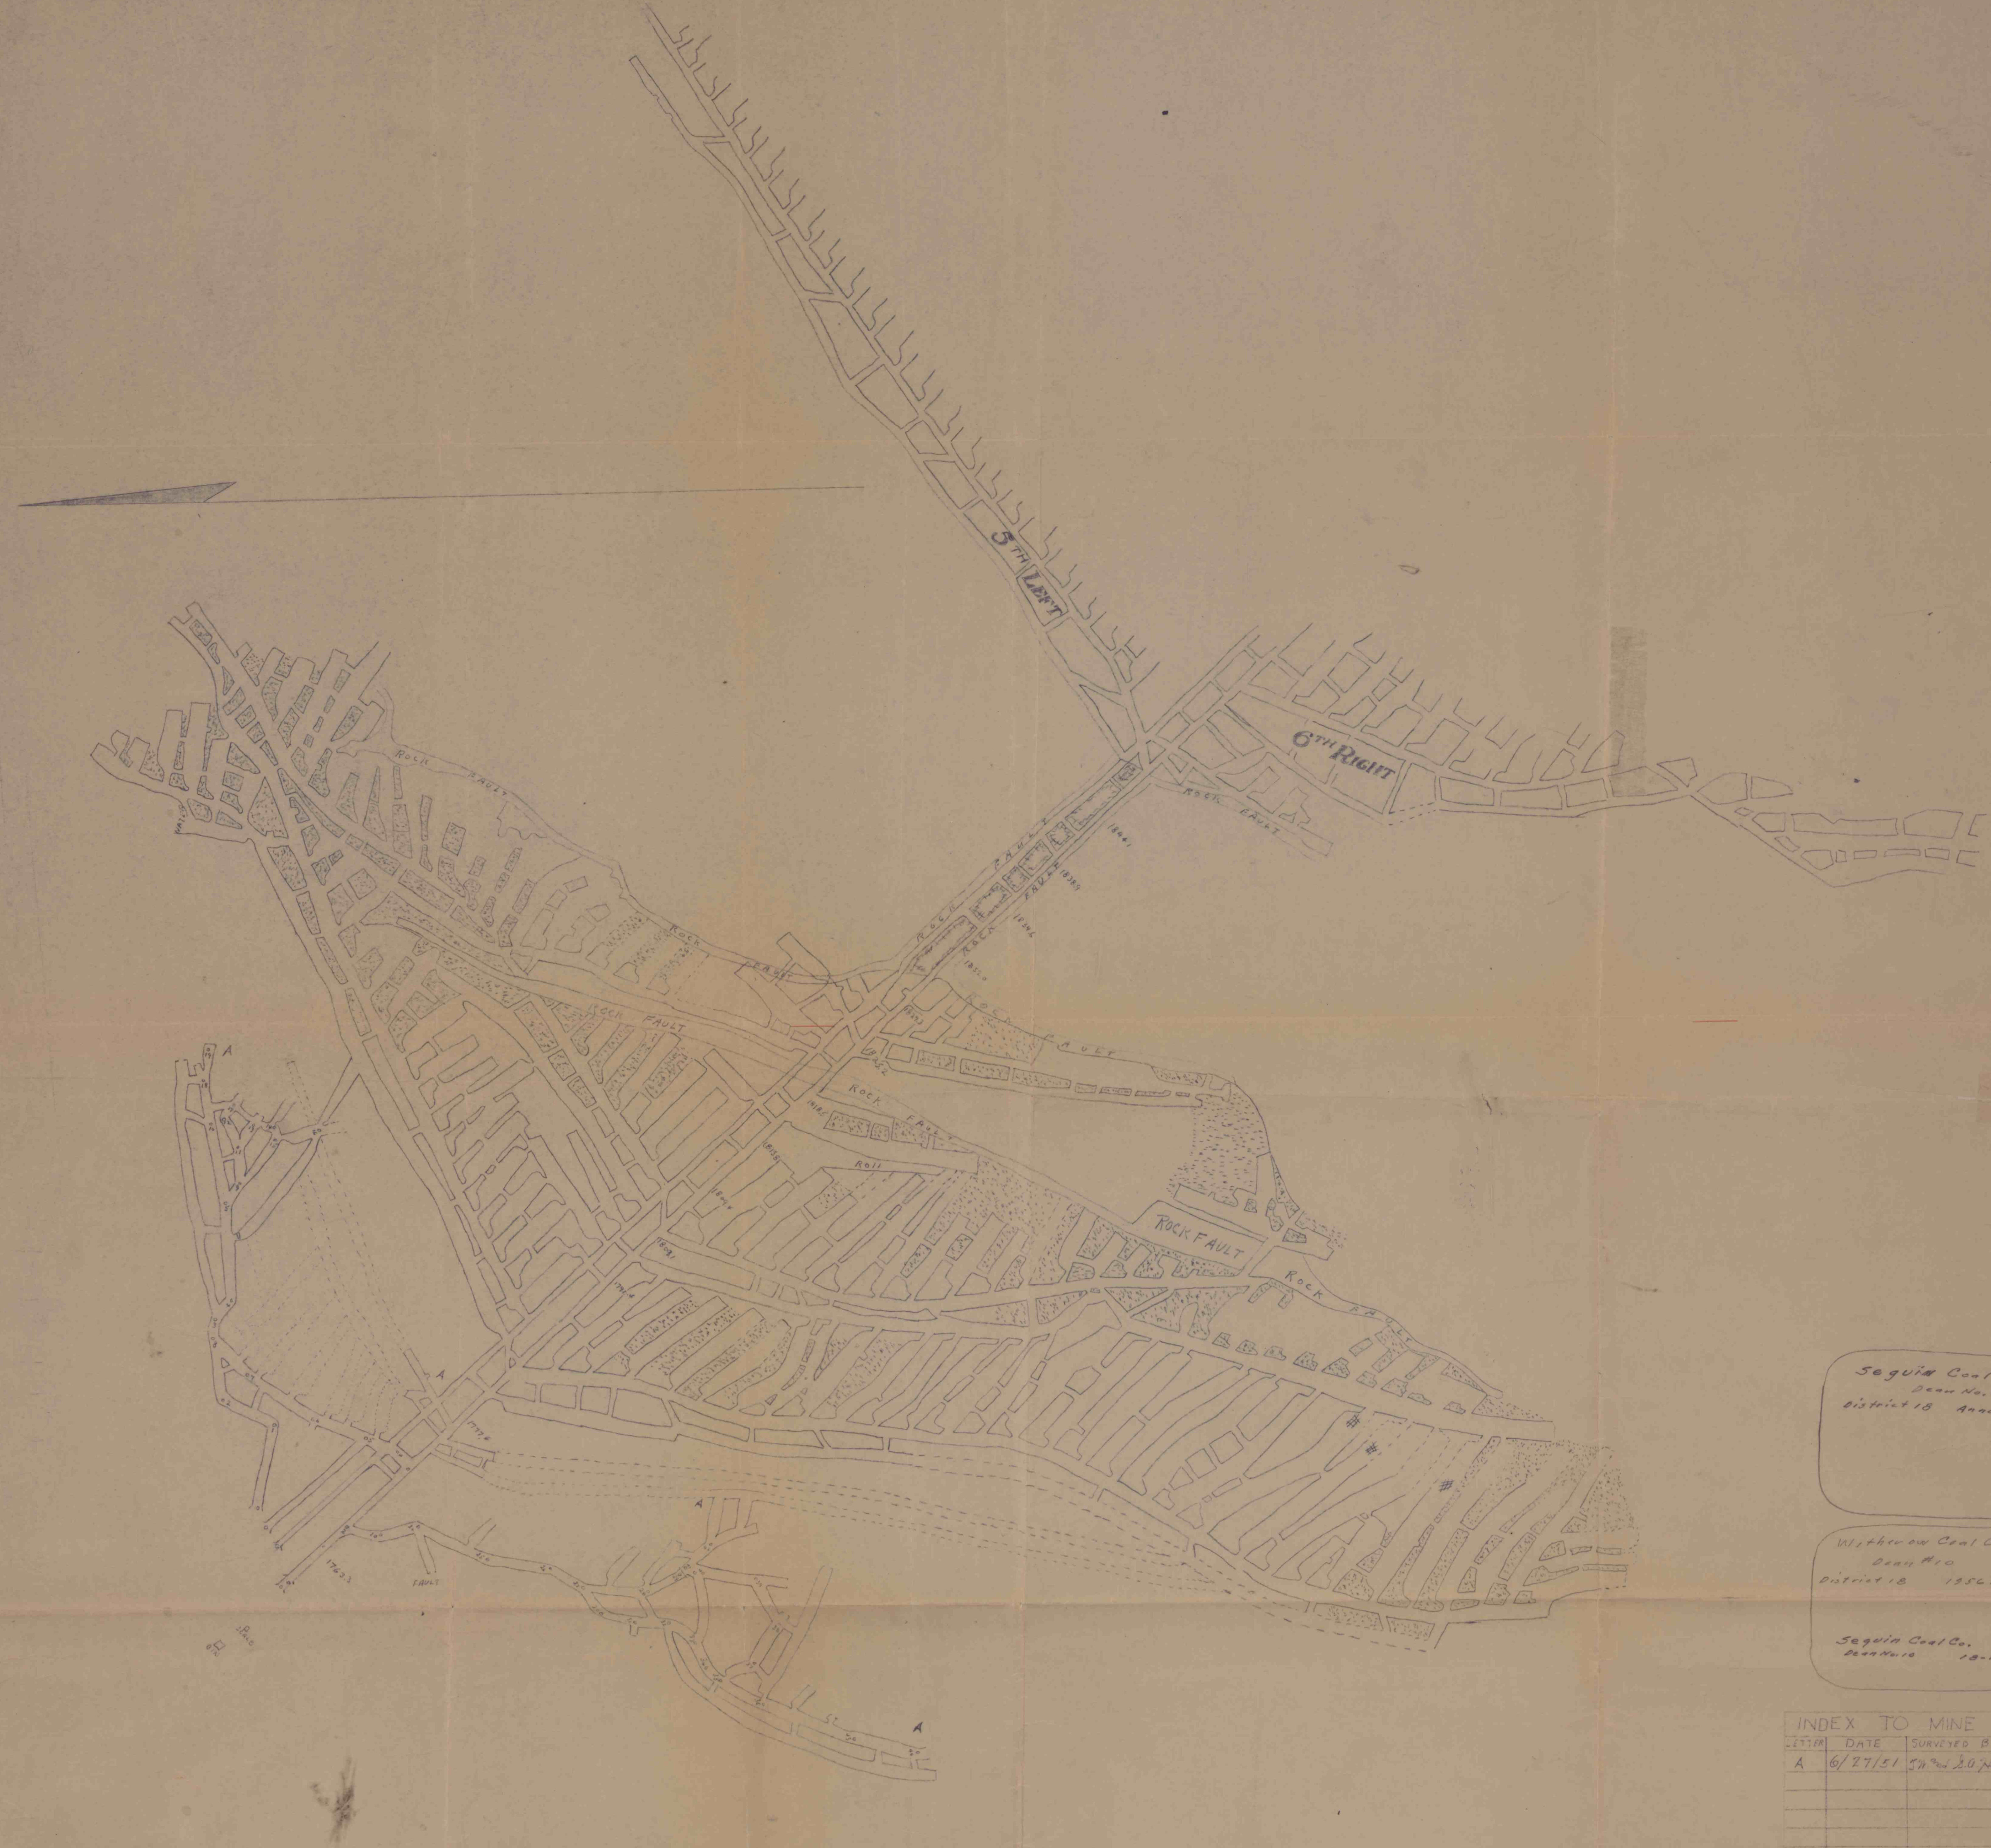

WITHEROW 10 MINE

Situated In dean township Cambria County

Scale 1" = 100'

Seguin Coal Co.
Dean No. 10
District 18 Annual 1959

Witherow Coal Co.
Dean #10
District 18 1956 Annual

Seguin Coal Co.
Dean No. 10 18-1961

INDEX TO MINE SURVEYS

LETTER	DATE	SURVEYED BY	PLATTED BY
A	6/27/51	J.W. and G.O. [illegible]	J.W. and G.O. [illegible]