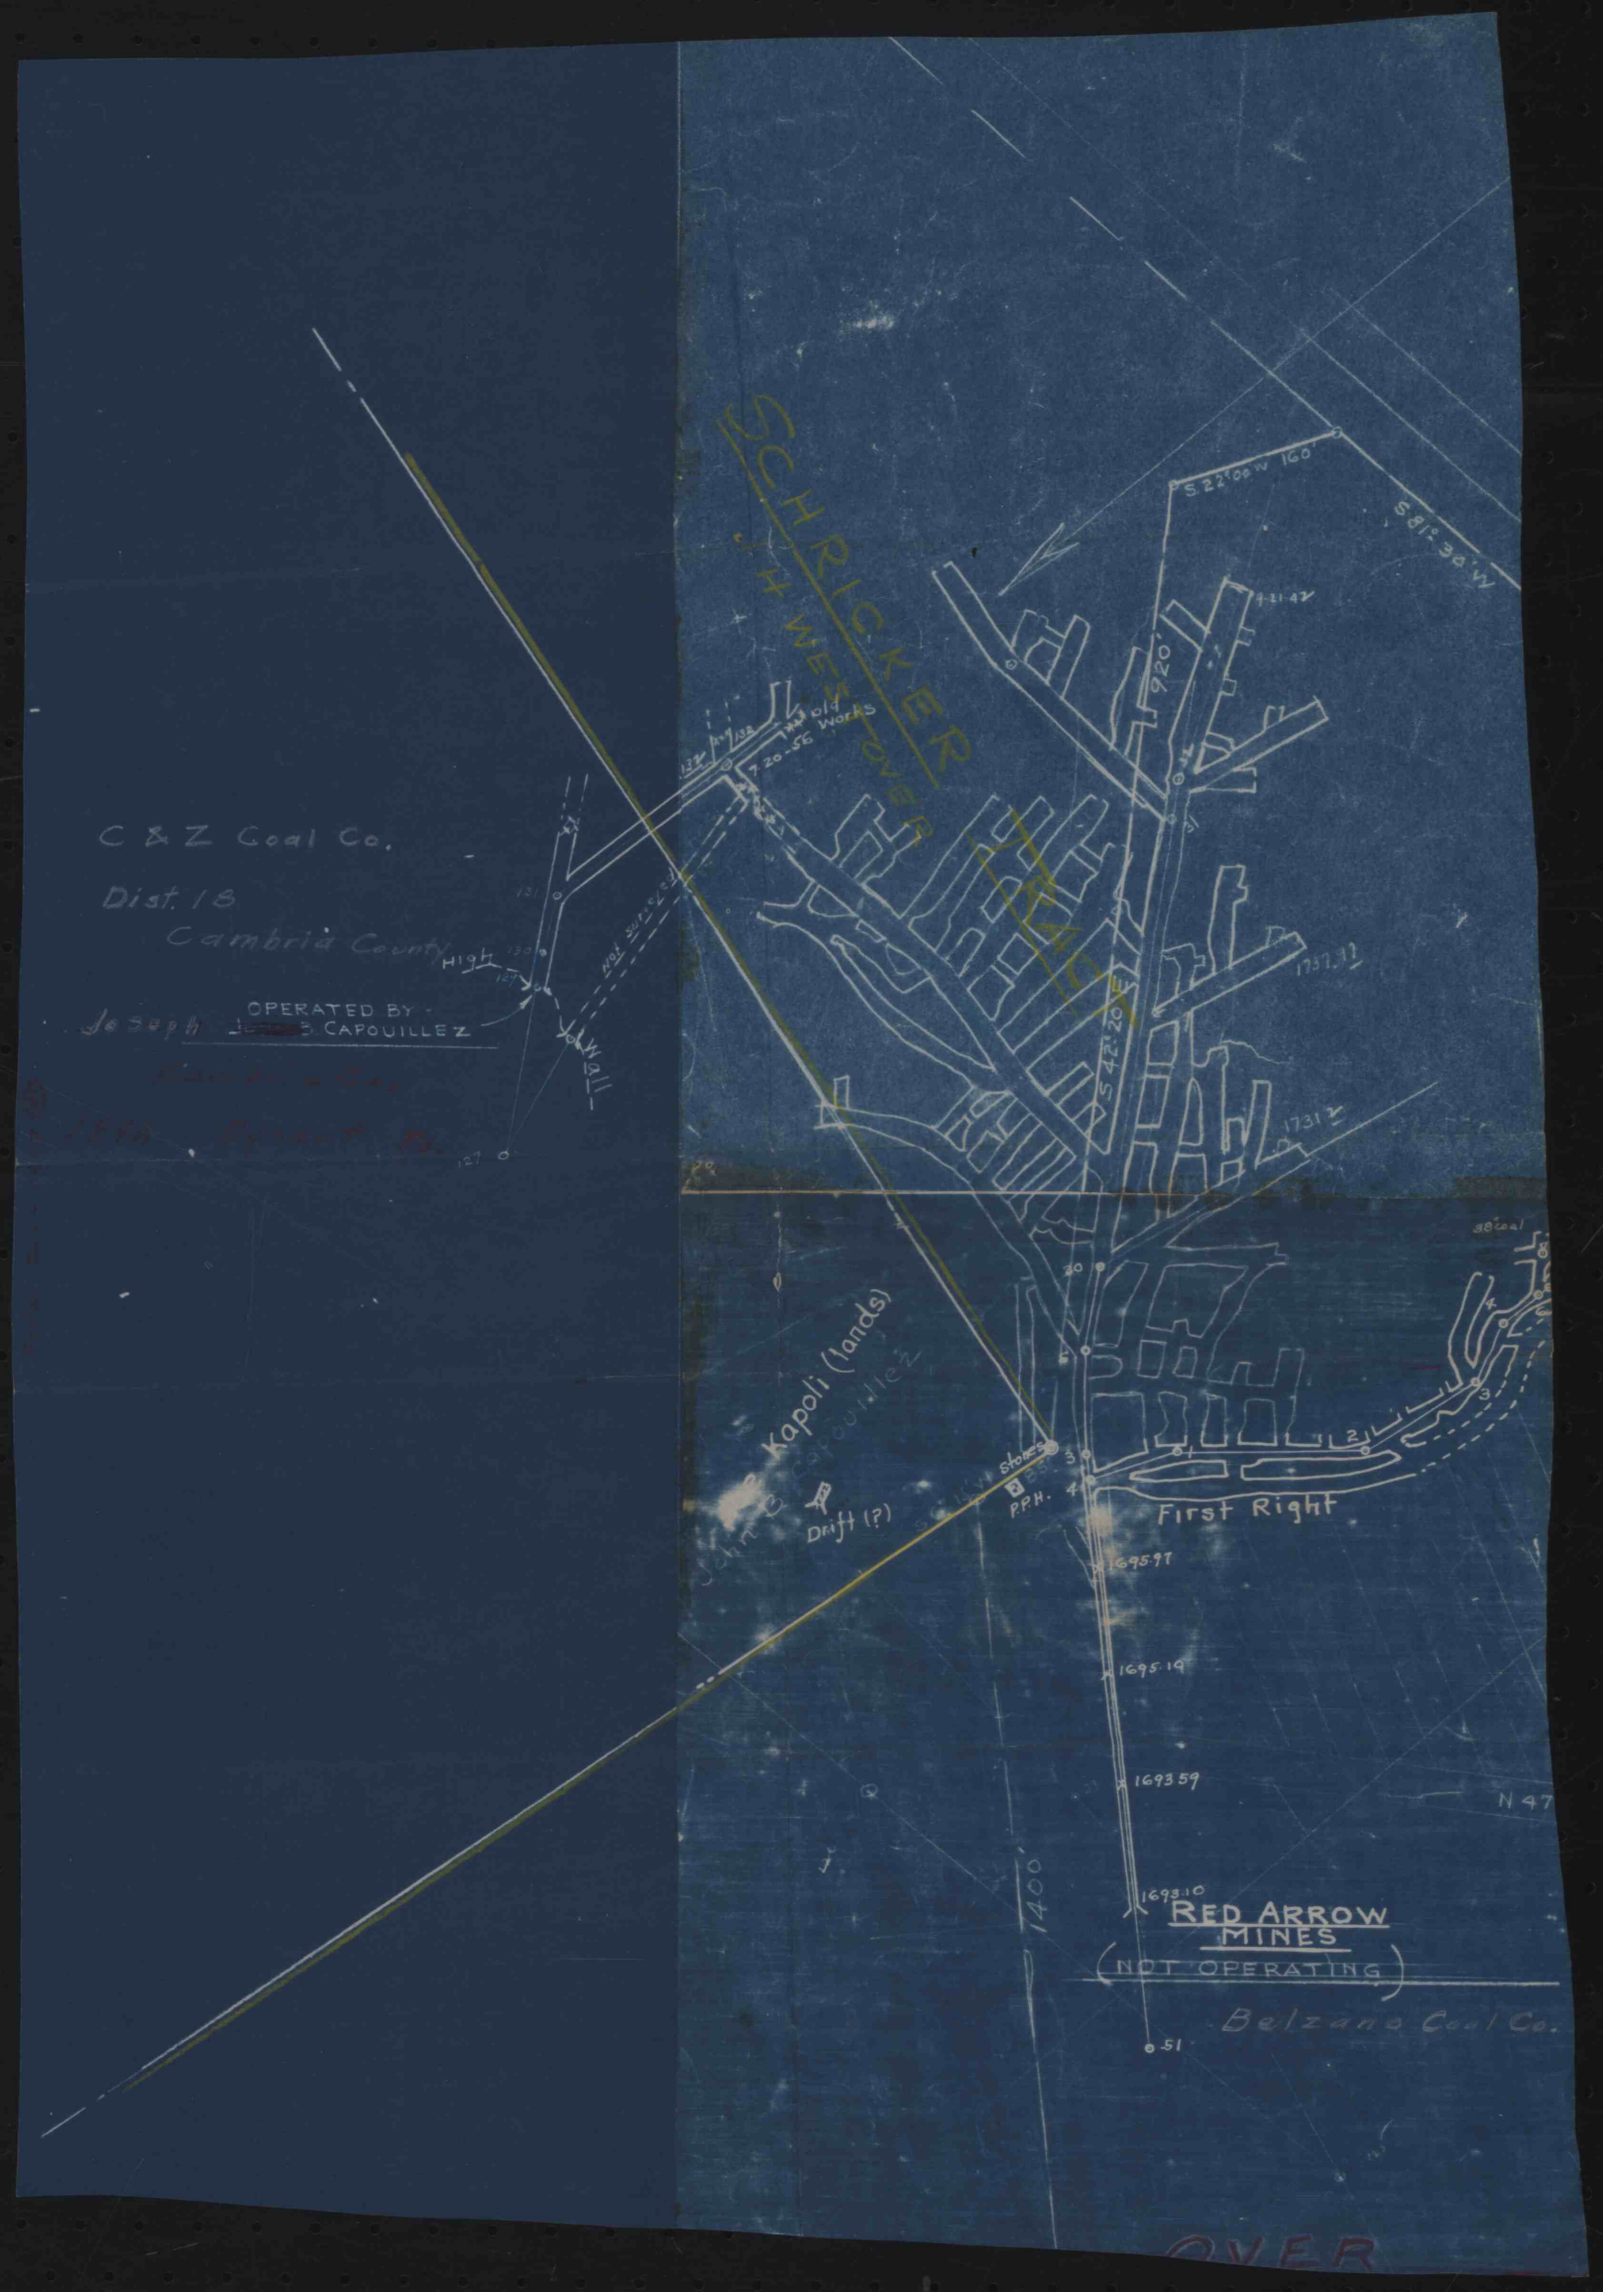
SCHRICKER
TRACT
C & Z Coal Co.
Dist. 18
Cambria County
OPERATED BY
CAPOUILLEZ
Kapoli (lands)
Drift (?)
First Right
RED ARROW
MINES
(NOT OPERATING)
Belzano Coal Co.
OVER