


Scale 1" = 100'

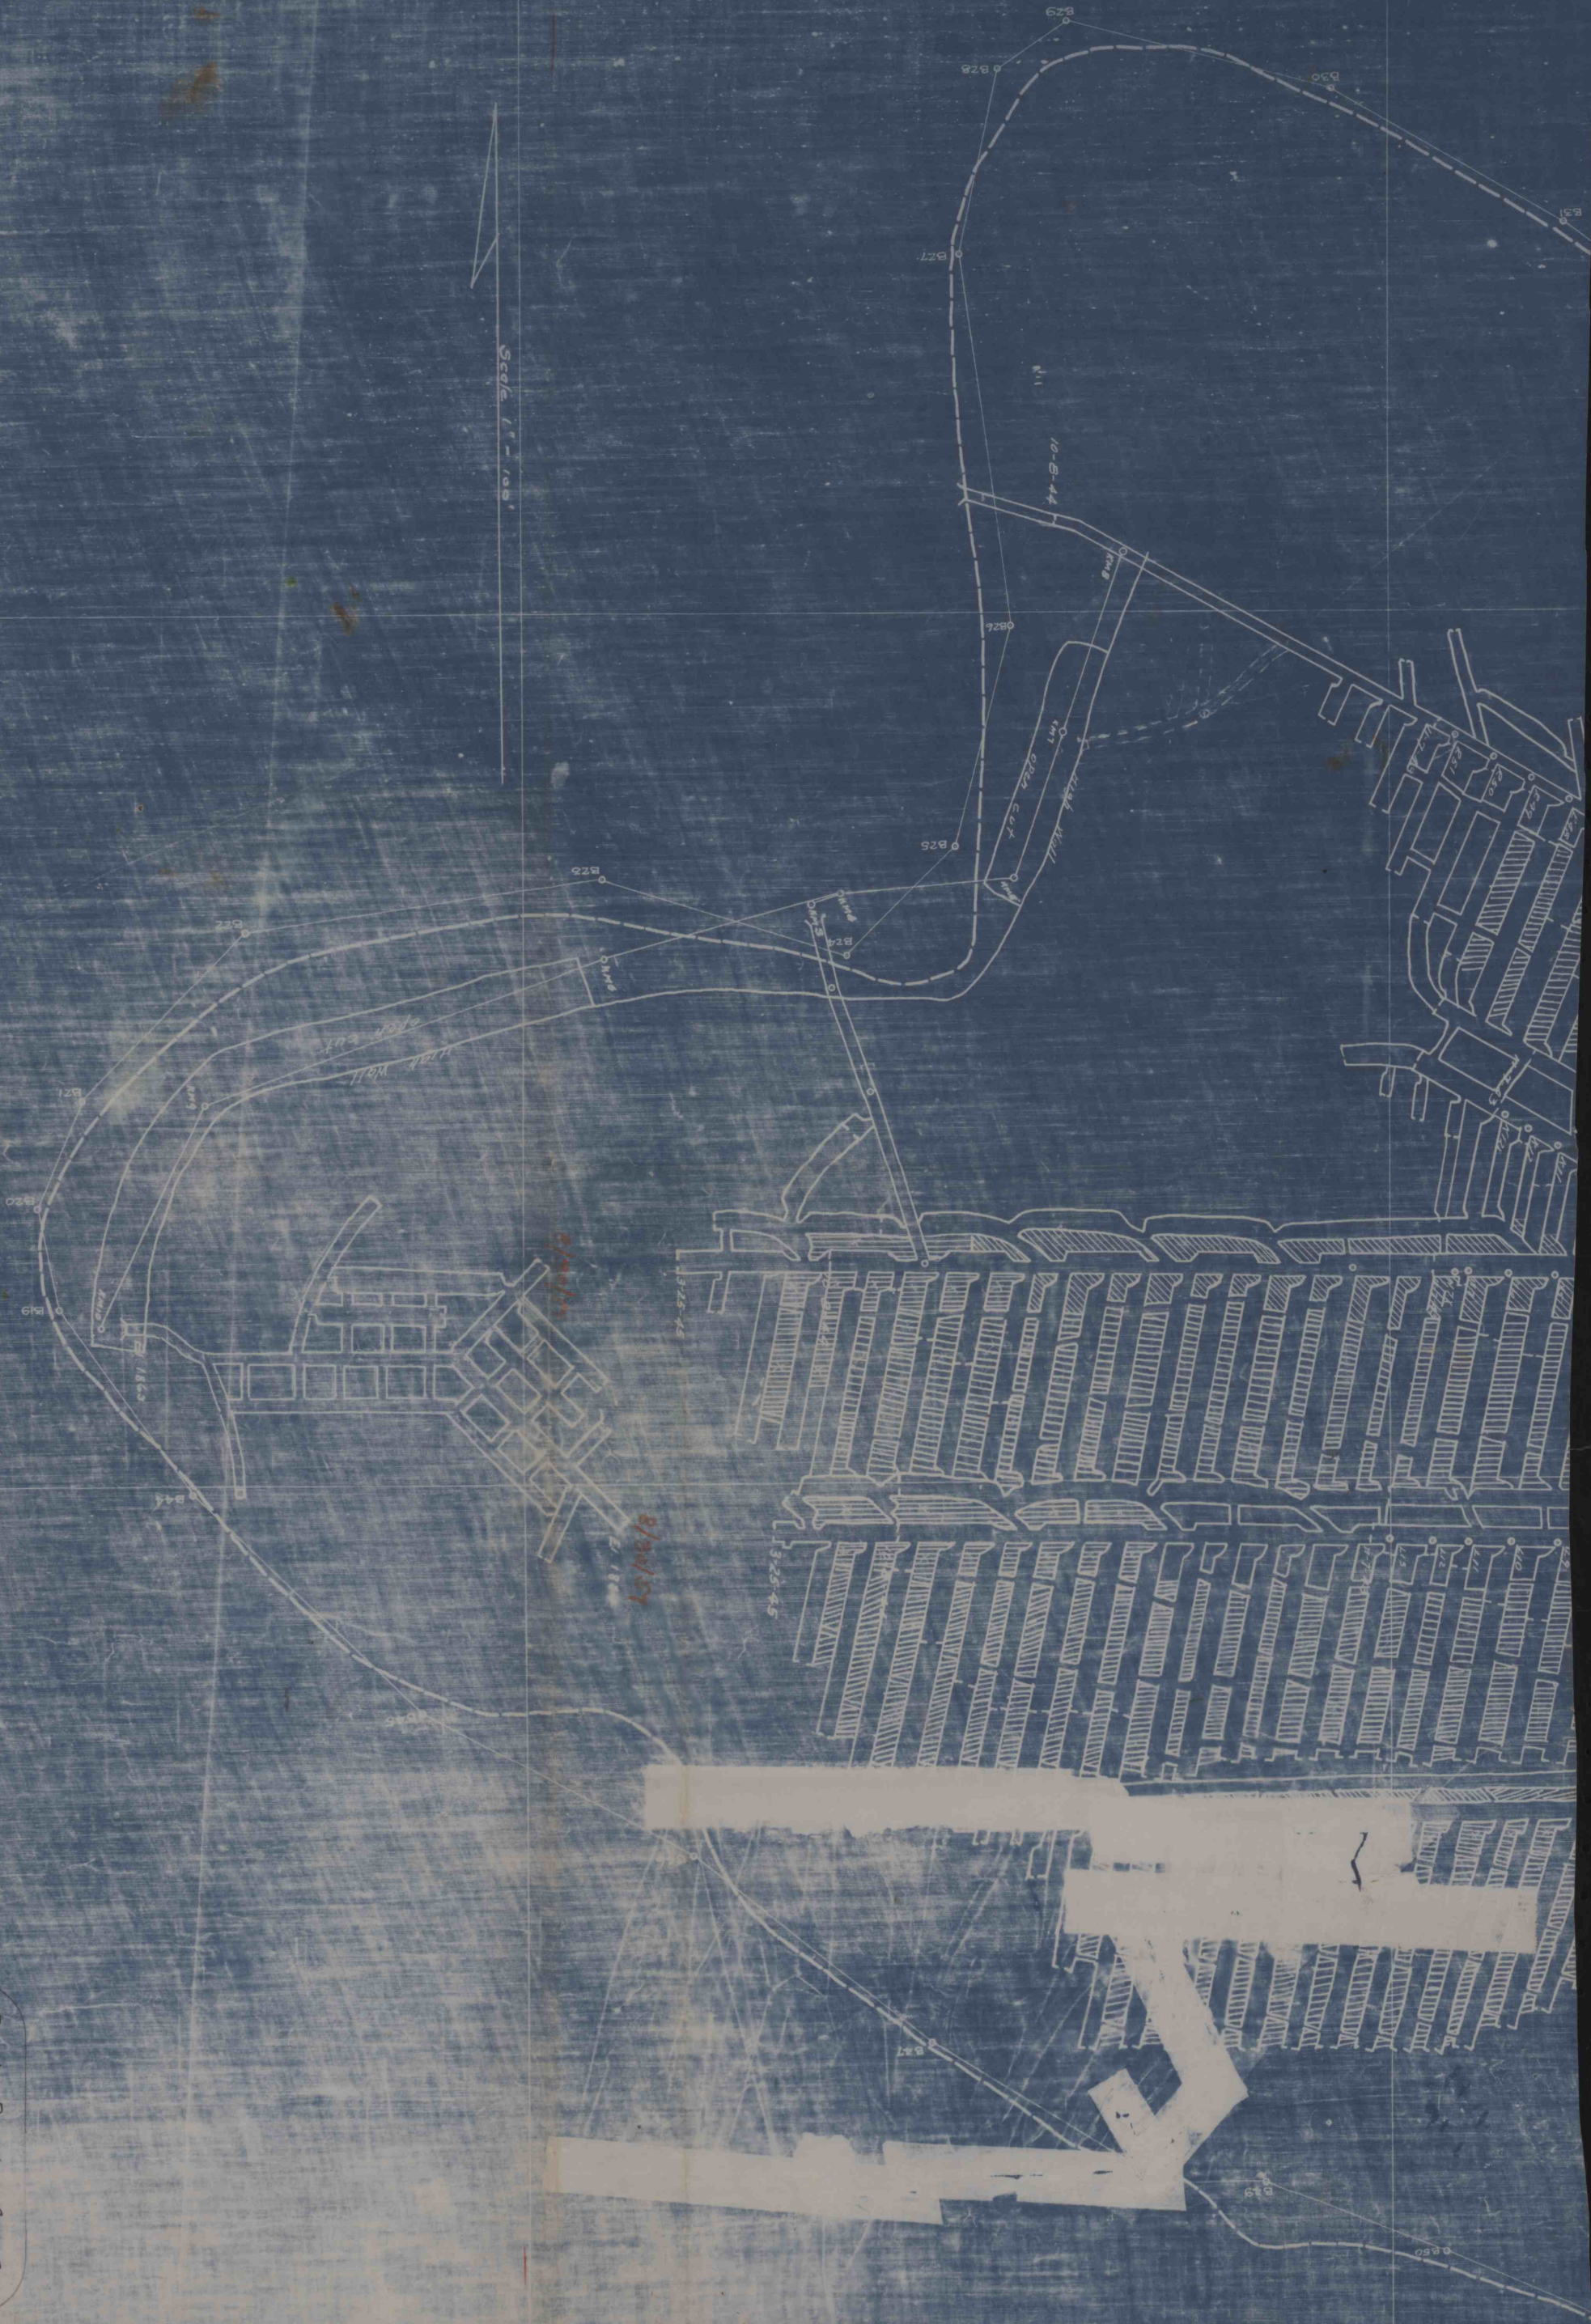

8/20/37
E118

Bellin Brothers Coal Co,
 Bellin
 Cambria Co. District 18
 1936 Annual