





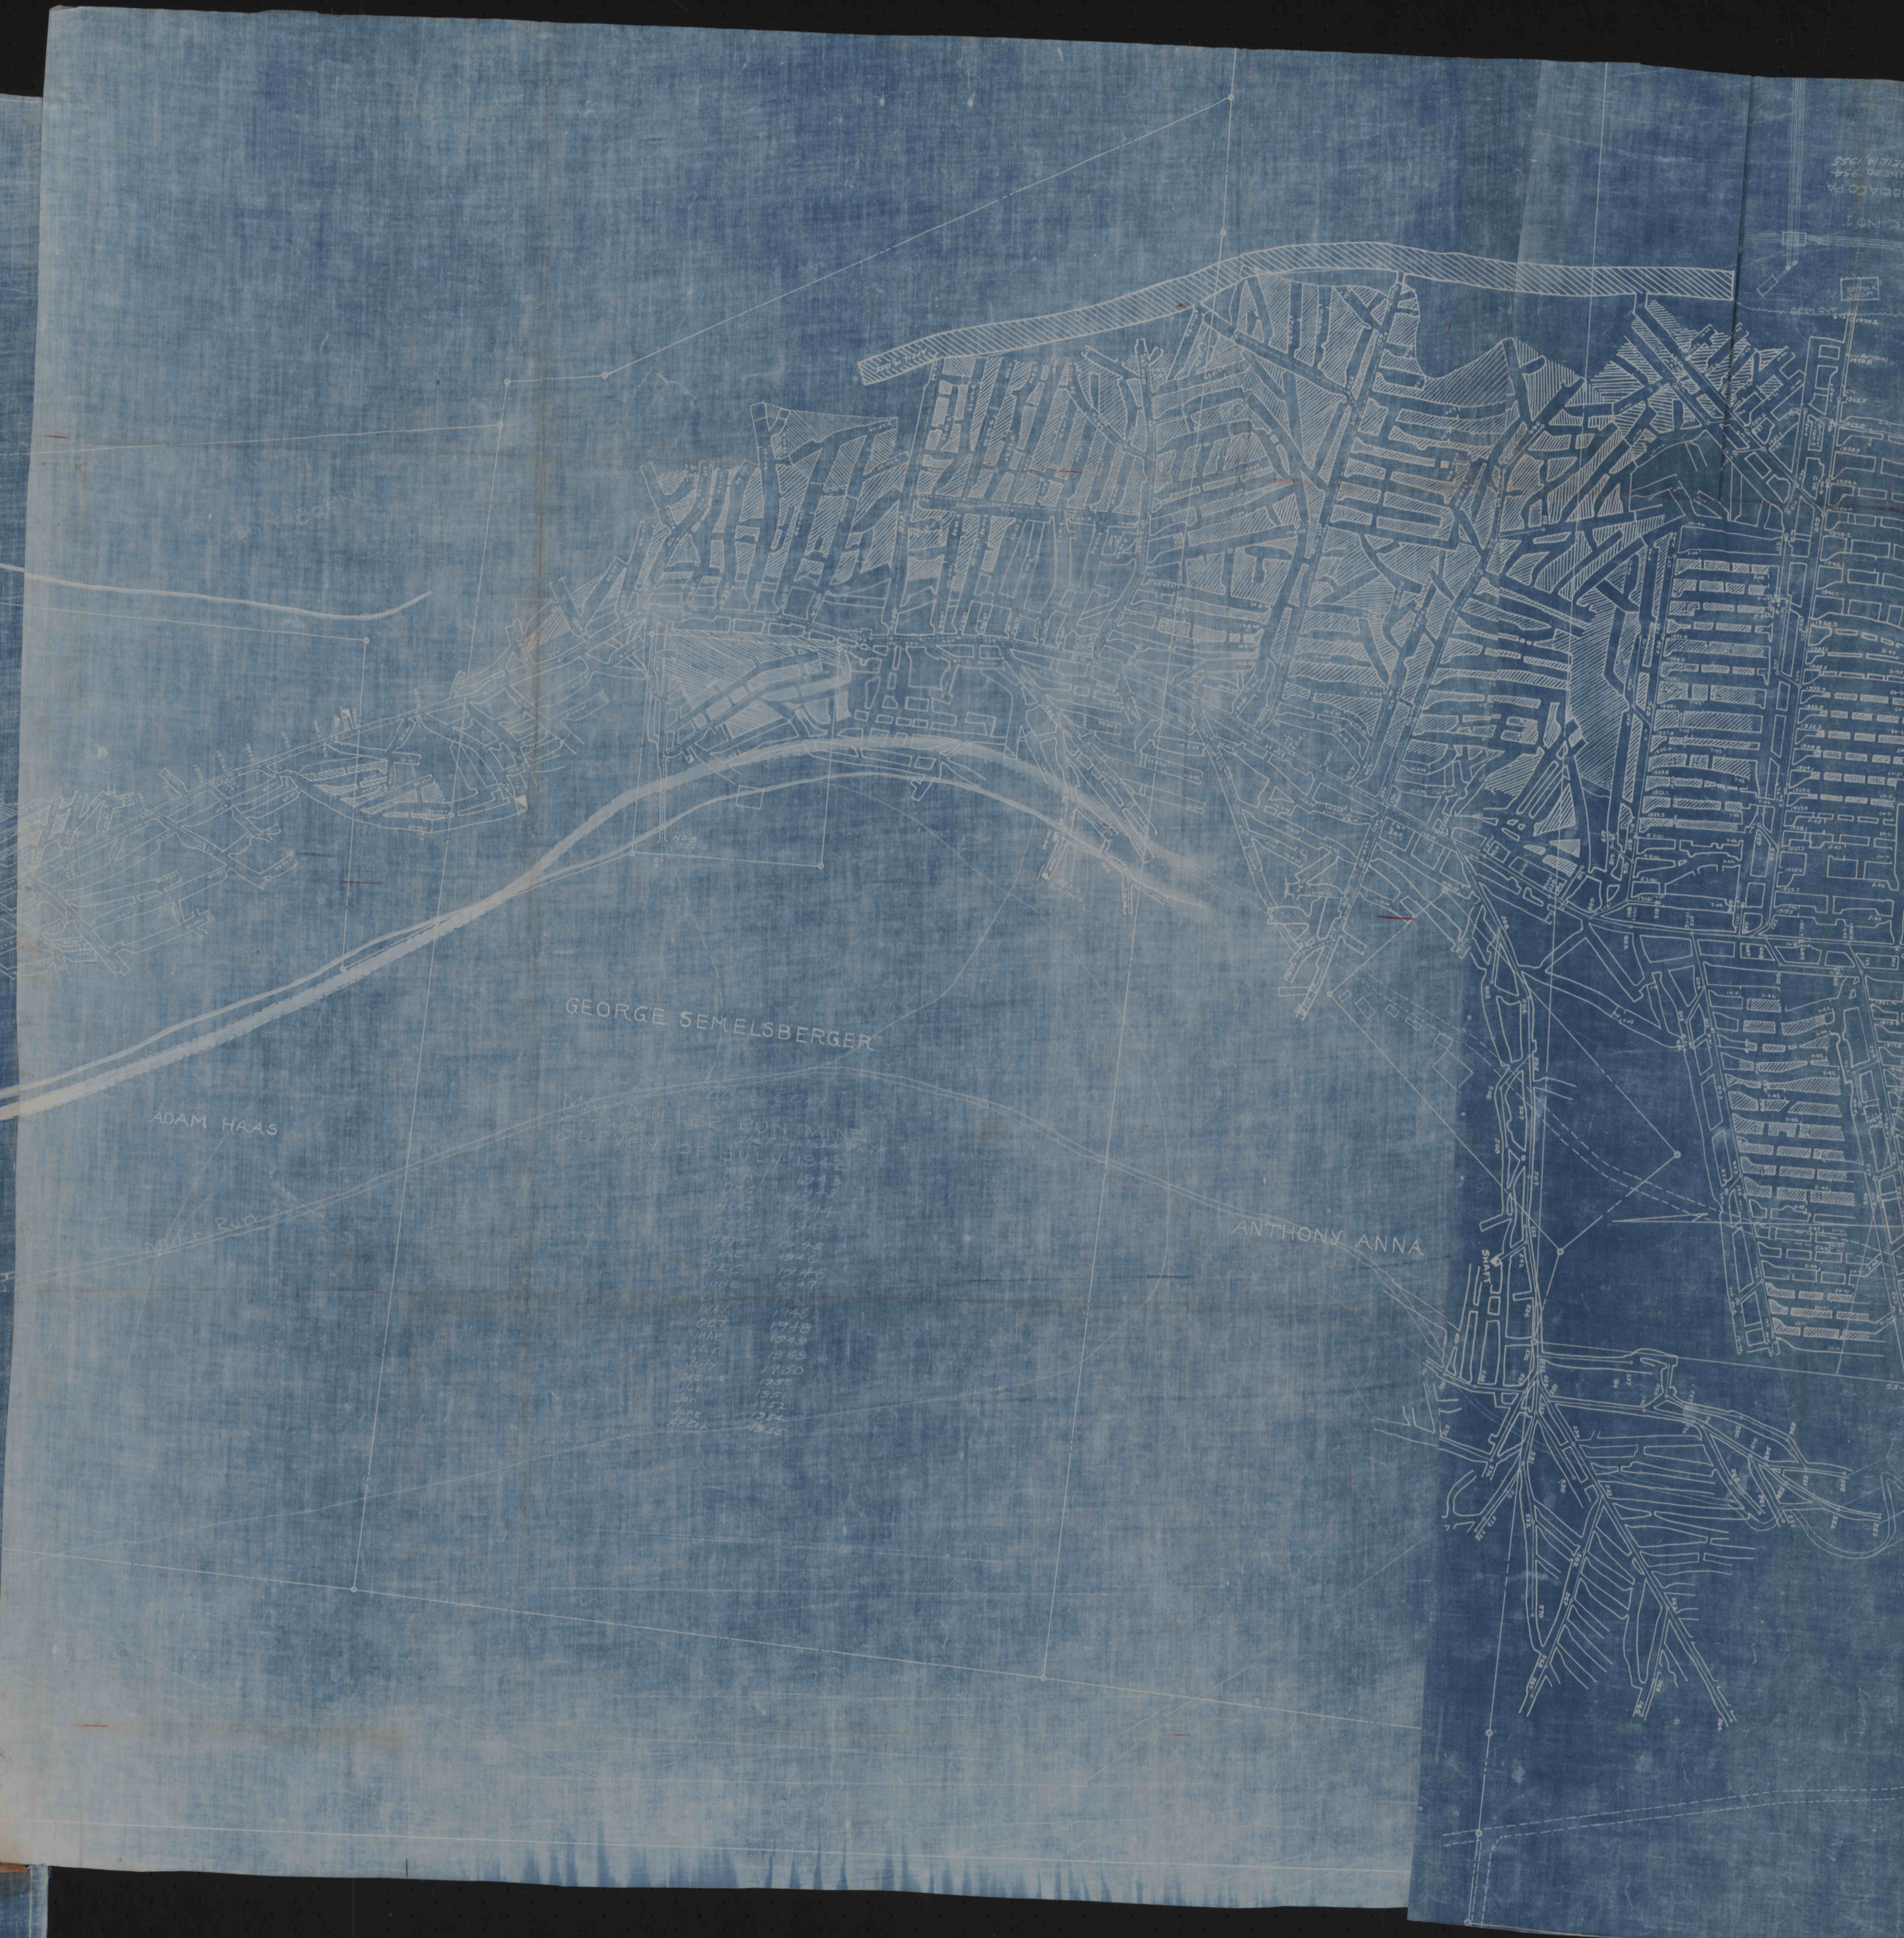

ADAM HAAS

GEORGE SEMELSBERGER

ANTHONY ANNA