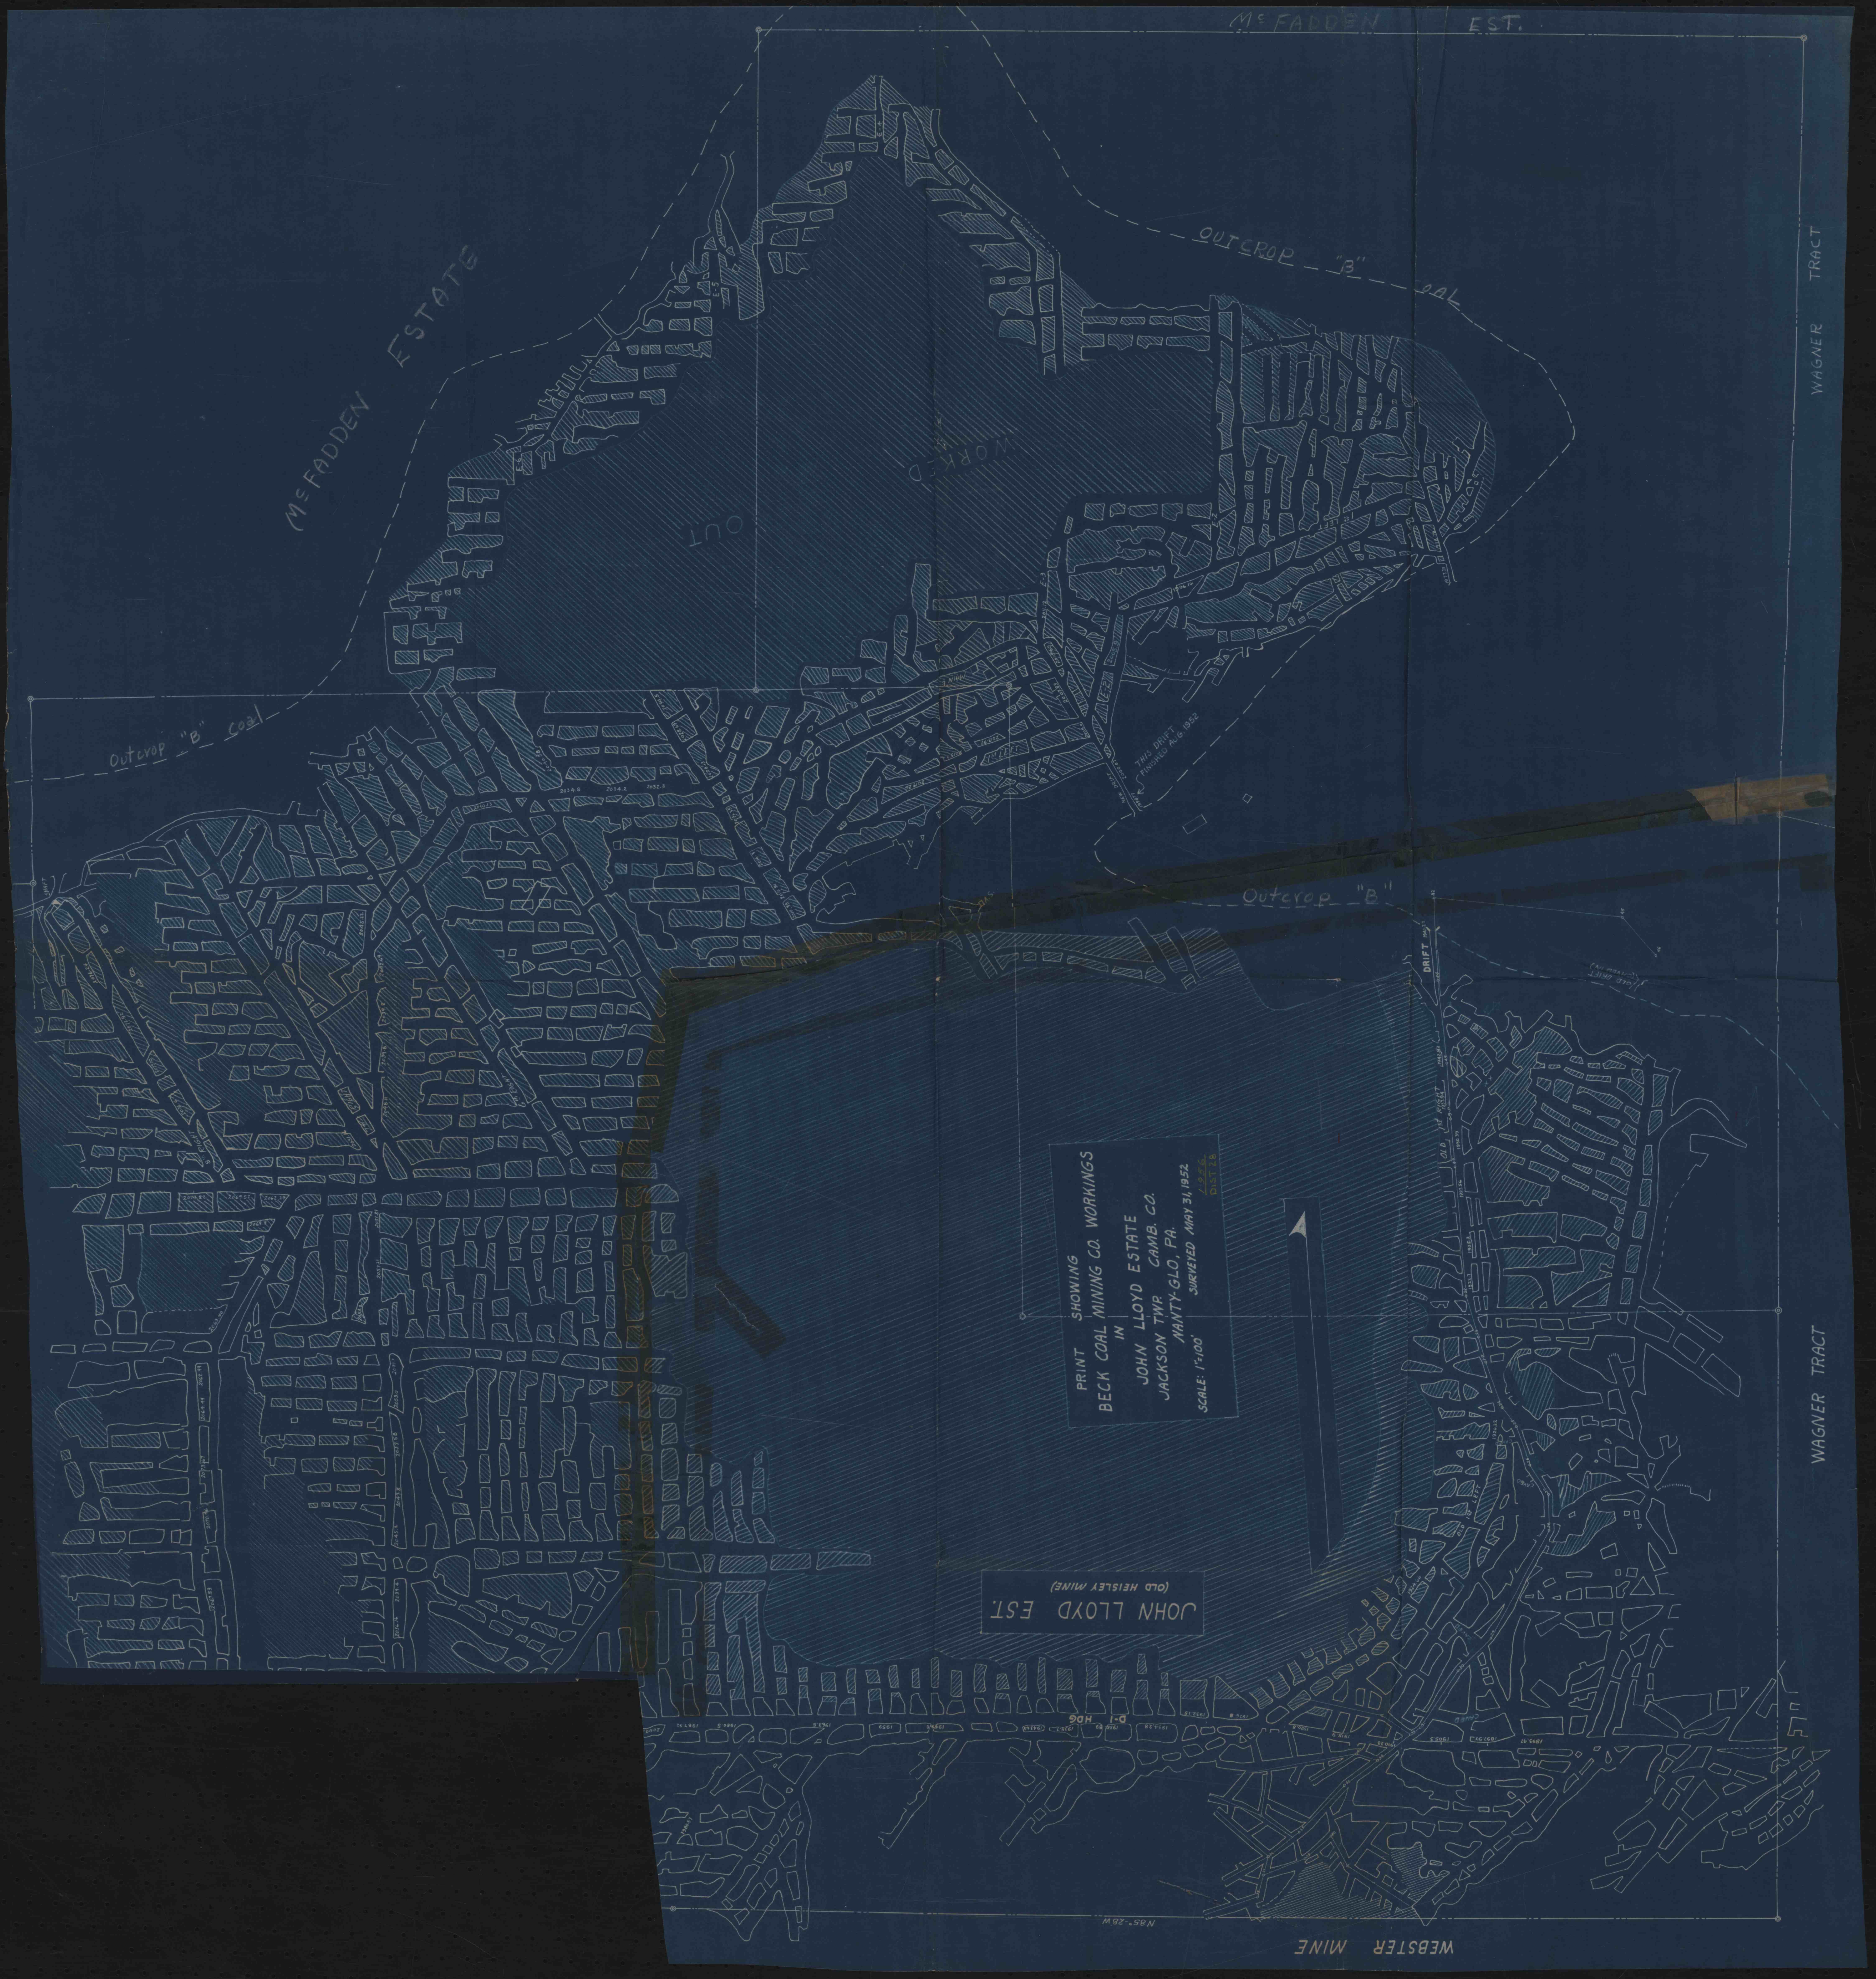
PRINT SHOWING
BECK COAL MINING CO. WORKINGS
IN
JOHN LLOYD ESTATE
JACKSON TWP. CAMB. CO.
NANTY-GLO, PA.
SCALE: 1"=100'
SURVEYED MAY 31, 1952
1956
DIST 28
JOHN LLOYD EST.
(OLD HEISLEY MINE)
McFADDEN EST.
McFADDEN ESTATE
OUTCROP "B" COAL
Outcrop "B" Coal
Outcrop "B"
WORKED OUT
WAGNER TRACT
WAGNER TRACT
THIS DRIFT FINISHED AUG. 1952
NEW DRIFT
DRIFT
OLD DRIFT (CAVED IN)
OLD 1ST RIGHT
OLD 1st LEFT
1st LEFT
D-1 HDG
MAIN
SHAFT
CAVED
N85°-28'W
WEBSTER MINE