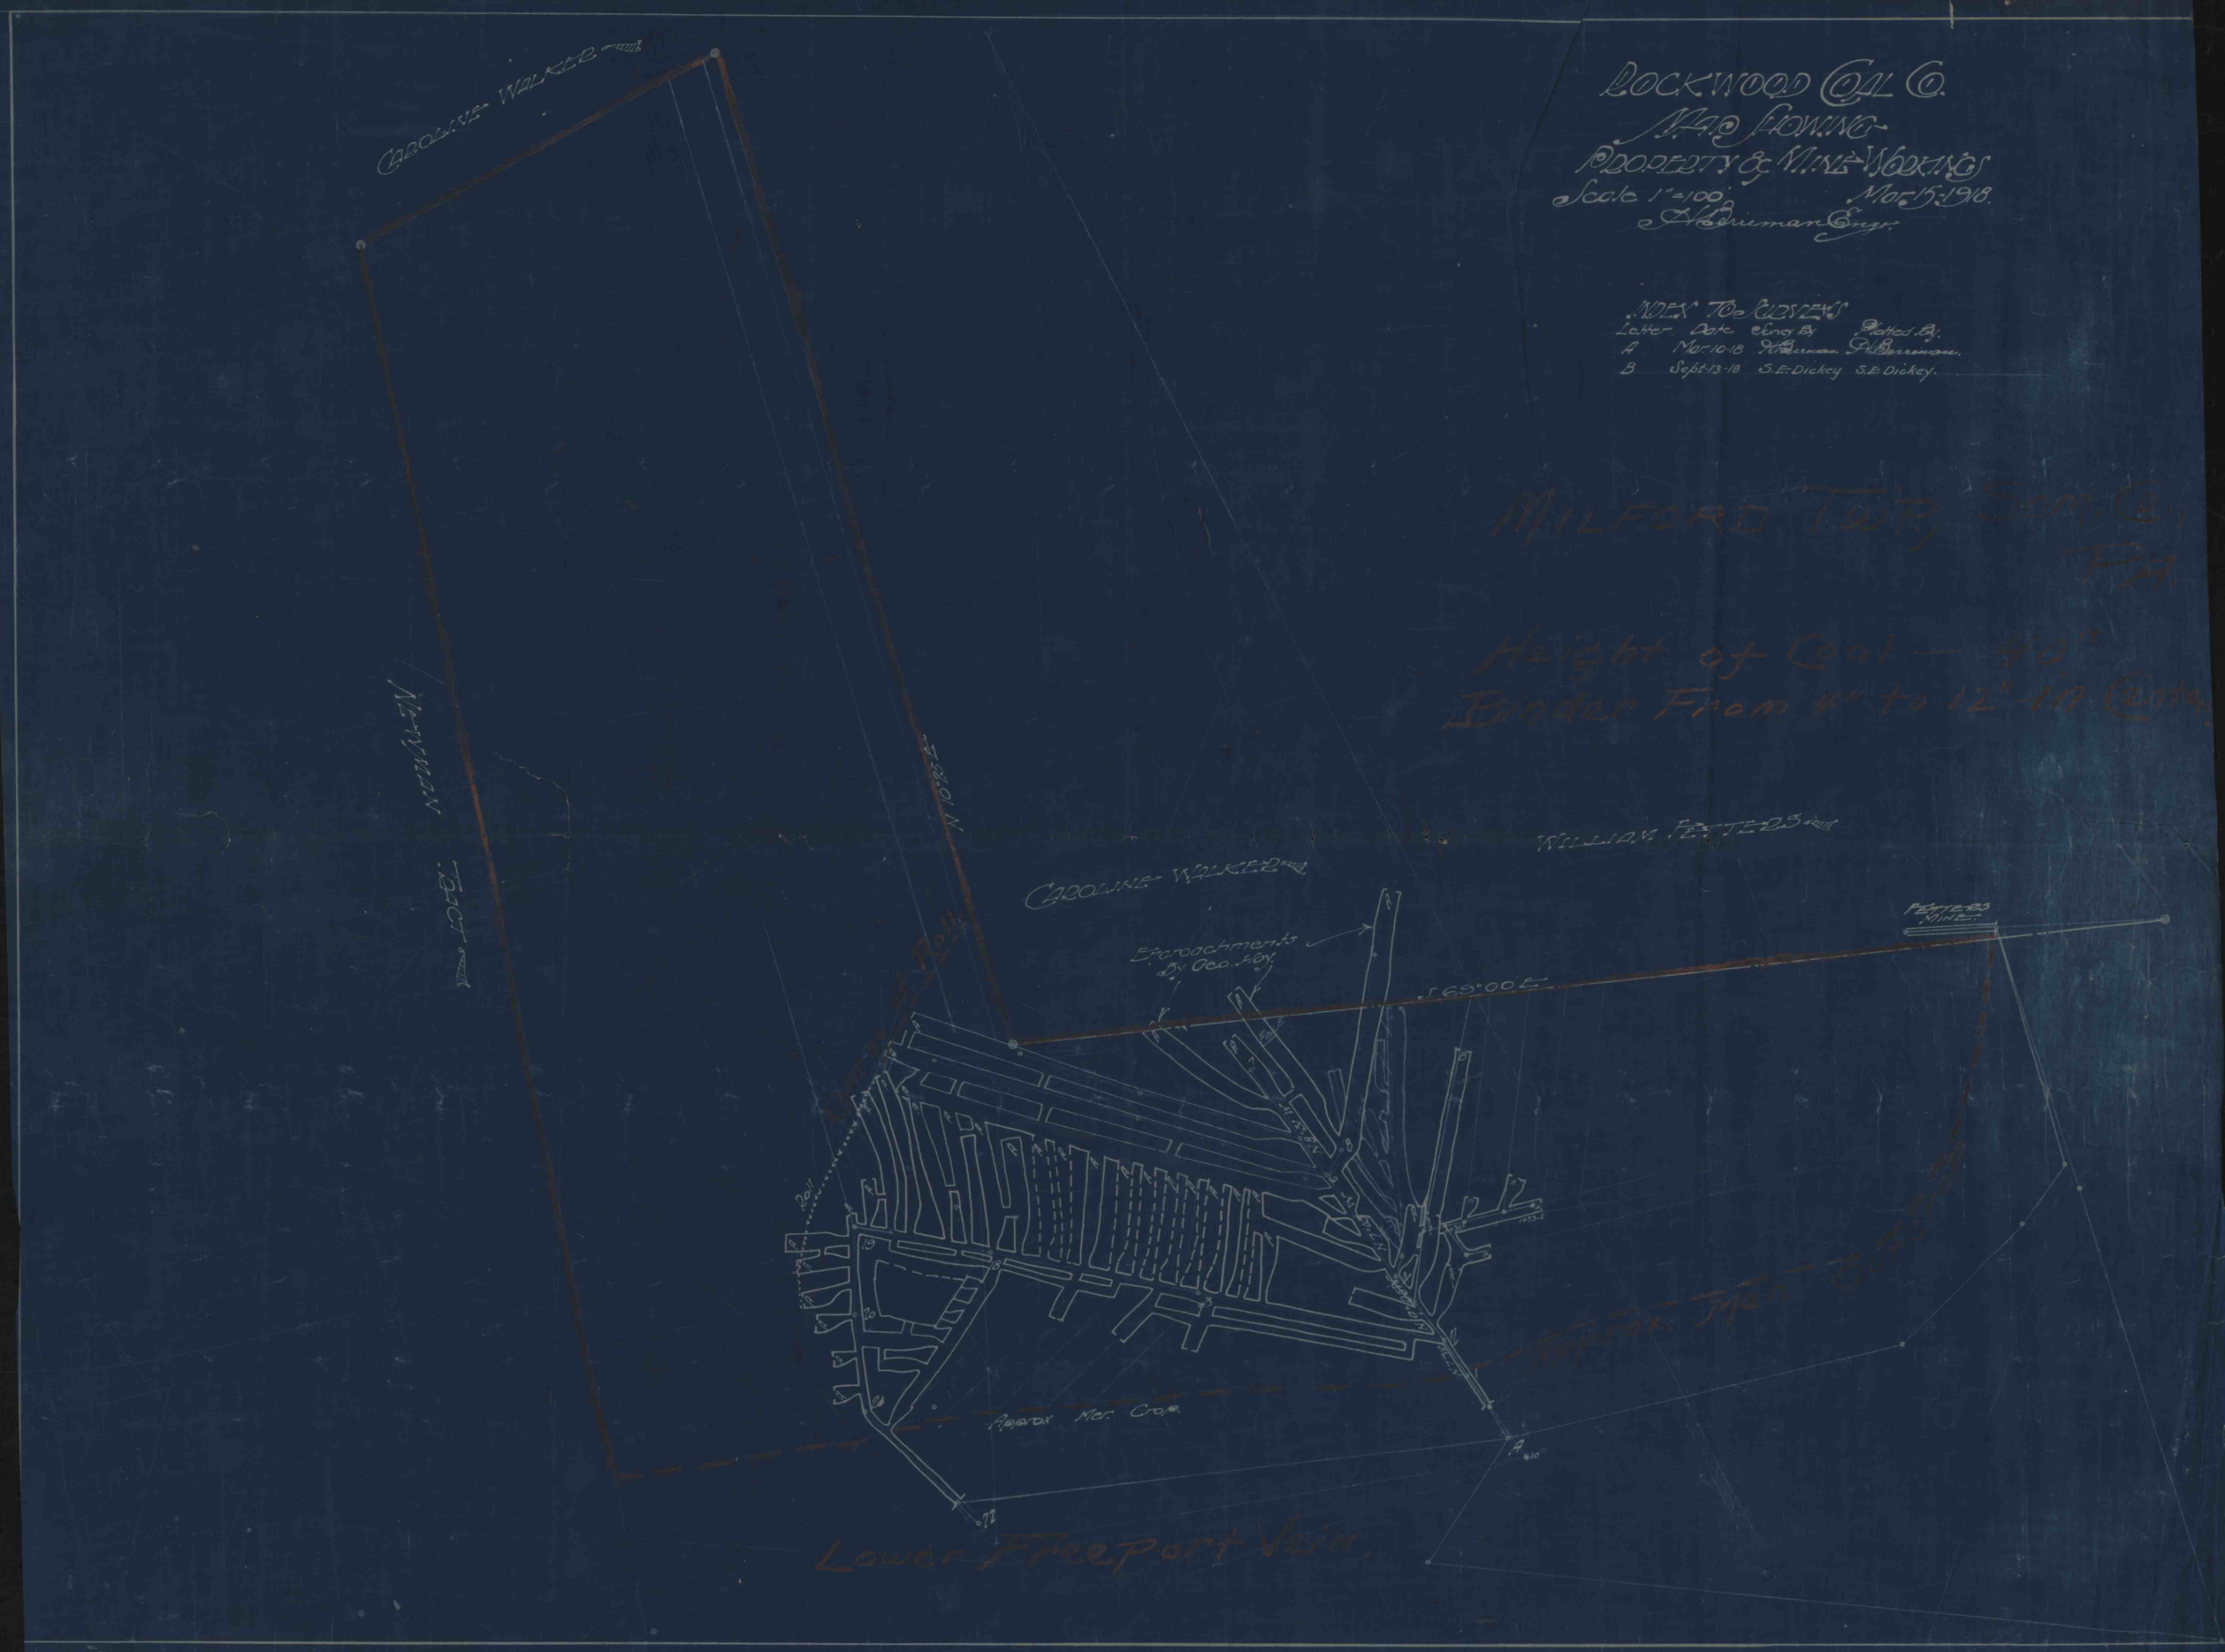
ROCKWOOD COAL CO.
MAP SHOWING
PROPERTY & MINE WORKINGS
Scale 1"=100'
Mar. 15-1918.
H. Brierman Engr.
INDEX TO SURVEYS
Letter Date Survey By Plotted By.
A Mar. 10-18 H. Brierman H. Brierman.
B Sept-13-18 S.E. Dickey S.E. Dickey.
Height of Coal — 40"
Binder From 4" to 12" 4 ft. Capta.
CAROLINE WALKER
WILLIAM FETTERS
Encroachments By Geo. Hay
S 69°00' E
FETTERS MINE
Approx Mer. Crop
Lower Freeport Vein.