


V.R. PAUL COAL CO
 STONEY TOWN, PENNA.
 QUEMAHONING TWP.
 SOMERSET CO.

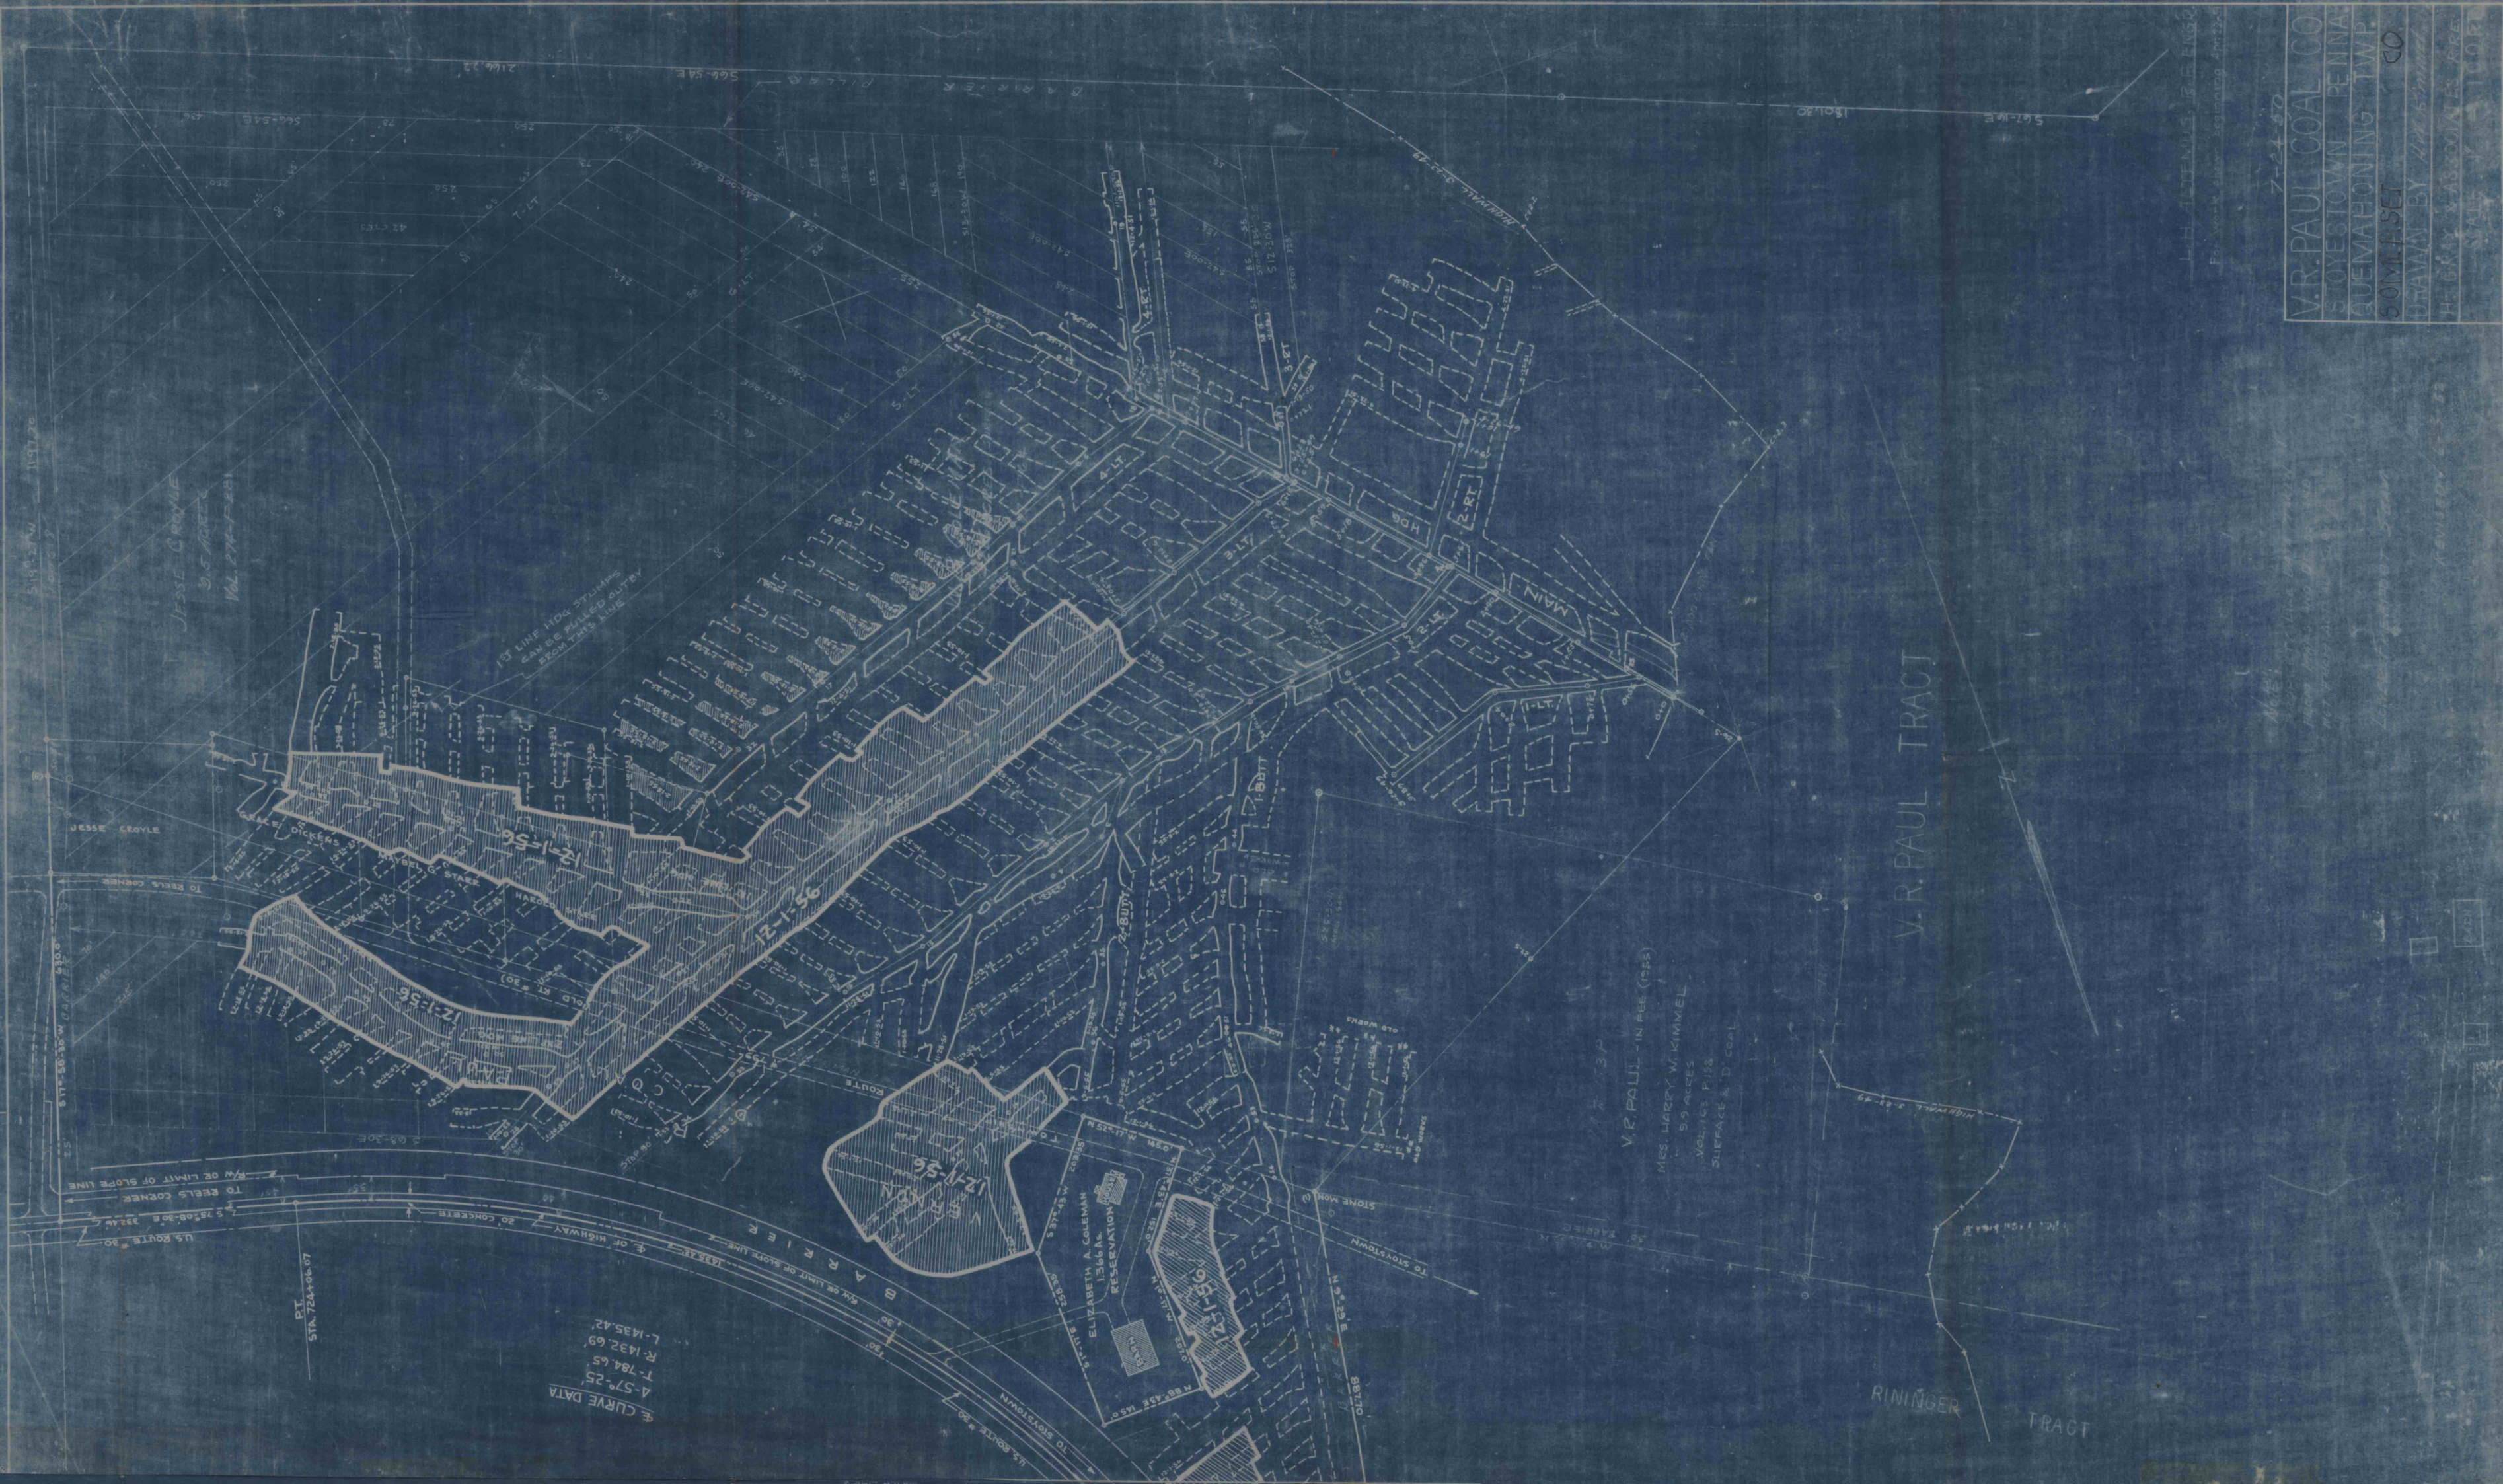

MINERAL PROPERTY SURVEYED FOR
VERNON R. PAUL
 D or UPPER FREEPORT COAL SEAM
 QUEMAHONING TOWNSHIP, SOMERSET CO., PA.
 SCALE 1"=100'
 MARCH 30th, 1952.
 L. H. ALTEMUS, R.P.E.

Curve Data
 A-57° 25'

10A-120