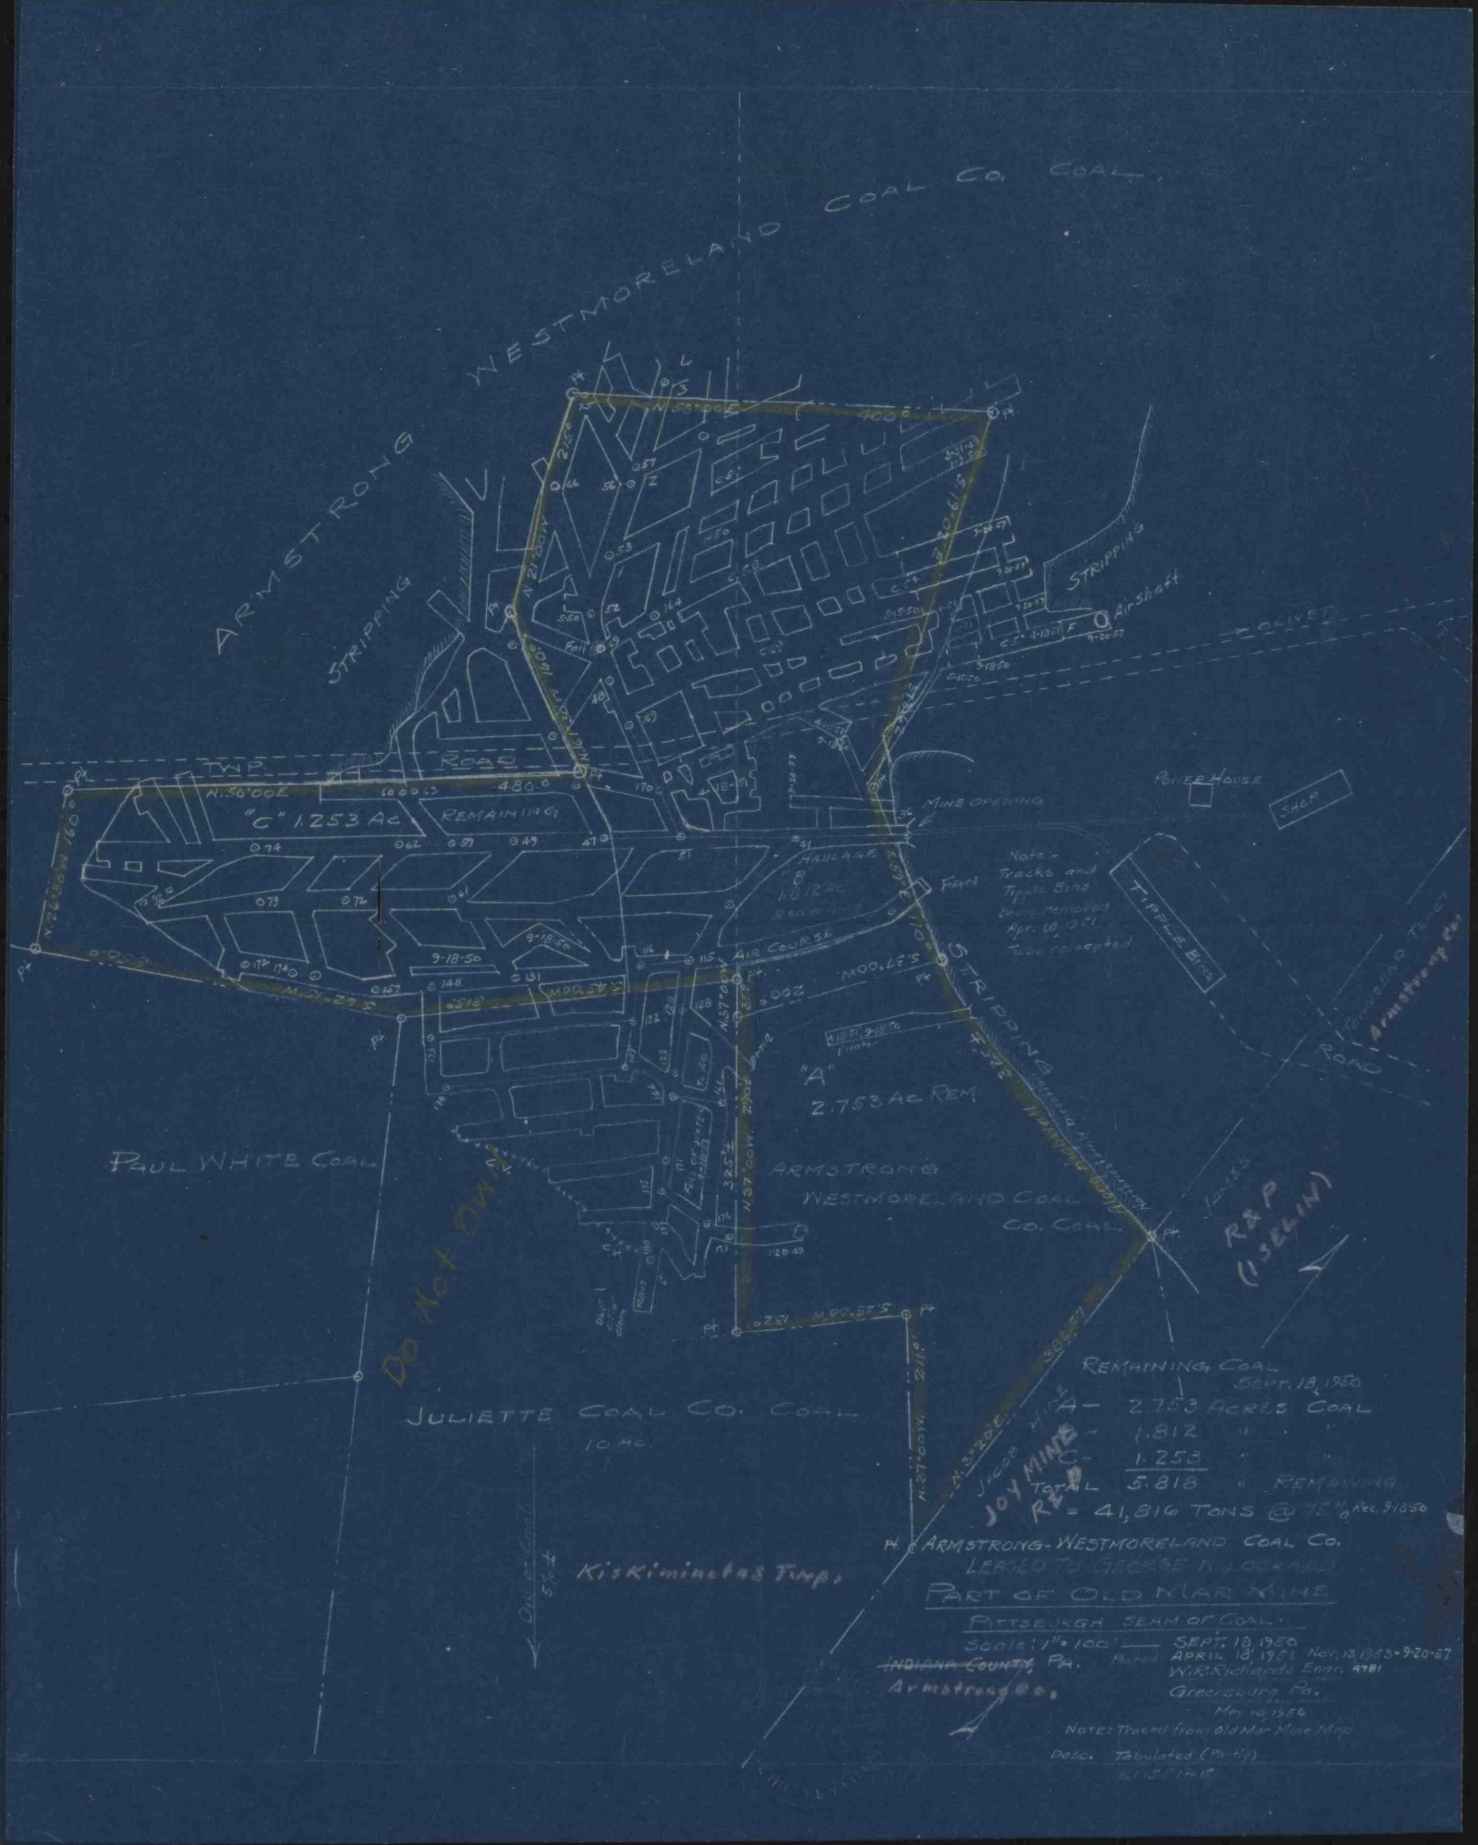

ARMSTRONG WESTMORELAND COAL CO. COAL
STRIPPING
STRIPPING
Airshaft
OLIVET
TWP. ROAD
"C" 1.253 Ac REMAINING
MINE OPENING
POWER HOUSE
SHOP
HAULAGE
FAN
Note - Tracks and Tipple Bins being removed Apr. 18, 1951 To be relocated
TIPPLE BINS
AIR COURSE
STRIPPING
"A" 2.753 Ac REM
PAUL WHITE COAL
ARMSTRONG WESTMORELAND COAL CO. COAL
JAMES
R&P (ISELIN)
Do Not Own
JULIETTE COAL CO. COAL
10 AC.
JOY MINE
Kiskiminetas Twp.
REMAINING COAL
SEPT. 18, 1950
A - 2.753 ACRES COAL
B - 1.812 " "
C - 1.253 " "
TOTAL 5.818 " REMAINING
R&P = 41,816 TONS @ 75% Rec. 9-18-50
ARMSTRONG-WESTMORELAND COAL CO.
LEASED TO GEORGE N. LOCKARD
PART OF OLD MAR MINE
PITTSBURGH SEAM OF COAL
Scale: 1" = 100'
SEPT. 18, 1950
APRIL 18, 1951 Nov. 13, 1953 - 9-20-57
W.R. Richards Engr. 4781
Greensburg Pa.
May 10, 1956
NOTE: Traced from Old Mar Mine Map
Desc. Tabulated (Partly)
~~INDIANA COUNTY~~, PA.
Armstrong Co.