

N 3000

No. 12


N 2000

N 1000

7500

51000

100000

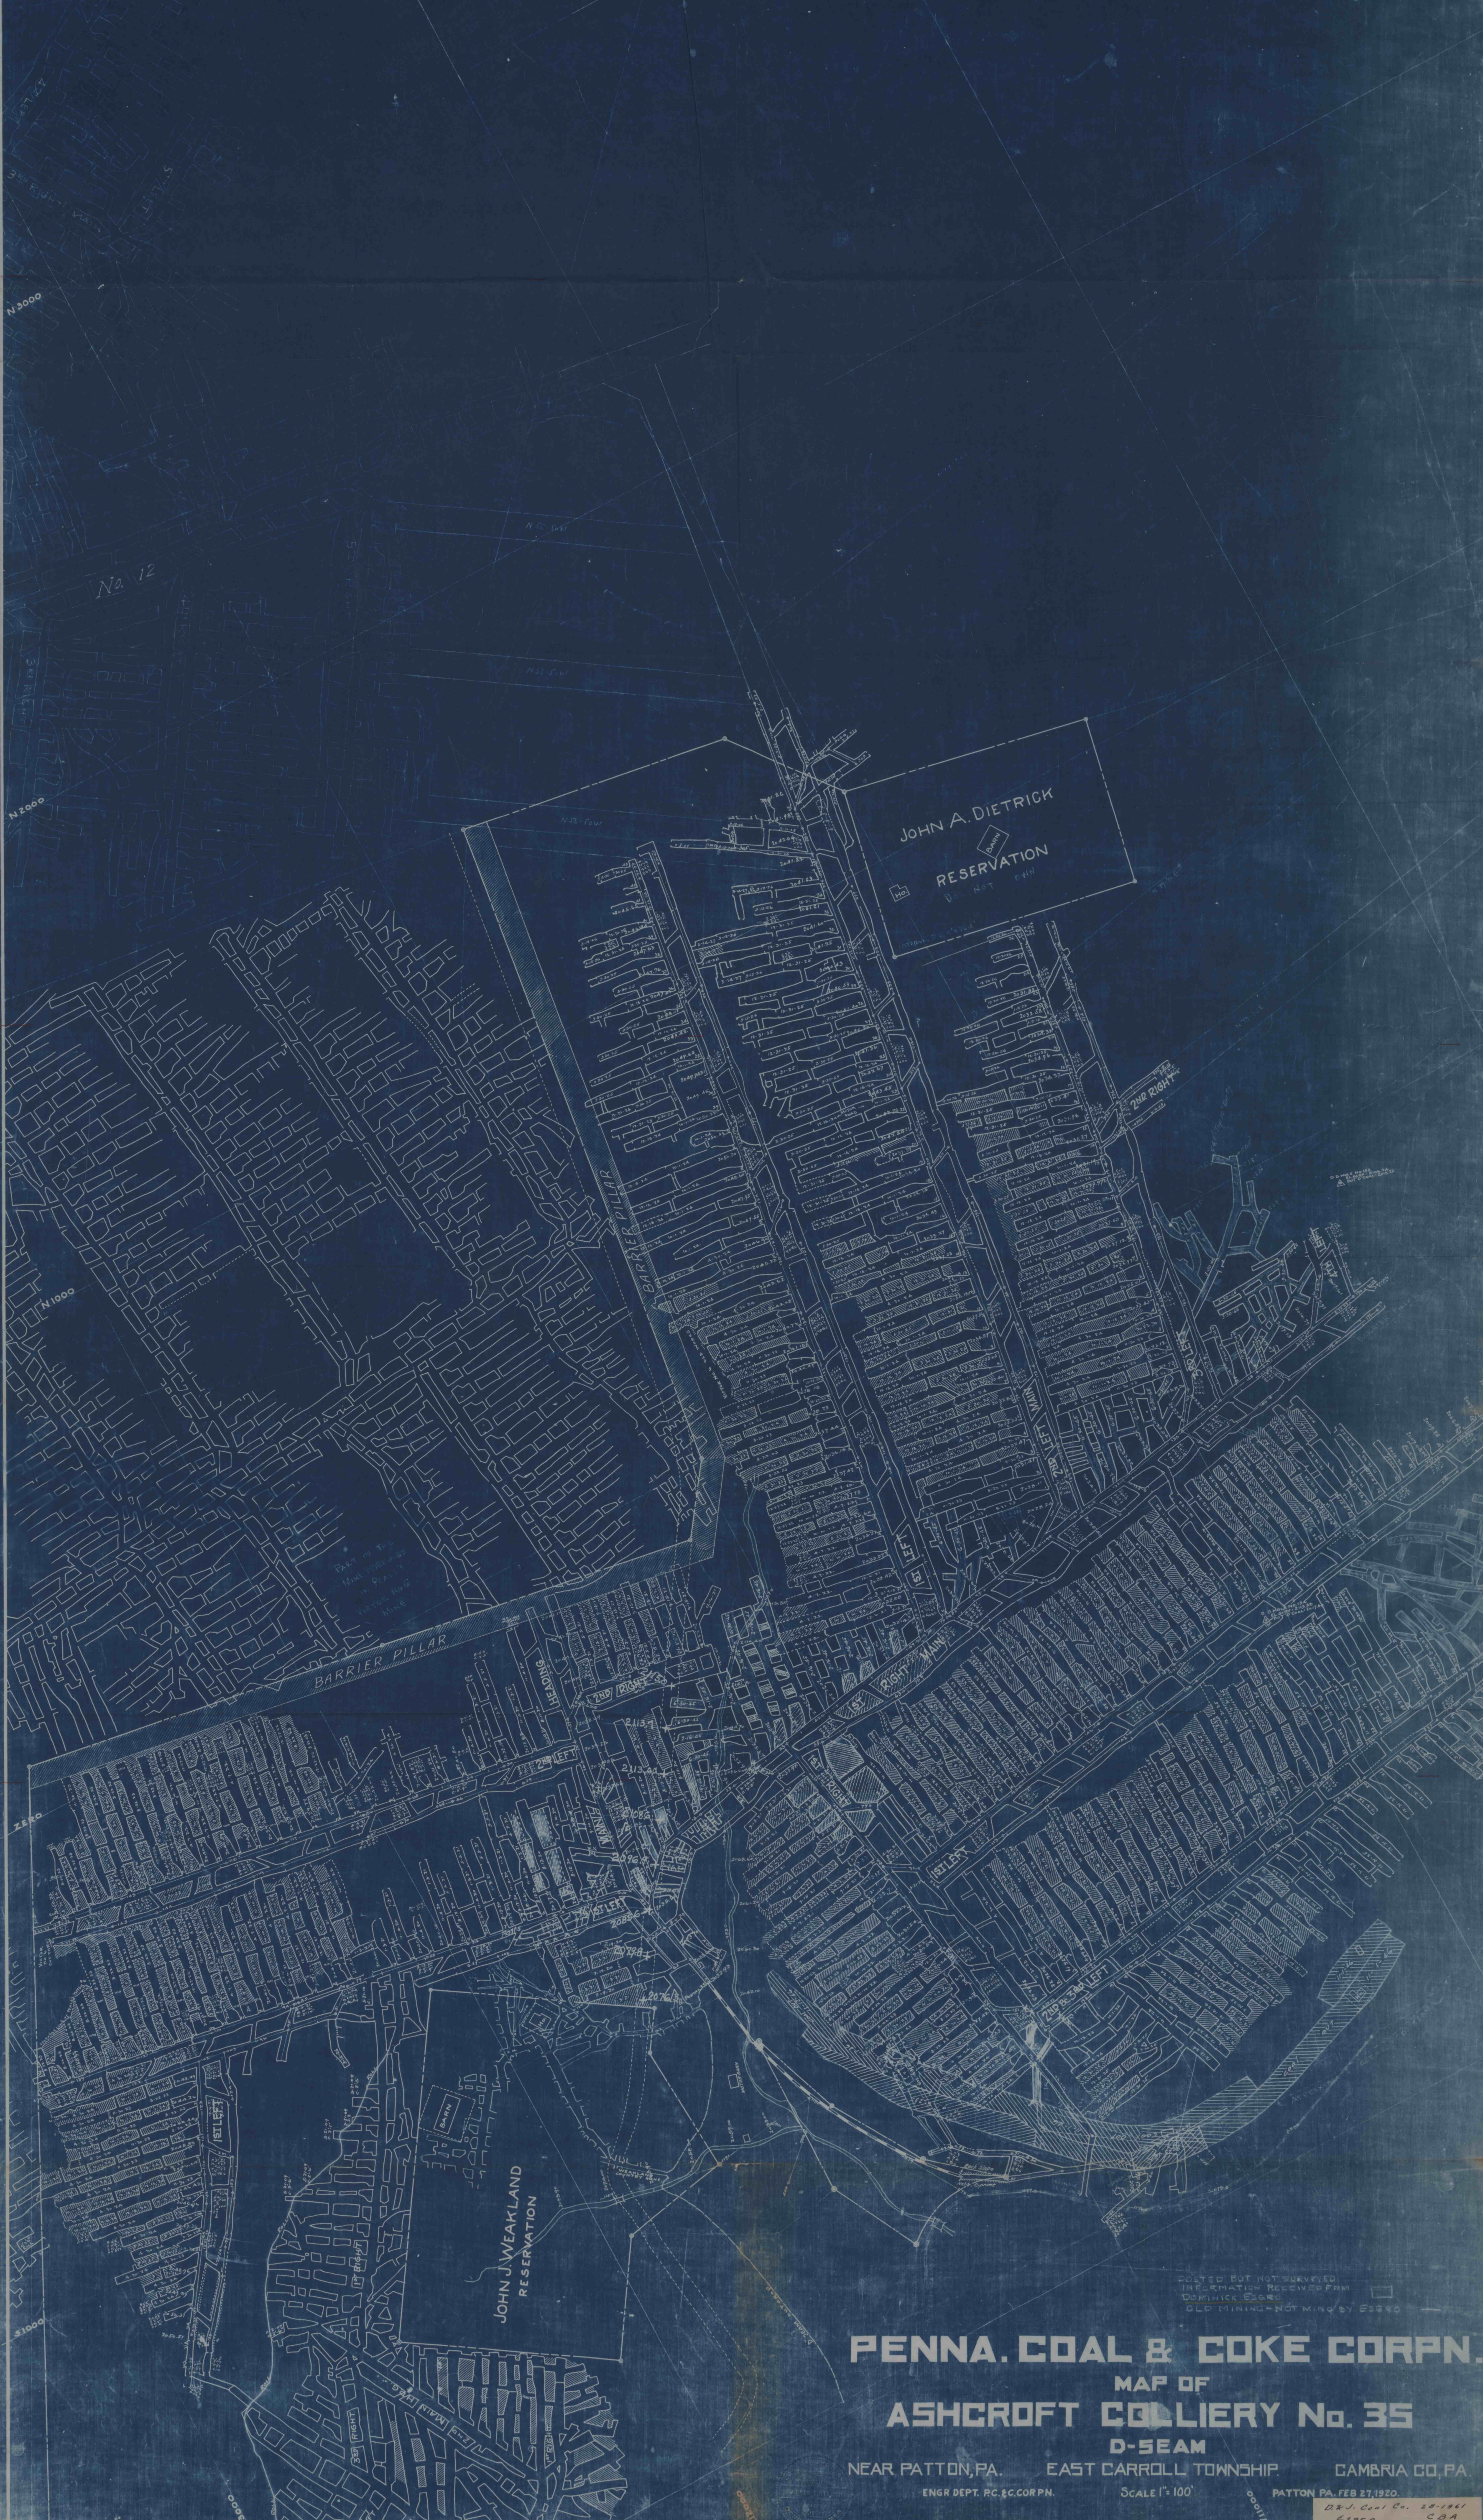

JOHN A. DIETRICK  
RESERVATION

JOHN J. WEAKLAND  
RESERVATION

**PENNA. COAL & COKE CORPN.**  
 MAP OF  
**ASHCROFT COLLIERY No. 35**  
 D-SEAM  
 NEAR PATTON, PA. EAST CARROLL TOWNSHIP. CAMBRIA CO., PA.

ENGR. DEPT. P.C. & C. CORPN.

SCALE 1" = 100'

PATTON PA. FEB 27 1920.

D.R.J. Cont. Co. 28-1061  
 Eng'rs C.B.A.

COLLECTED BUT NOT SURVEYED.  
 INFORMATION RECEIVED FROM  
 DOMINICK ESSEX  
 OLD MINING - NOT MINED BY ESSEX