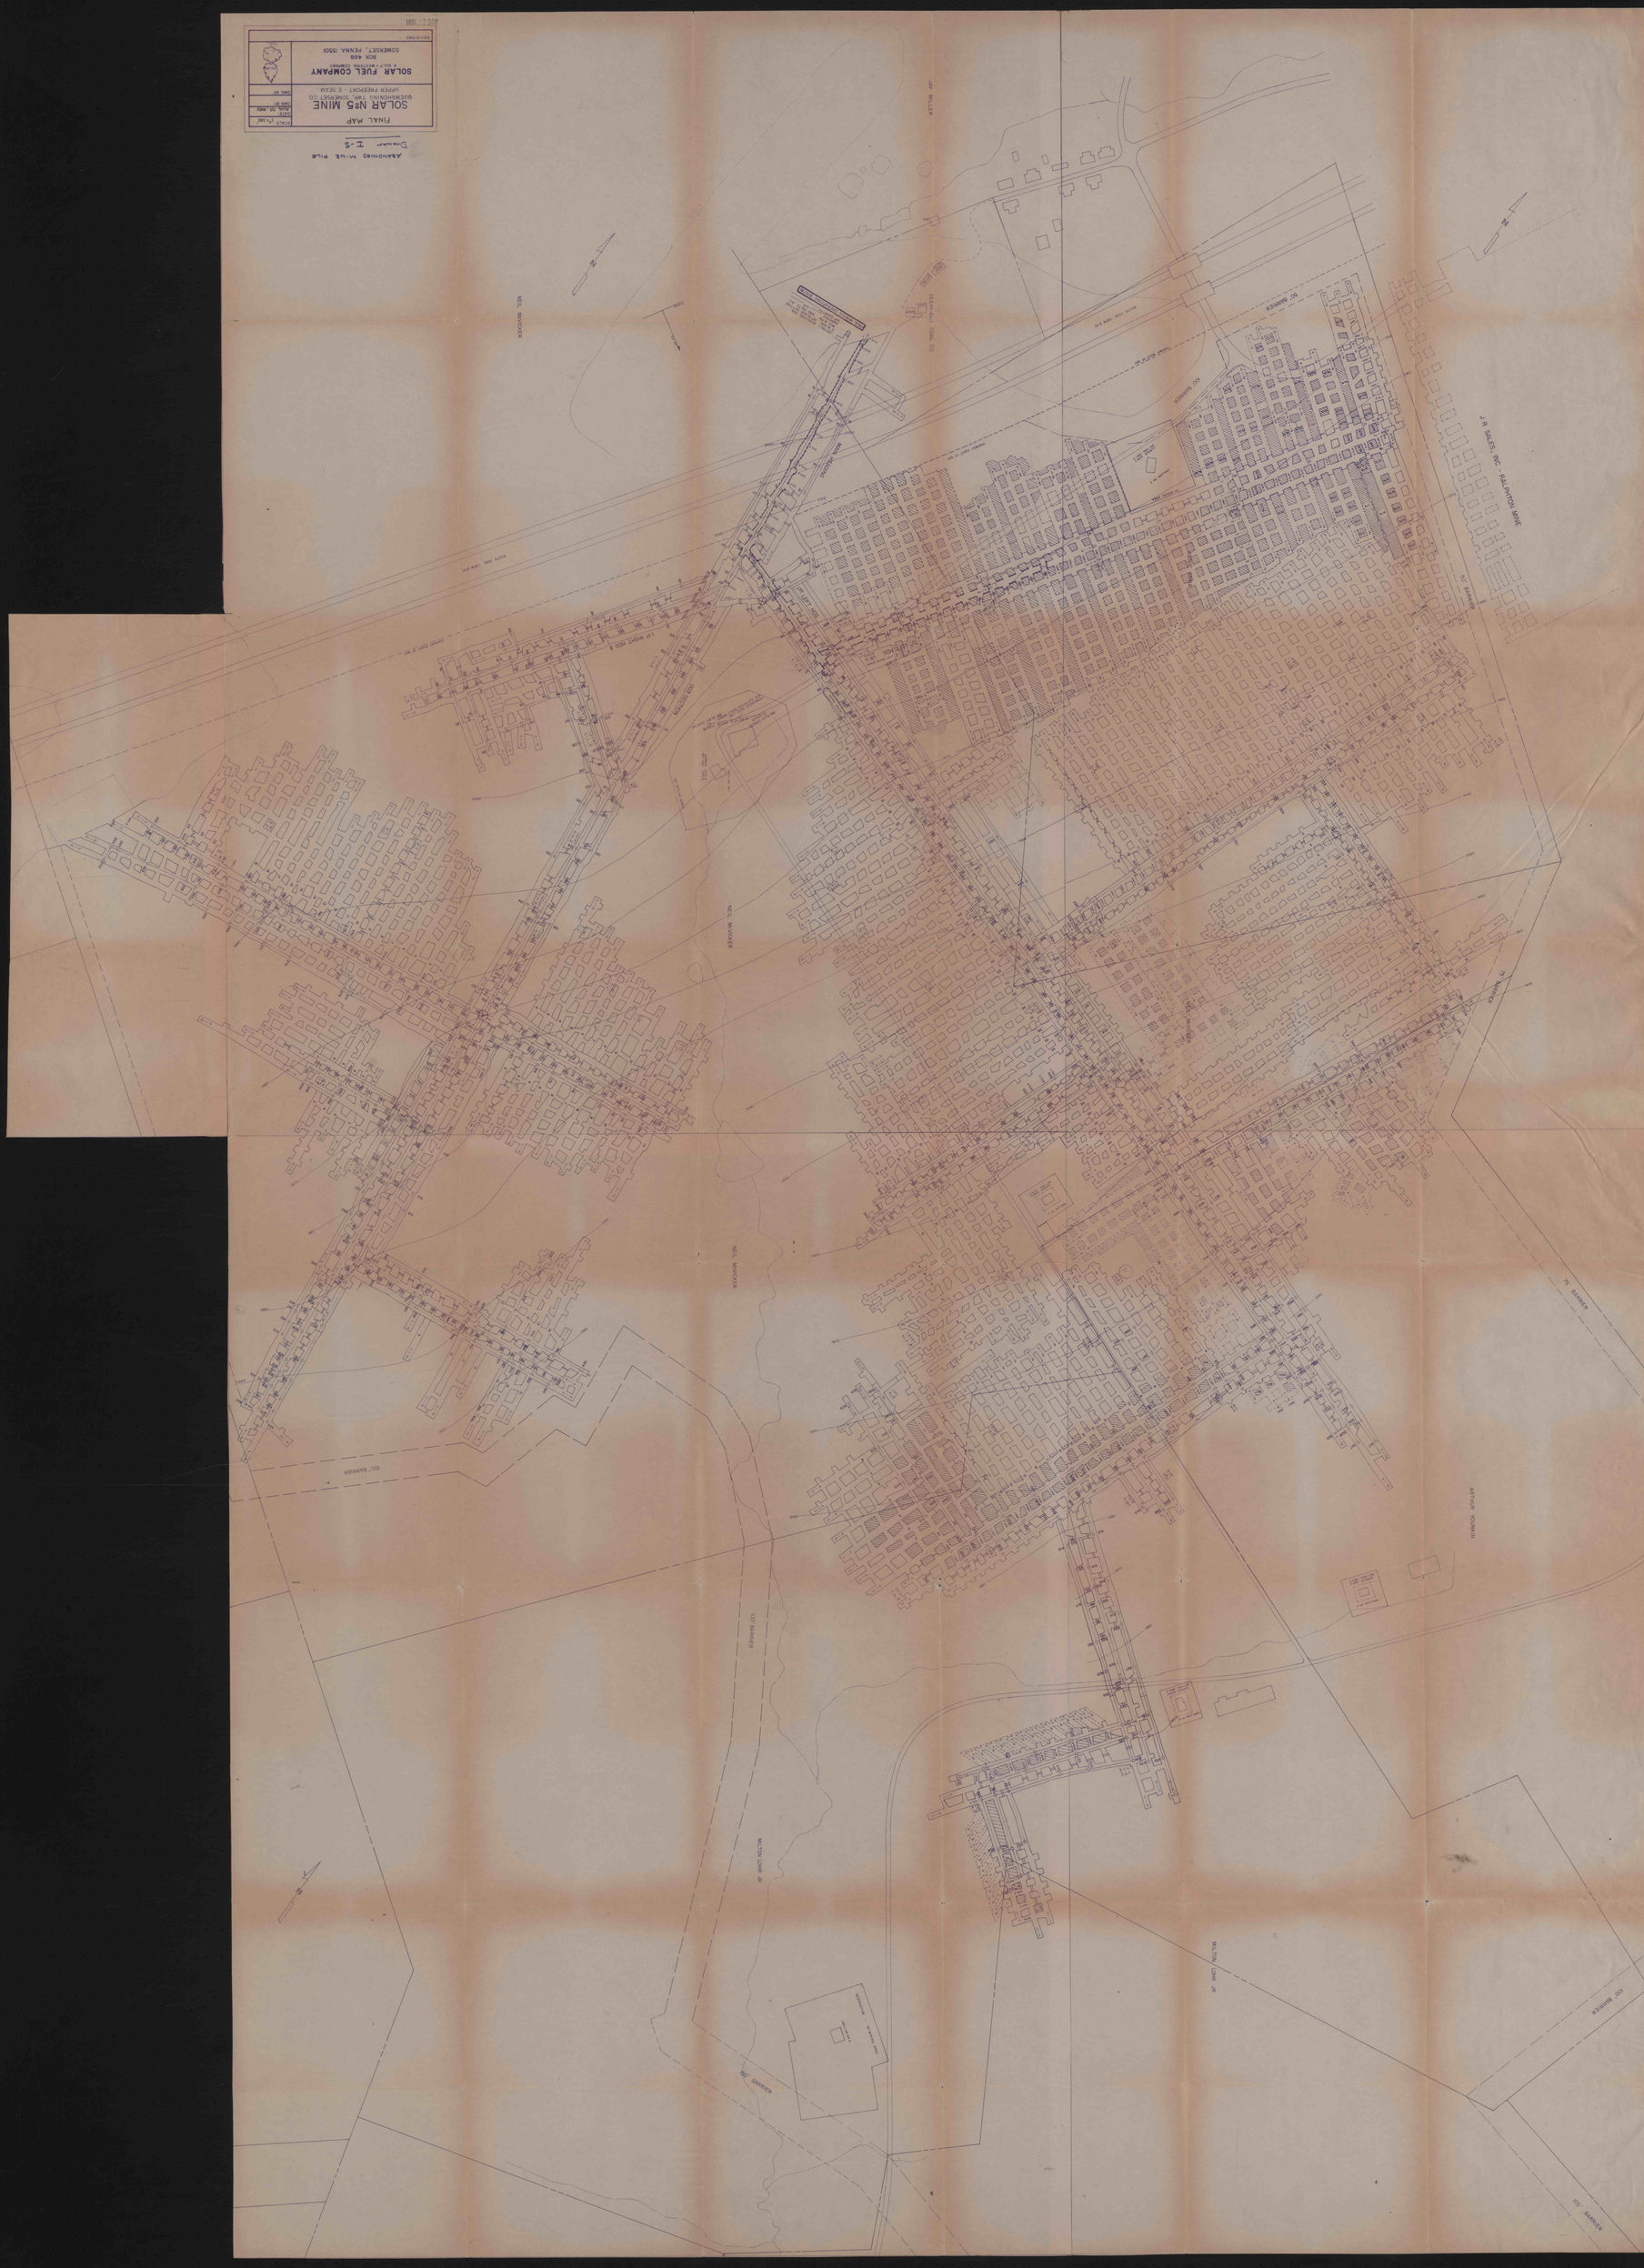

ABANDONED MINE FILE
Drawer I-5
FINAL MAP
SOLAR N°5 MINE
QUEMAHONING TWP, SOMERSET CO
UPPER FREEPORT - E SEAM
SOLAR FUEL COMPANY
A SOLAR METERS COMPANY
BOX 468
SOMERSET, PENNA 15501
REVISIONS
SCALE 1"=1000'
DATE
DWN BY
DWG NO
J R SALES, INC - RALPHTON MINE
NEIL MCVICKER
JAY MILLER
DEERFIELD COAL CO
ARTHUR YOUNKIN
MILTON LOHR JR