


304 133

Vinton No 12

1" = 100'

N

crop line E Cap

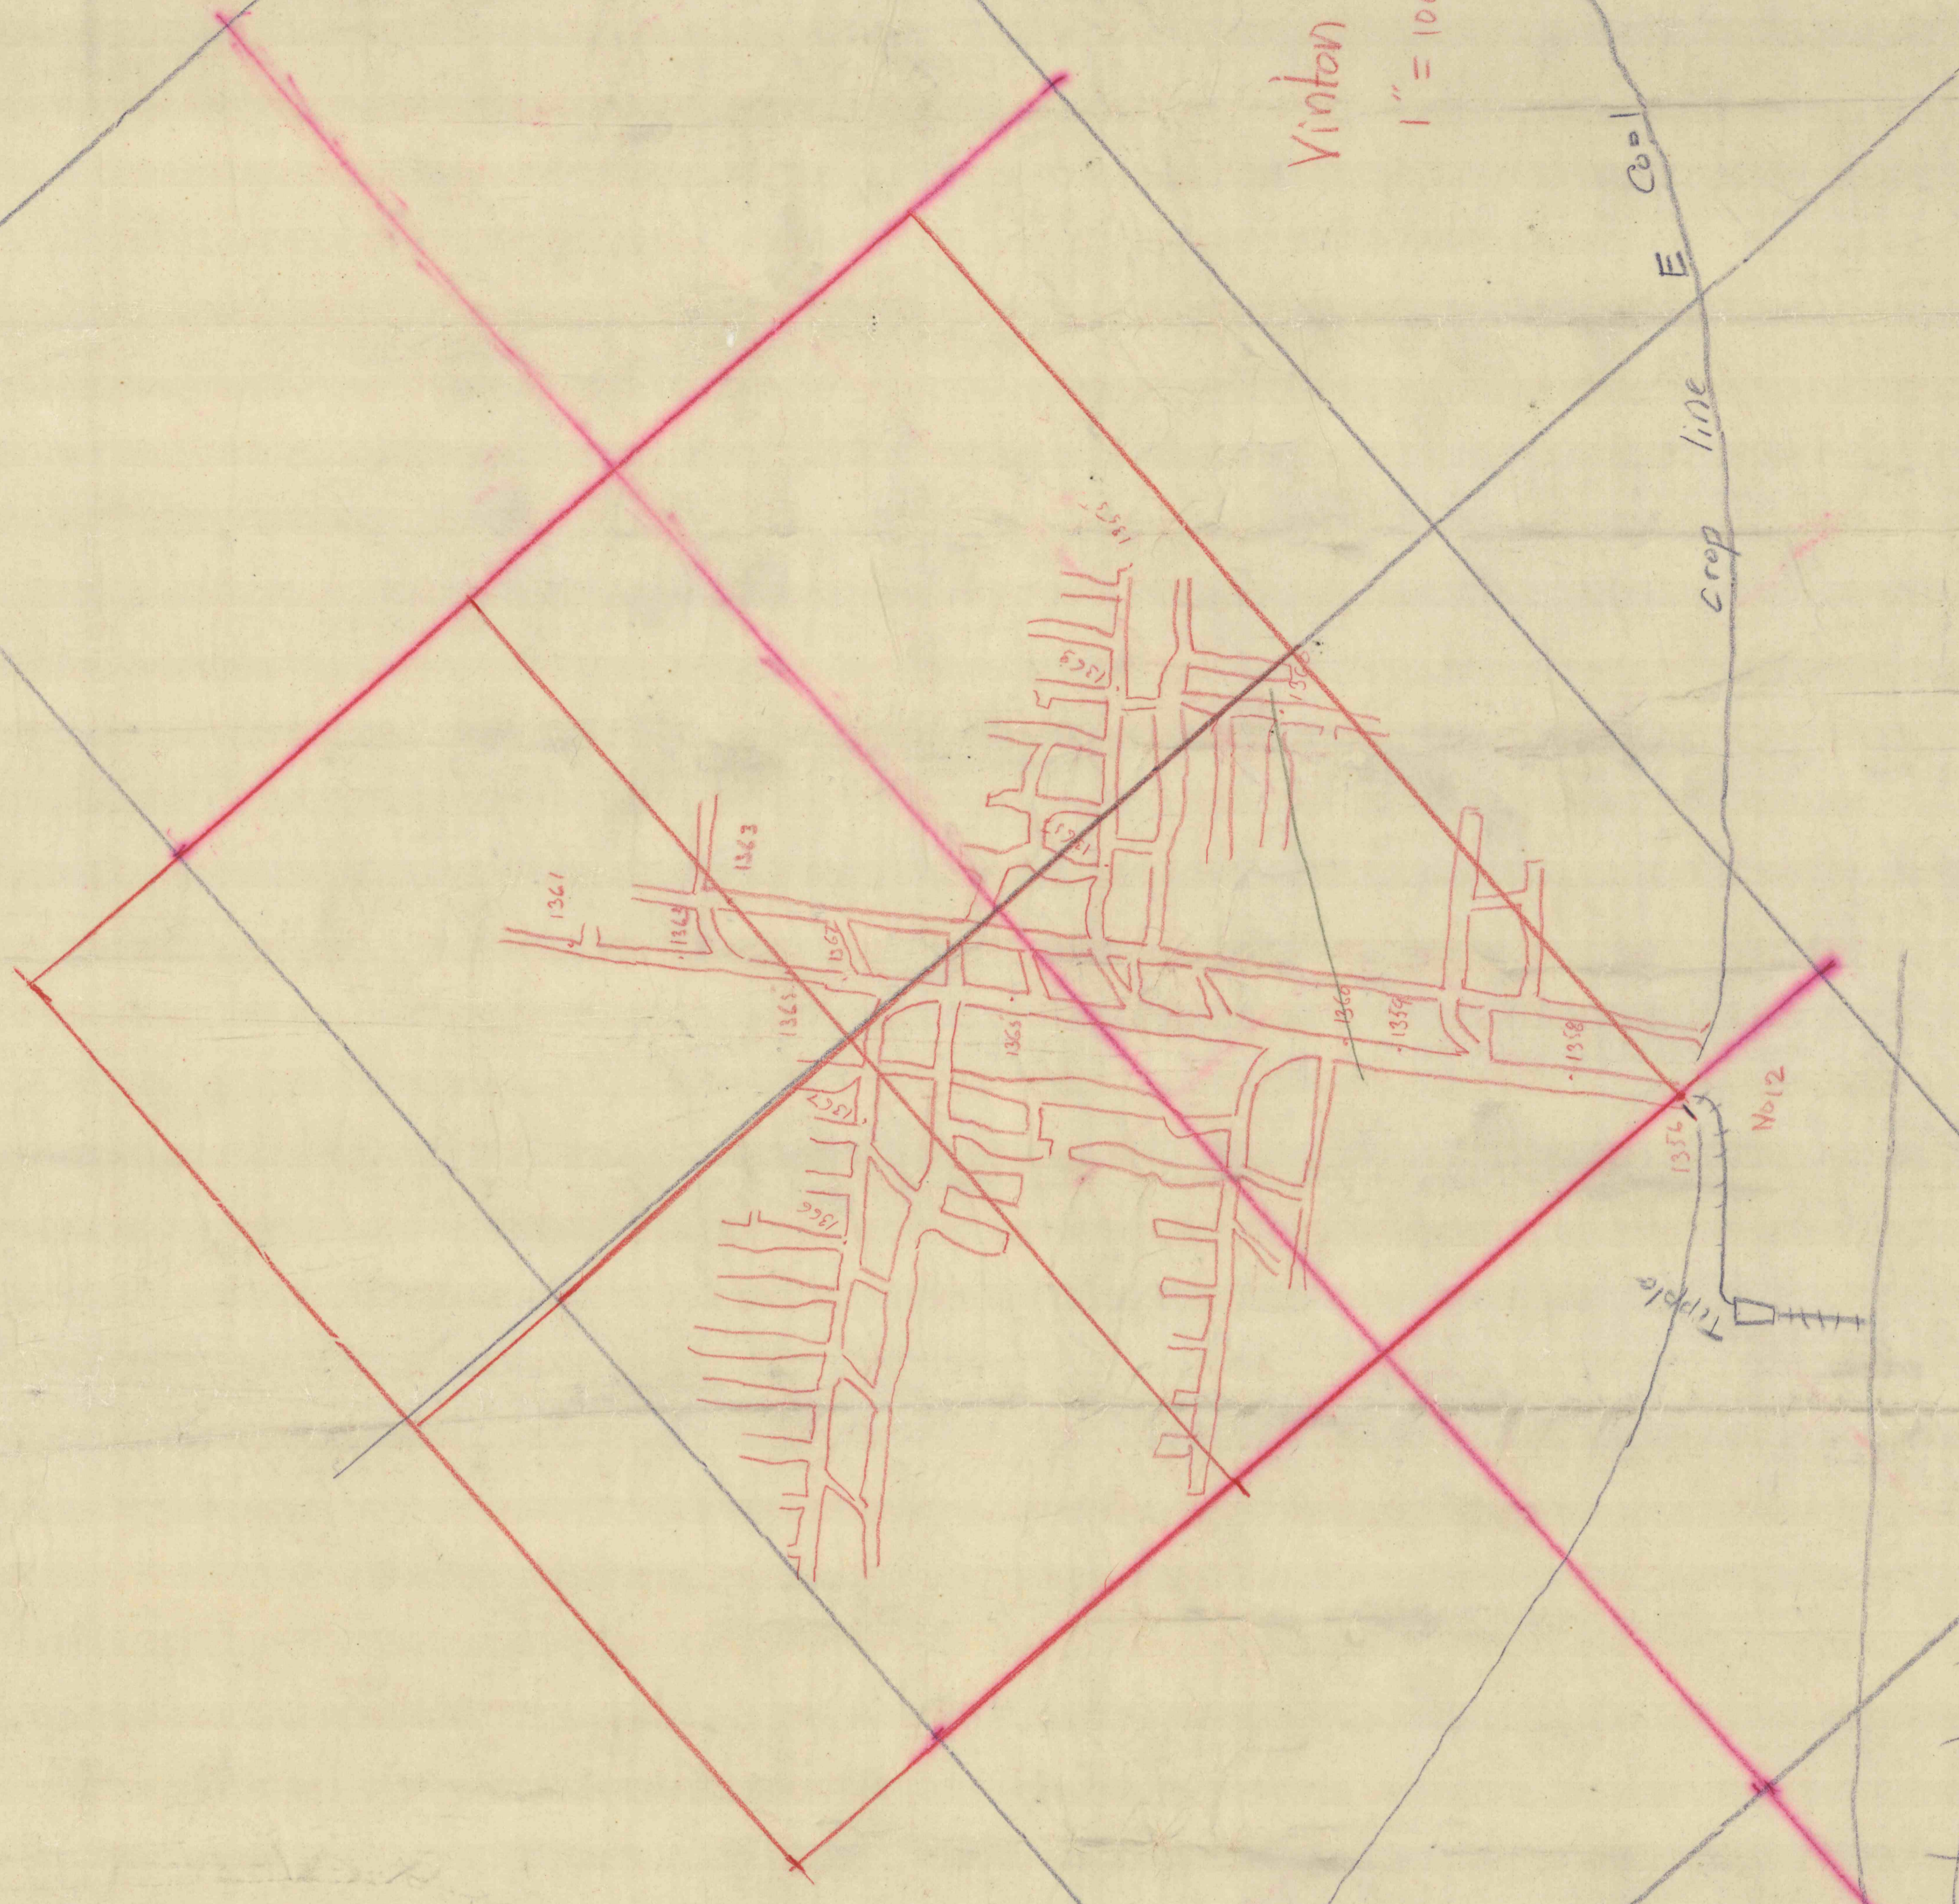

INDIANA

Vinton No 15