


Vinton #16
Indiana Co
New Florence Q

1"=100'

O.D. Hole 14
S148°
C H11.7

Virginia 14
Elkins Mine?

Match line

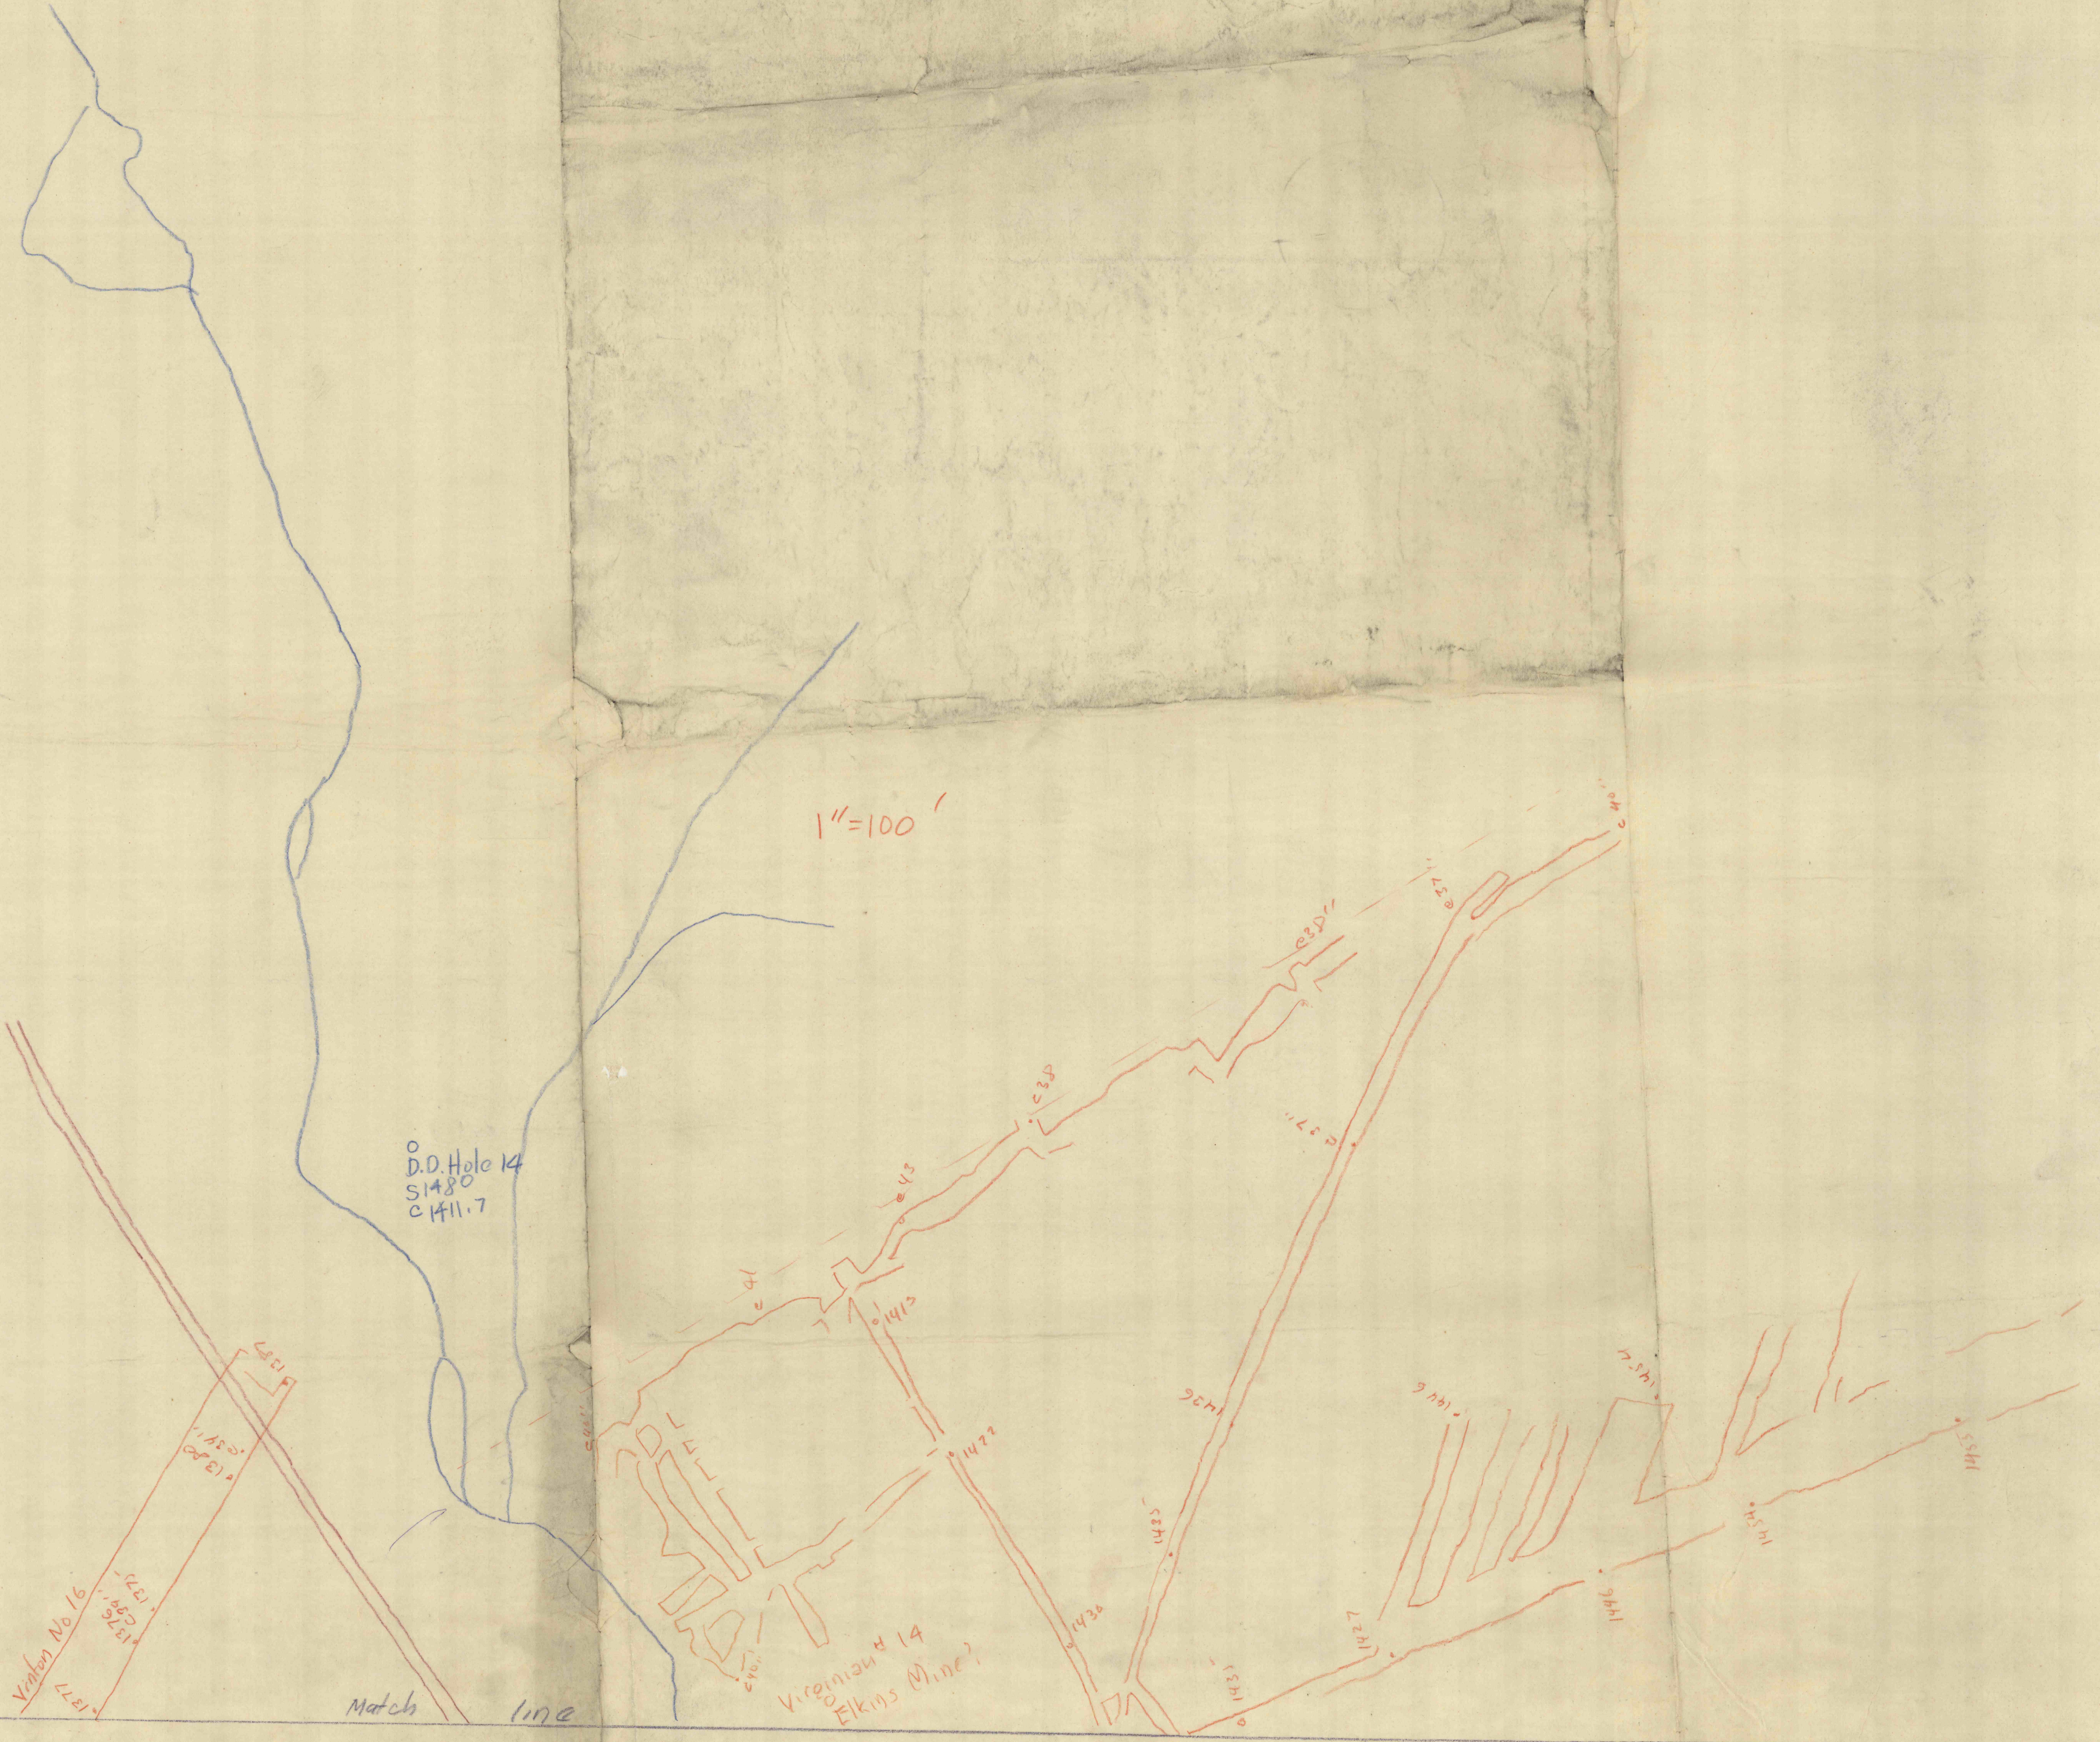

Vinton No 16

304155