



HUTZEL GC D12

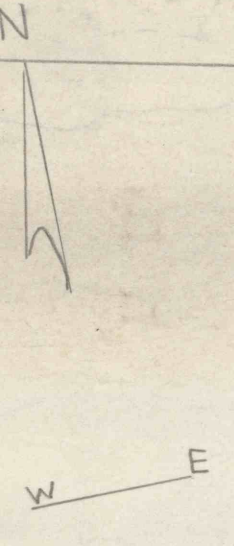

Operated By Zucco Bros.
HUTZEL COAL CO.
EAST WHEATFIELD TWP
INDIANA COUNTY, PA
BY HAVEMIKES ULRICH
SCALE 1" = 100'

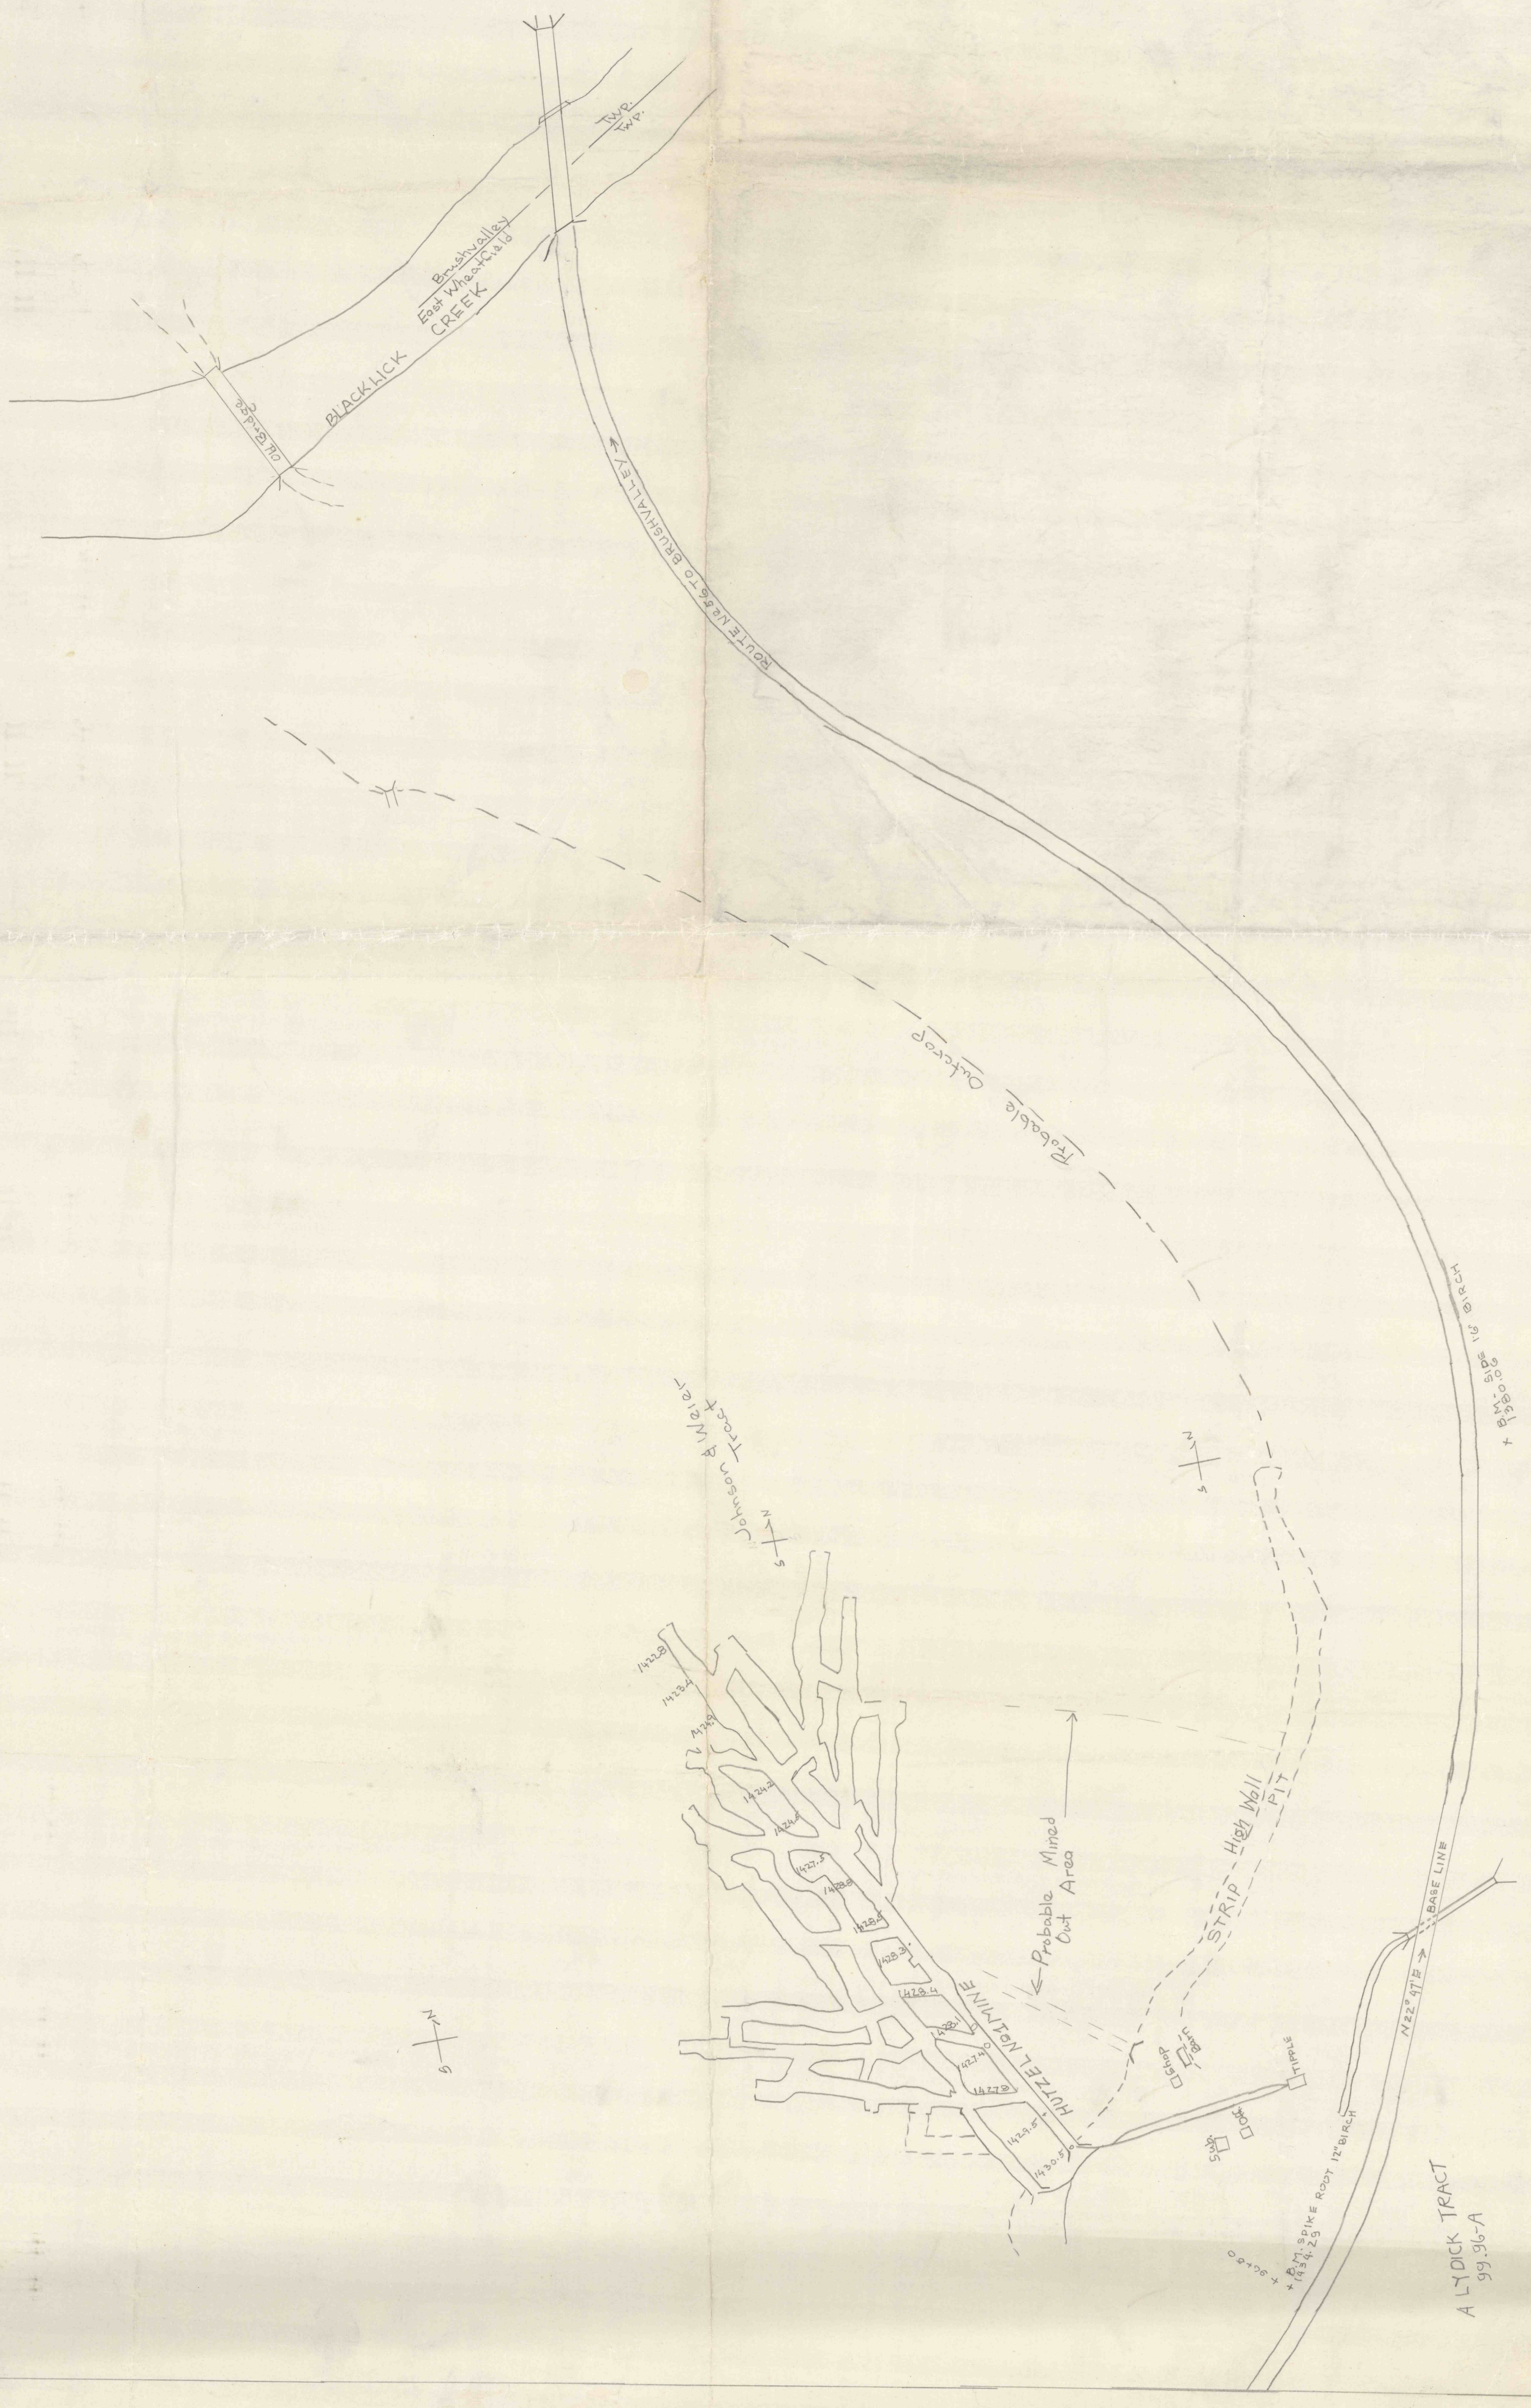

951402

100 000000