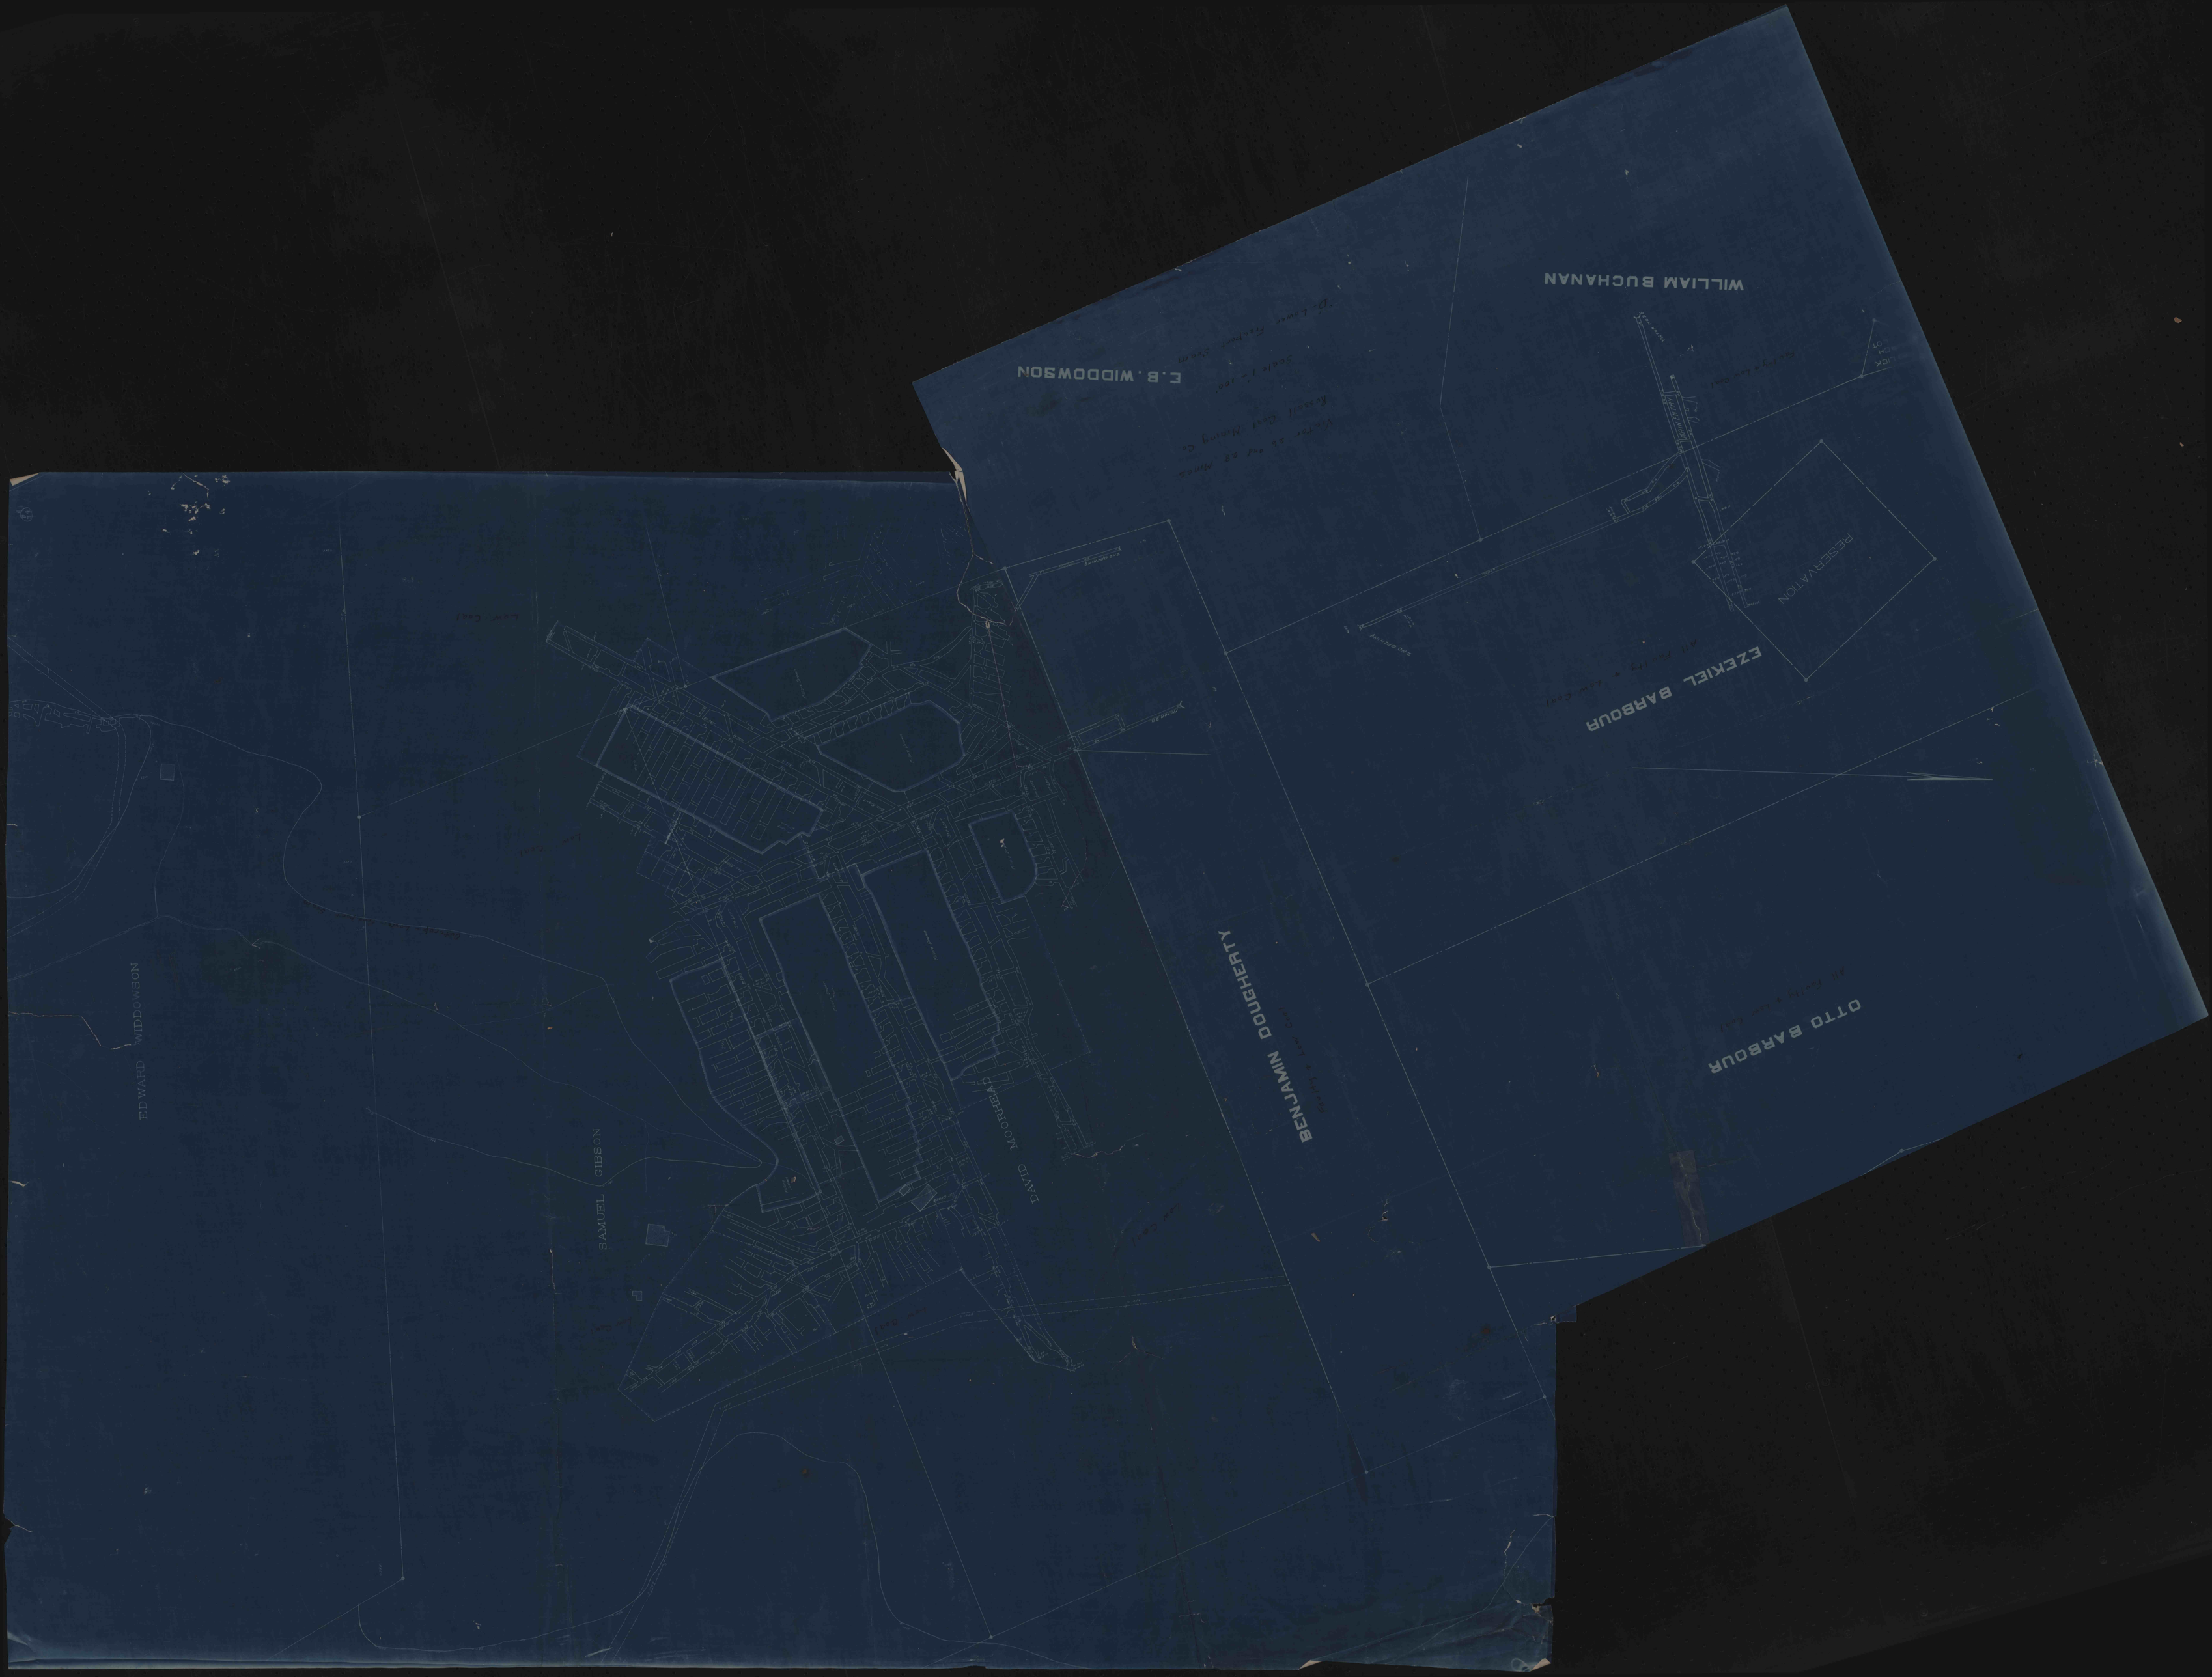
WILLIAM BUCHANAN
E.B. WIDDOWSON
RESERVATION
EZEKIEL BARBOUR
BENJAMIN DOUGHERTY
OTTO BARBOUR
DAVID MOORHEAD
SAMUEL GIBSON
EDWARD WIDDOWSON