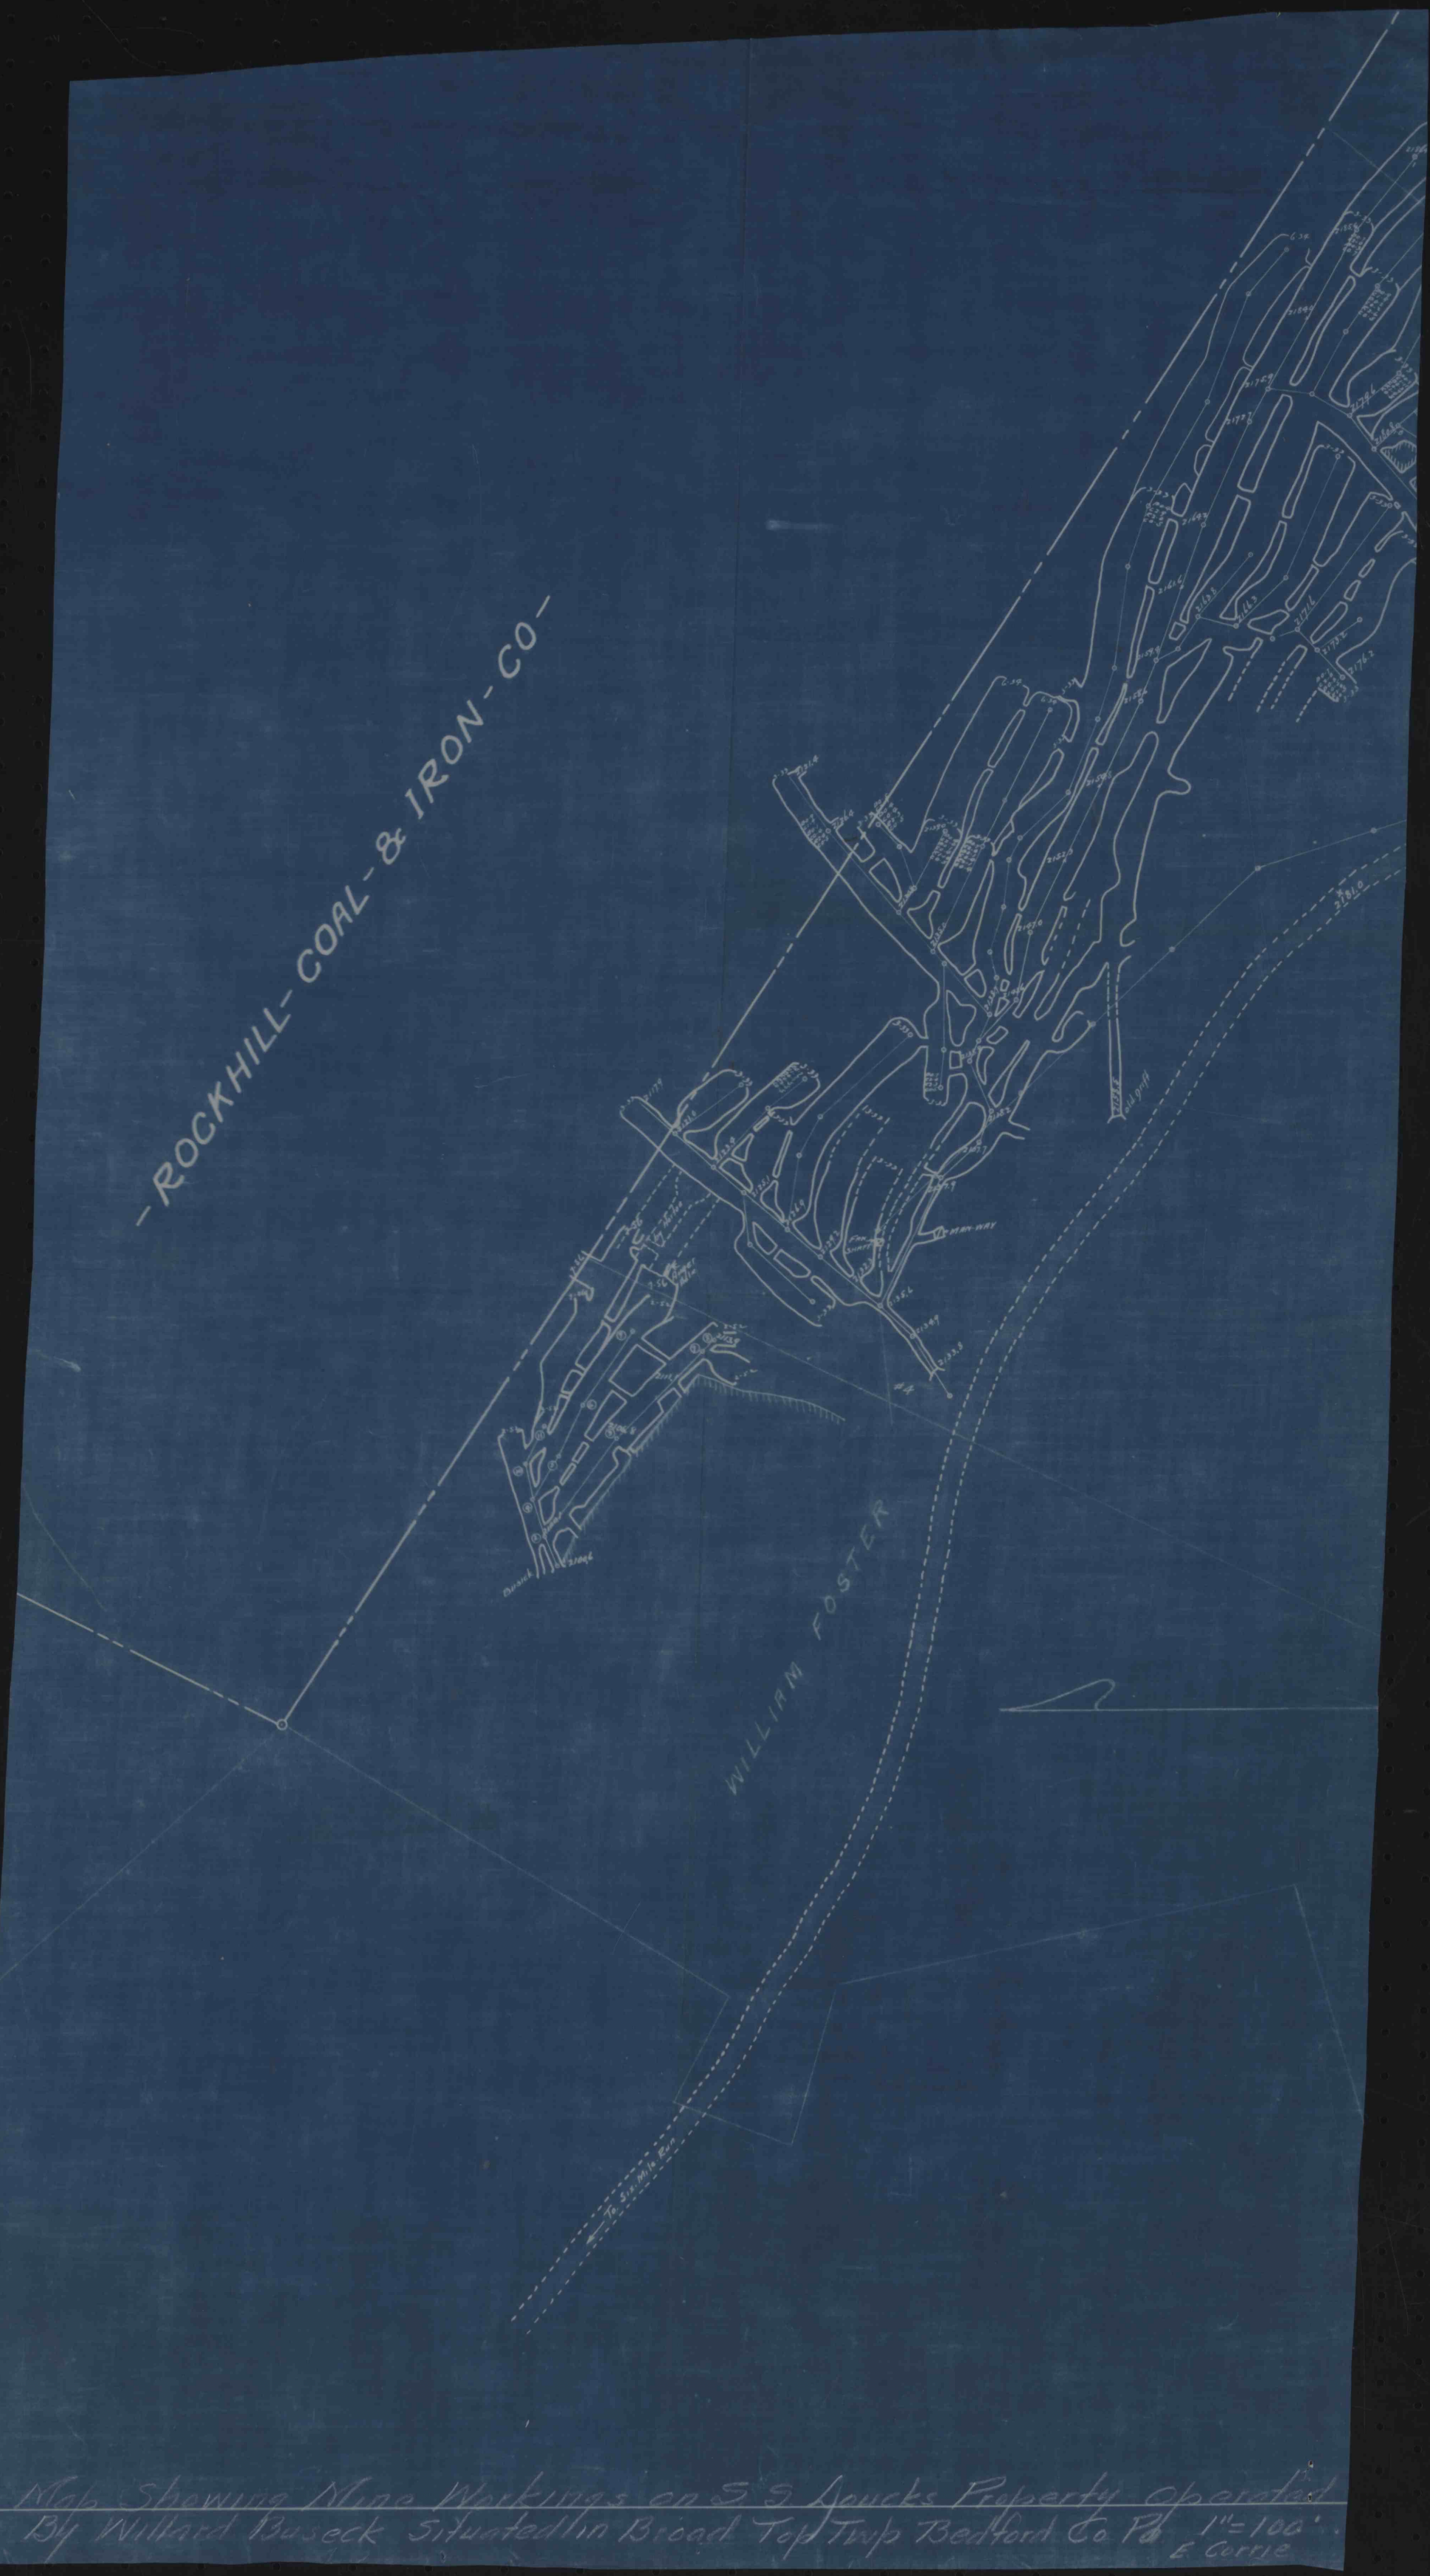

Map Showing Mine Workings on S. S. Soucks Property Operated By Willard Buseck Situated in Broad Top Twp Bedford Co Pa 1"=100'.