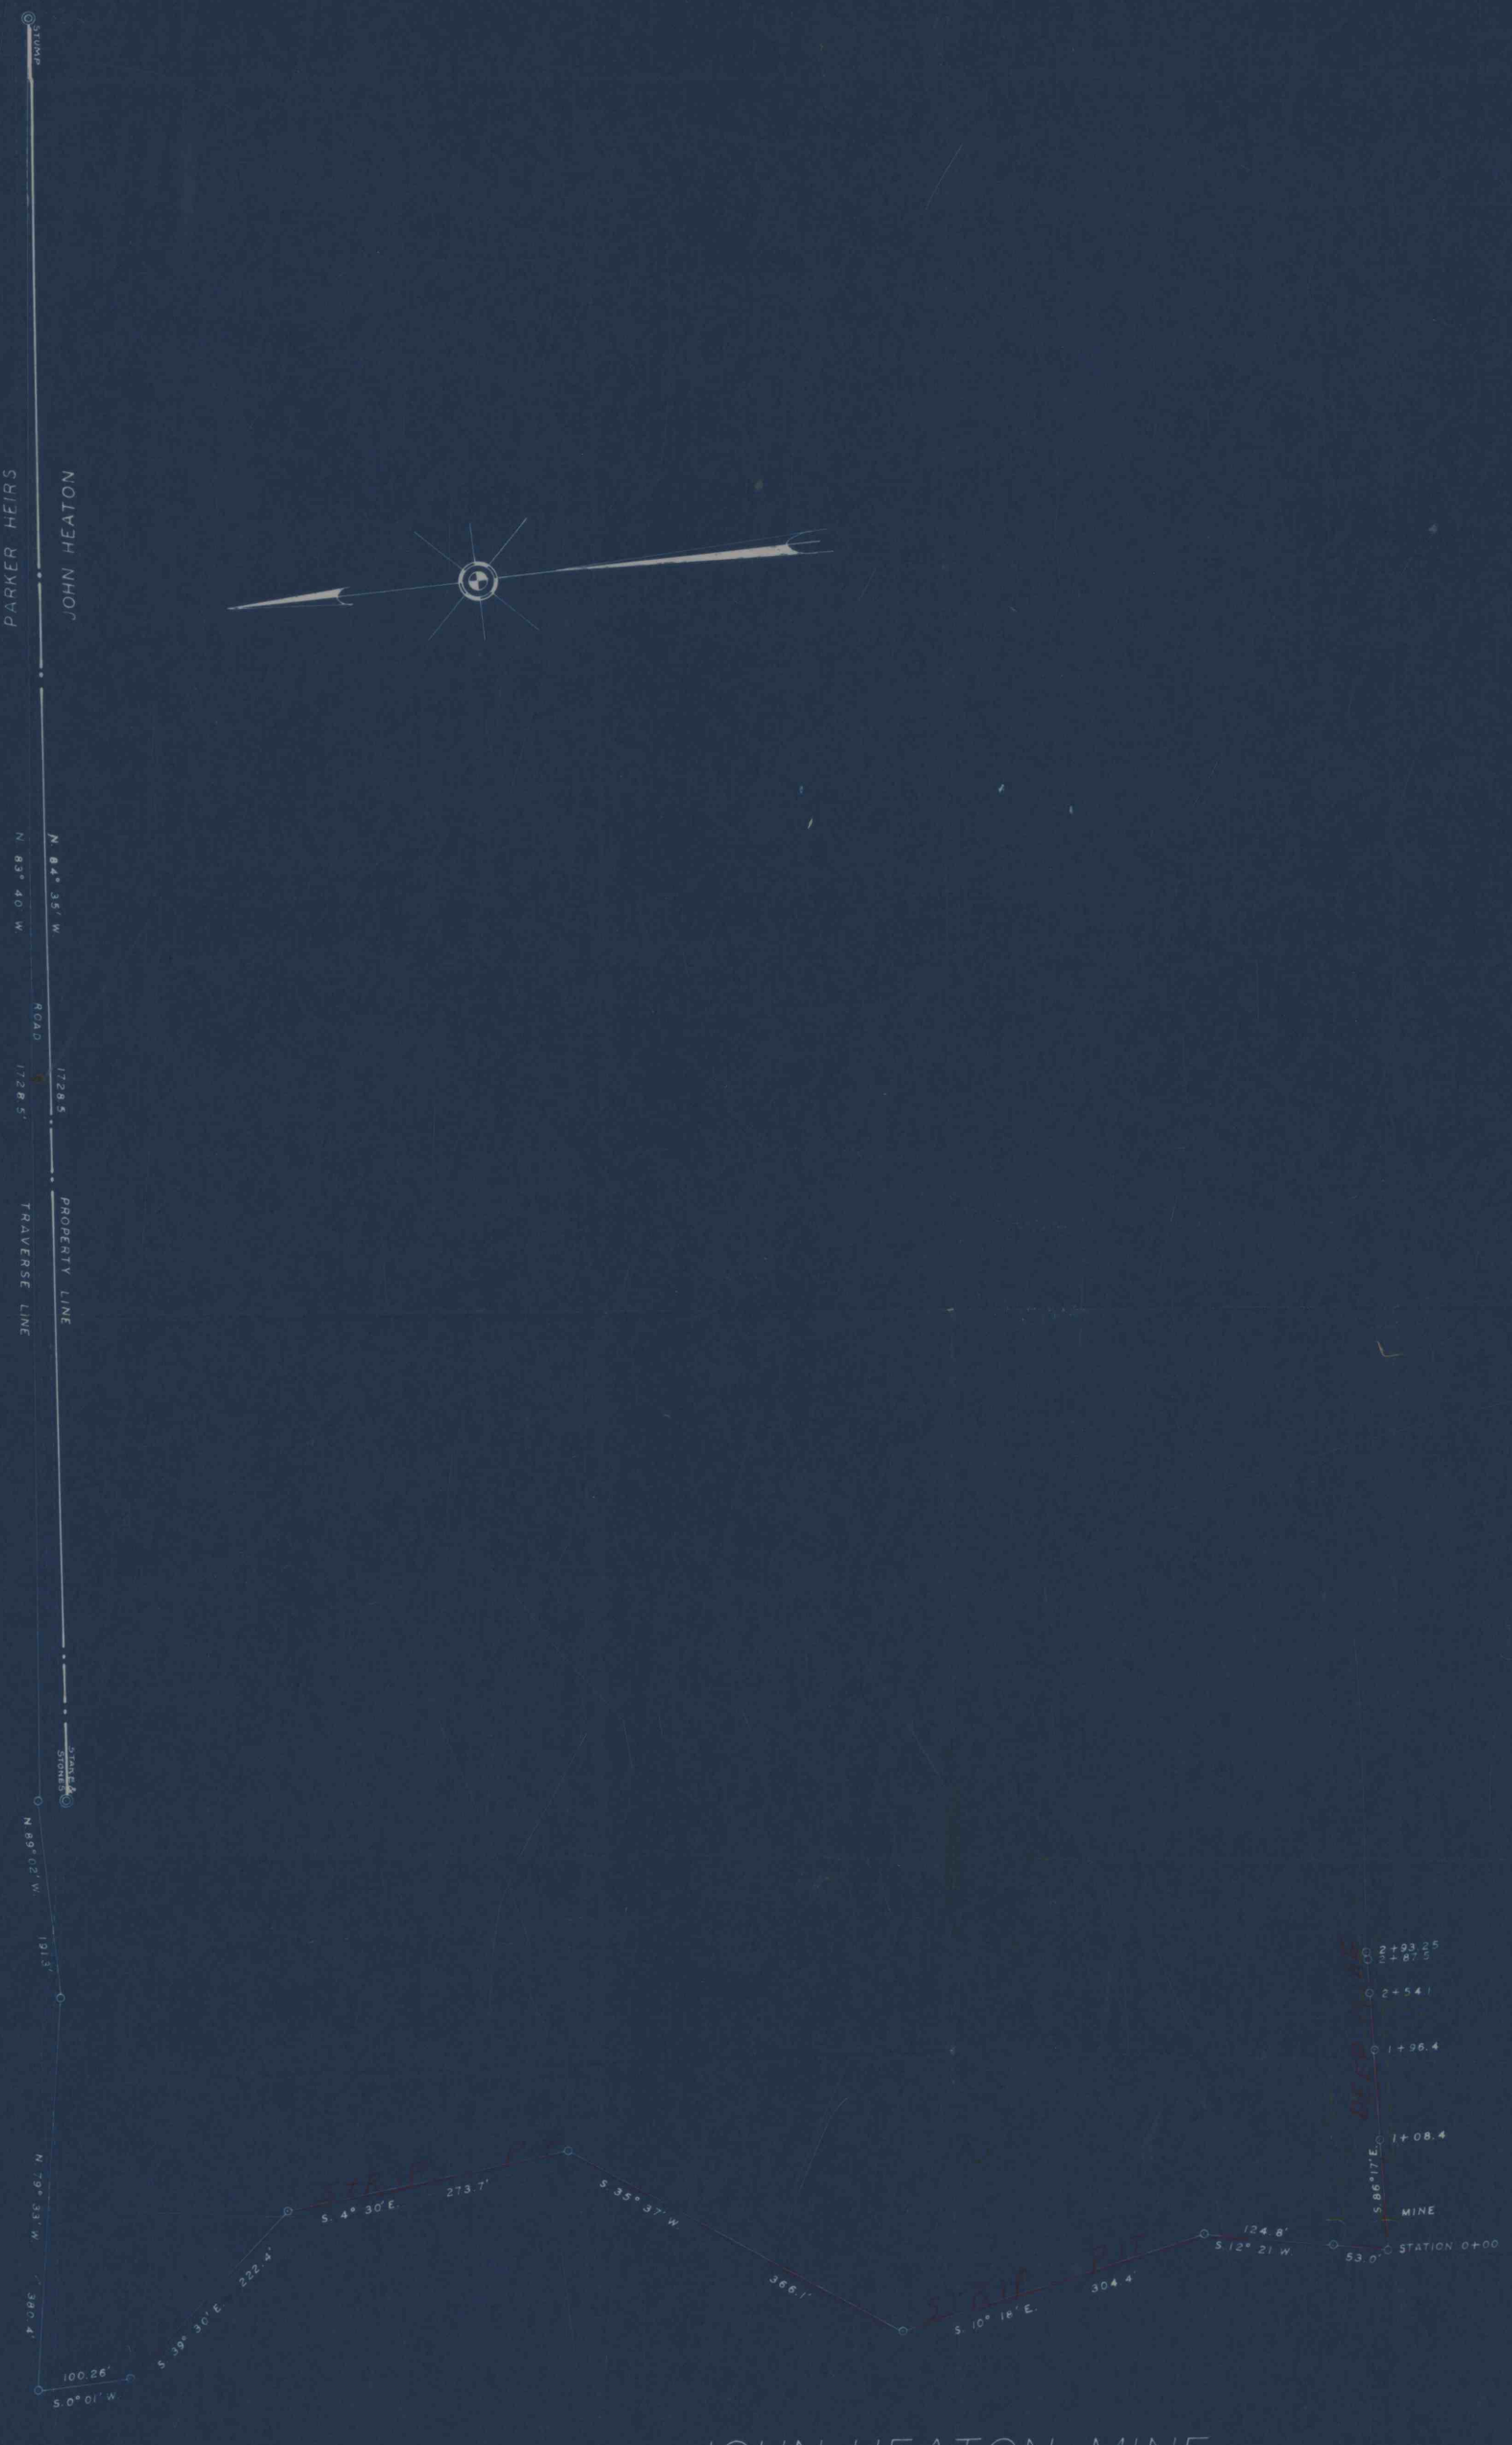

JOHN HEATON MINE

BROAD TOP TWP., BEDFORD CO., PENNSYLVANIA

SCALE 1" = 100' SURVEYED 8-9-1955

R. B. BEAM R.P.E.
BEDFORD, PENN.