


CHARLES RUPERT

EMMET BECK

ABANDONED GAS WELL

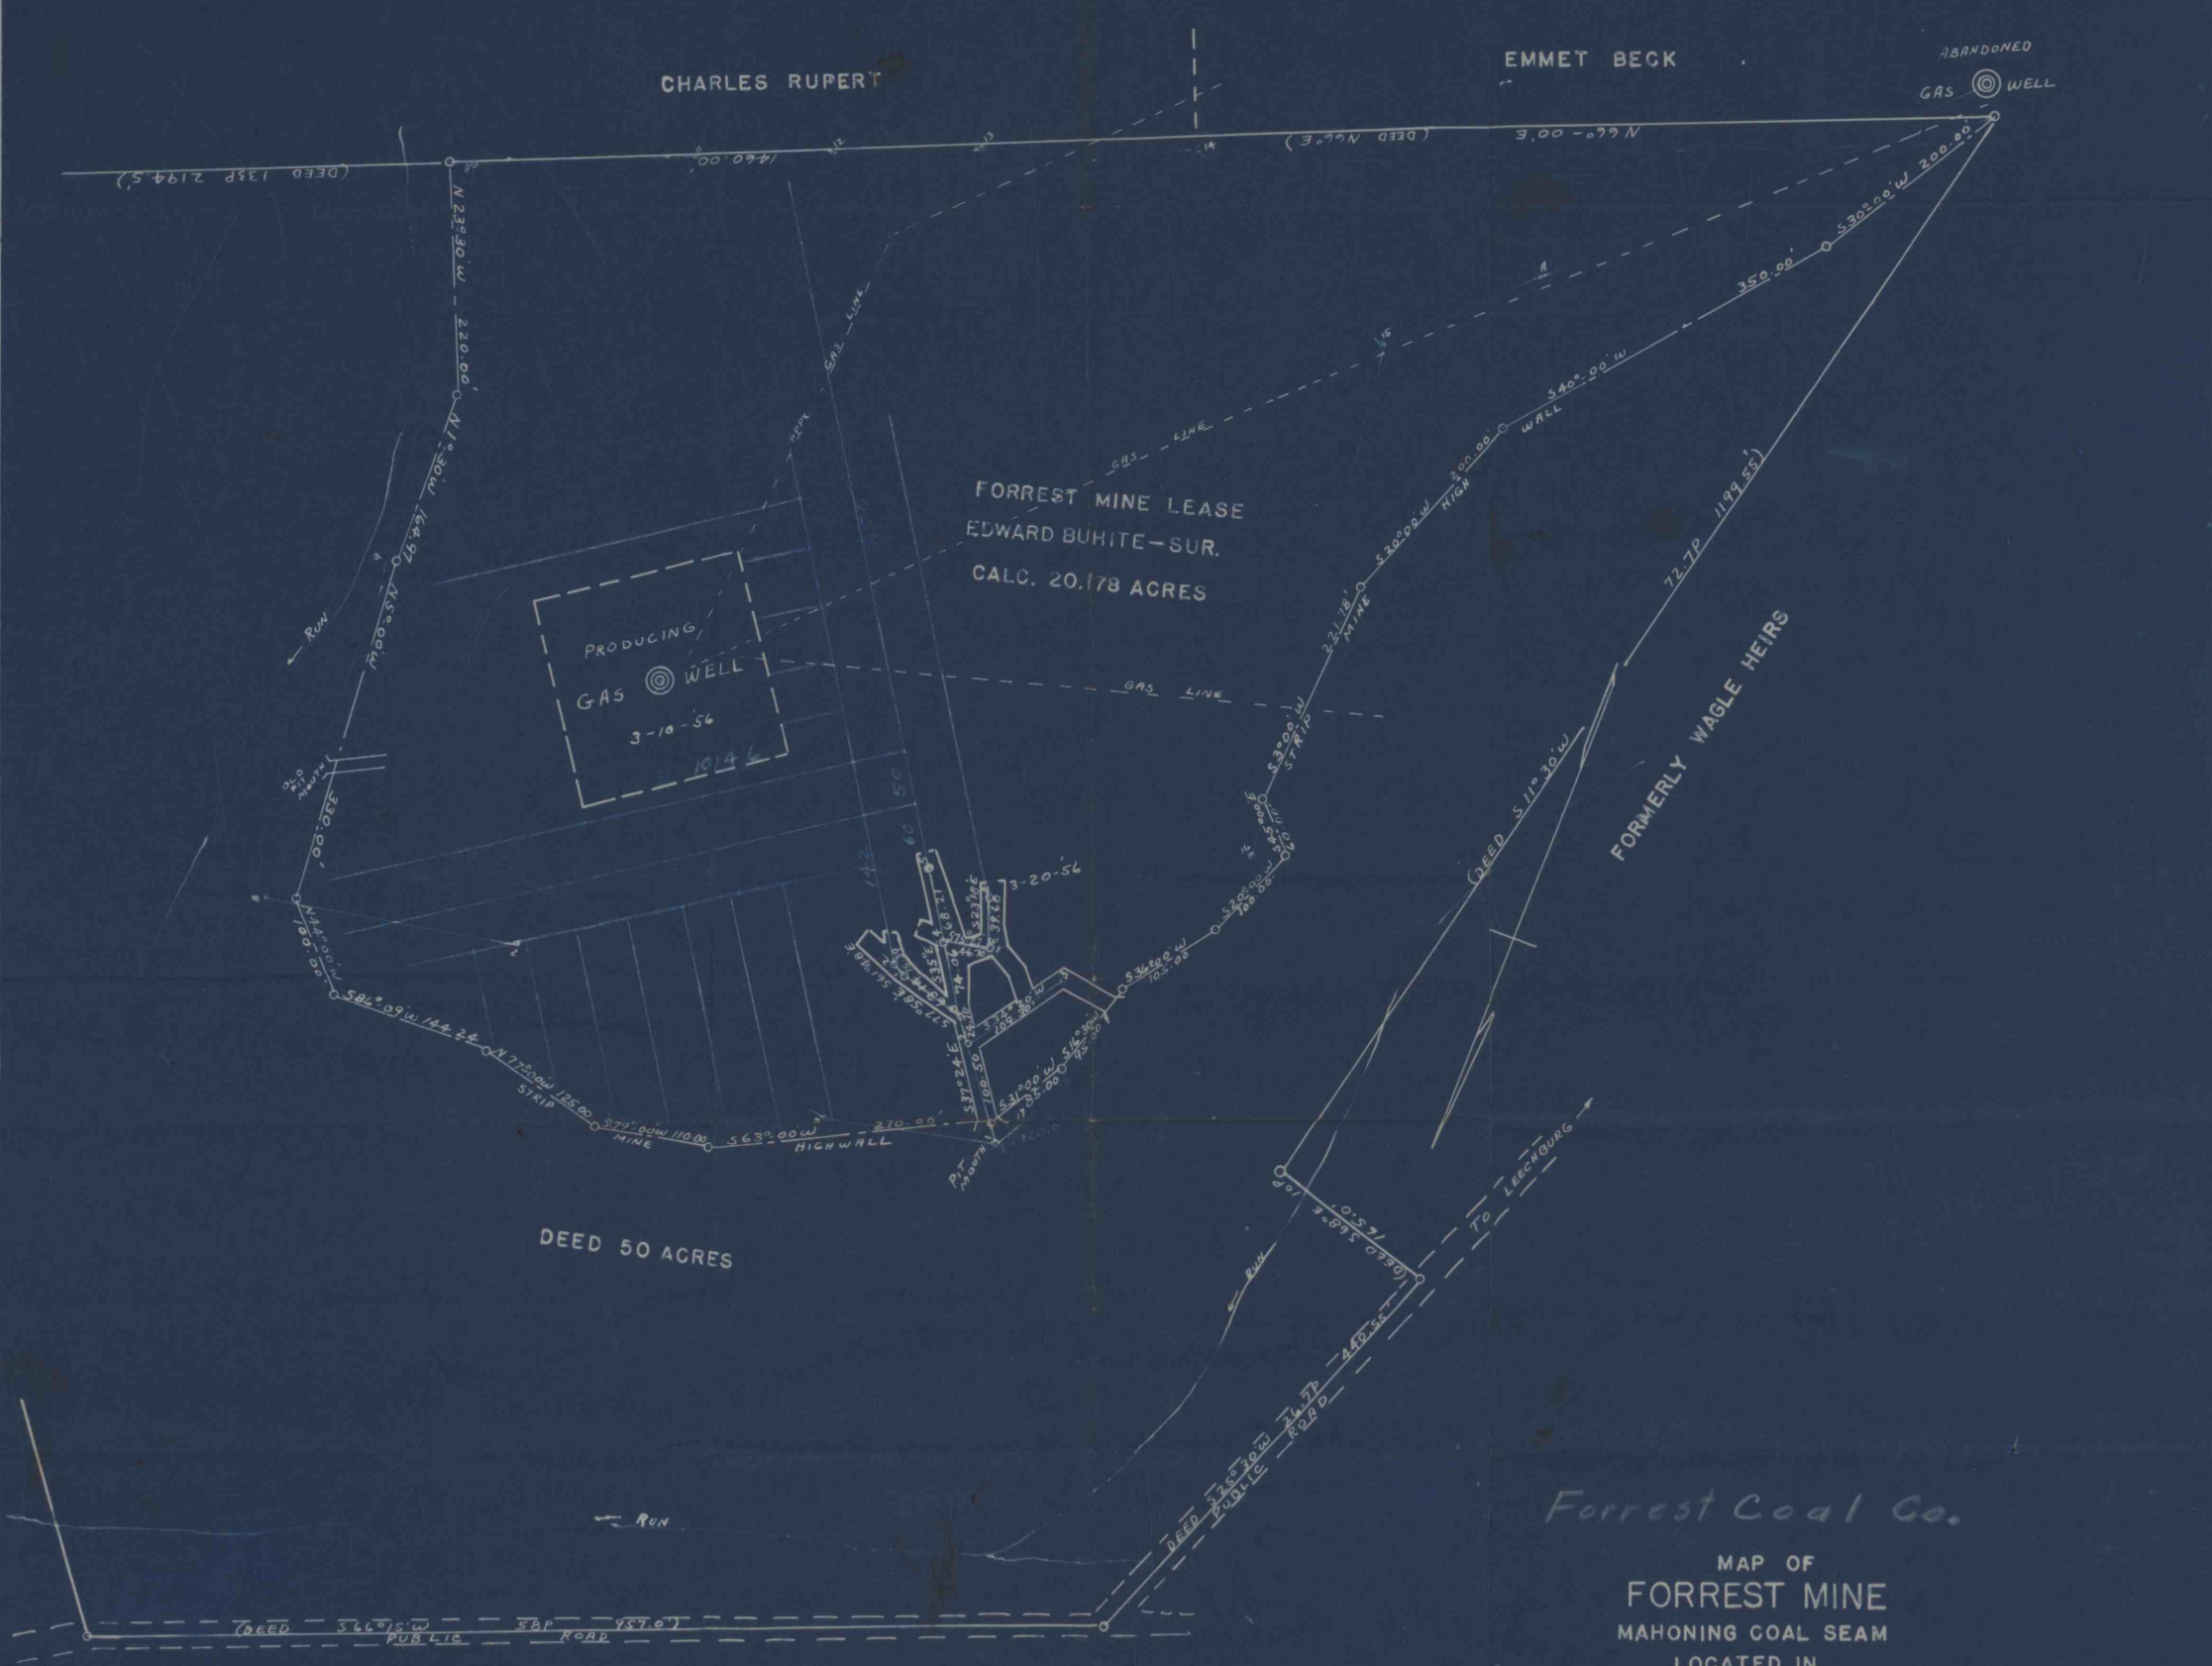

Forrest Coal Co.

MAP OF
FORREST MINE
 MAHONING COAL SEAM
 LOCATED IN

BURRELL TWP. - ARMSTRONG CO. - PENNA. *Dist 2*
 SCALE 1 INCH = 100 FEET - MARCH 10, 1956
 CHARLES S. KLINGENSMITH - R.P.S. 2 28 E
 LEECHBURG, PENNA.

