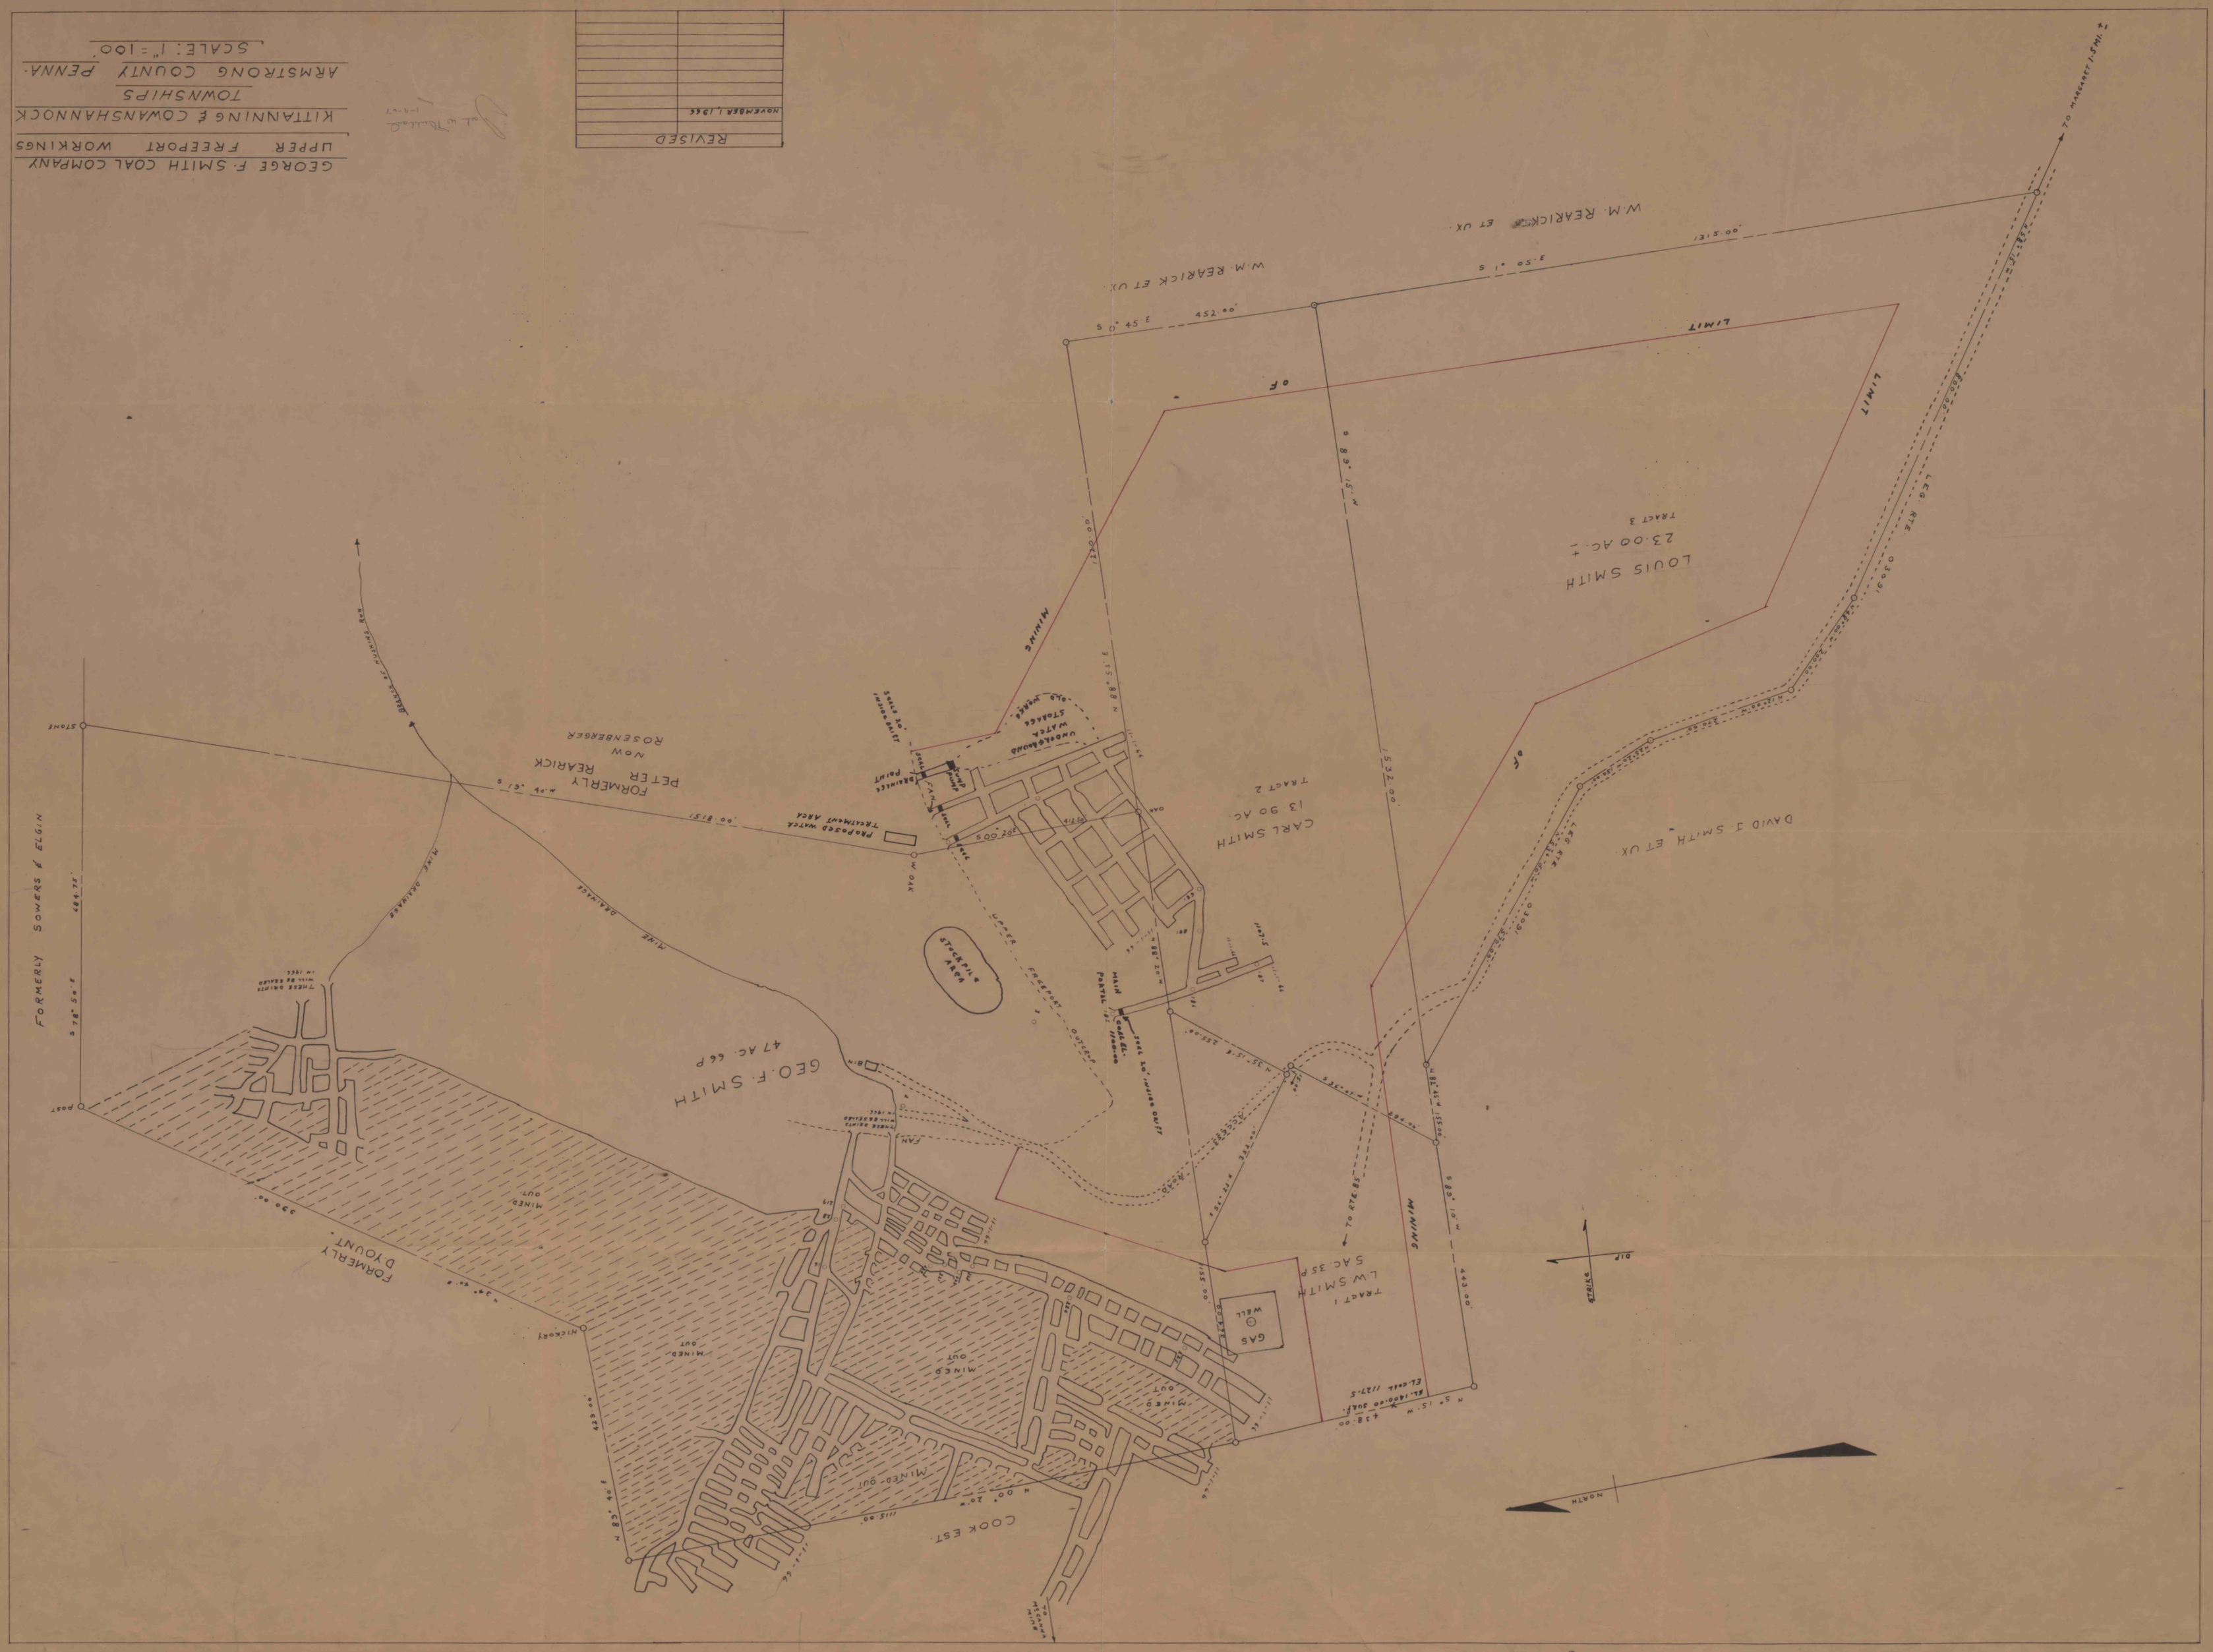
GEORGE F. SMITH COAL COMPANY
UPPER FREEPORT WORKINGS
KITTANNING & COWANSHANNOCK
TOWNSHIPS
ARMSTRONG COUNTY PENNA.
SCALE: 1" = 100'
REVISED
NOVEMBER 1, 1966
TO MARGARET 1.5 MI. ±
LEG RTE 0301
LOUIS SMITH
23.00 AC. ±
TRACT 3
W.M. REARICK ET UX.
W.M. REARICK ET UX.
S 0° 45' E 452.00'
S 3° 50' 1' S
1315.00'
S 88° 15' W
1532.00'
MINING
LIMIT
OF
CARL SMITH
13.30 AC
TRACT 2
DAVID J. SMITH ET UX.
FORMERLY PETER REARICK
NOW ROSENBERGER
PROPOSED WATER TREATMENT AREA
UNDERGROUND WATER STORAGE
OLD WORKS
DRAINAGE POINT
STOCKPILE AREA
LARGE FREEPORT OUTCROP
MAIN PORTAL
FORMERLY SOWERS & ELGIN
S 78° 50' E
684.75'
MINE DRAINAGE
THESE DRAINS MUST BE SEALED IN 1966.
GEO. F. SMITH
47 AC. 66 P
MINED OUT
FORMERLY D. YOUNT
330.00'
N 34° 40' W
N 68° 20' W
1115.00'
COOK EST.
TO RTE 85
TRACT 1
L.W. SMITH
5 AC. 35 P
GAS WELL
N 5° 15' W
438.00'
EL. 1890.00 DUE:
EL. 0.00 1127.5'
S 89° 15' W
1455.00'
N 88° 15' W
1455.00'
STRIKE
DIP
NORTH