


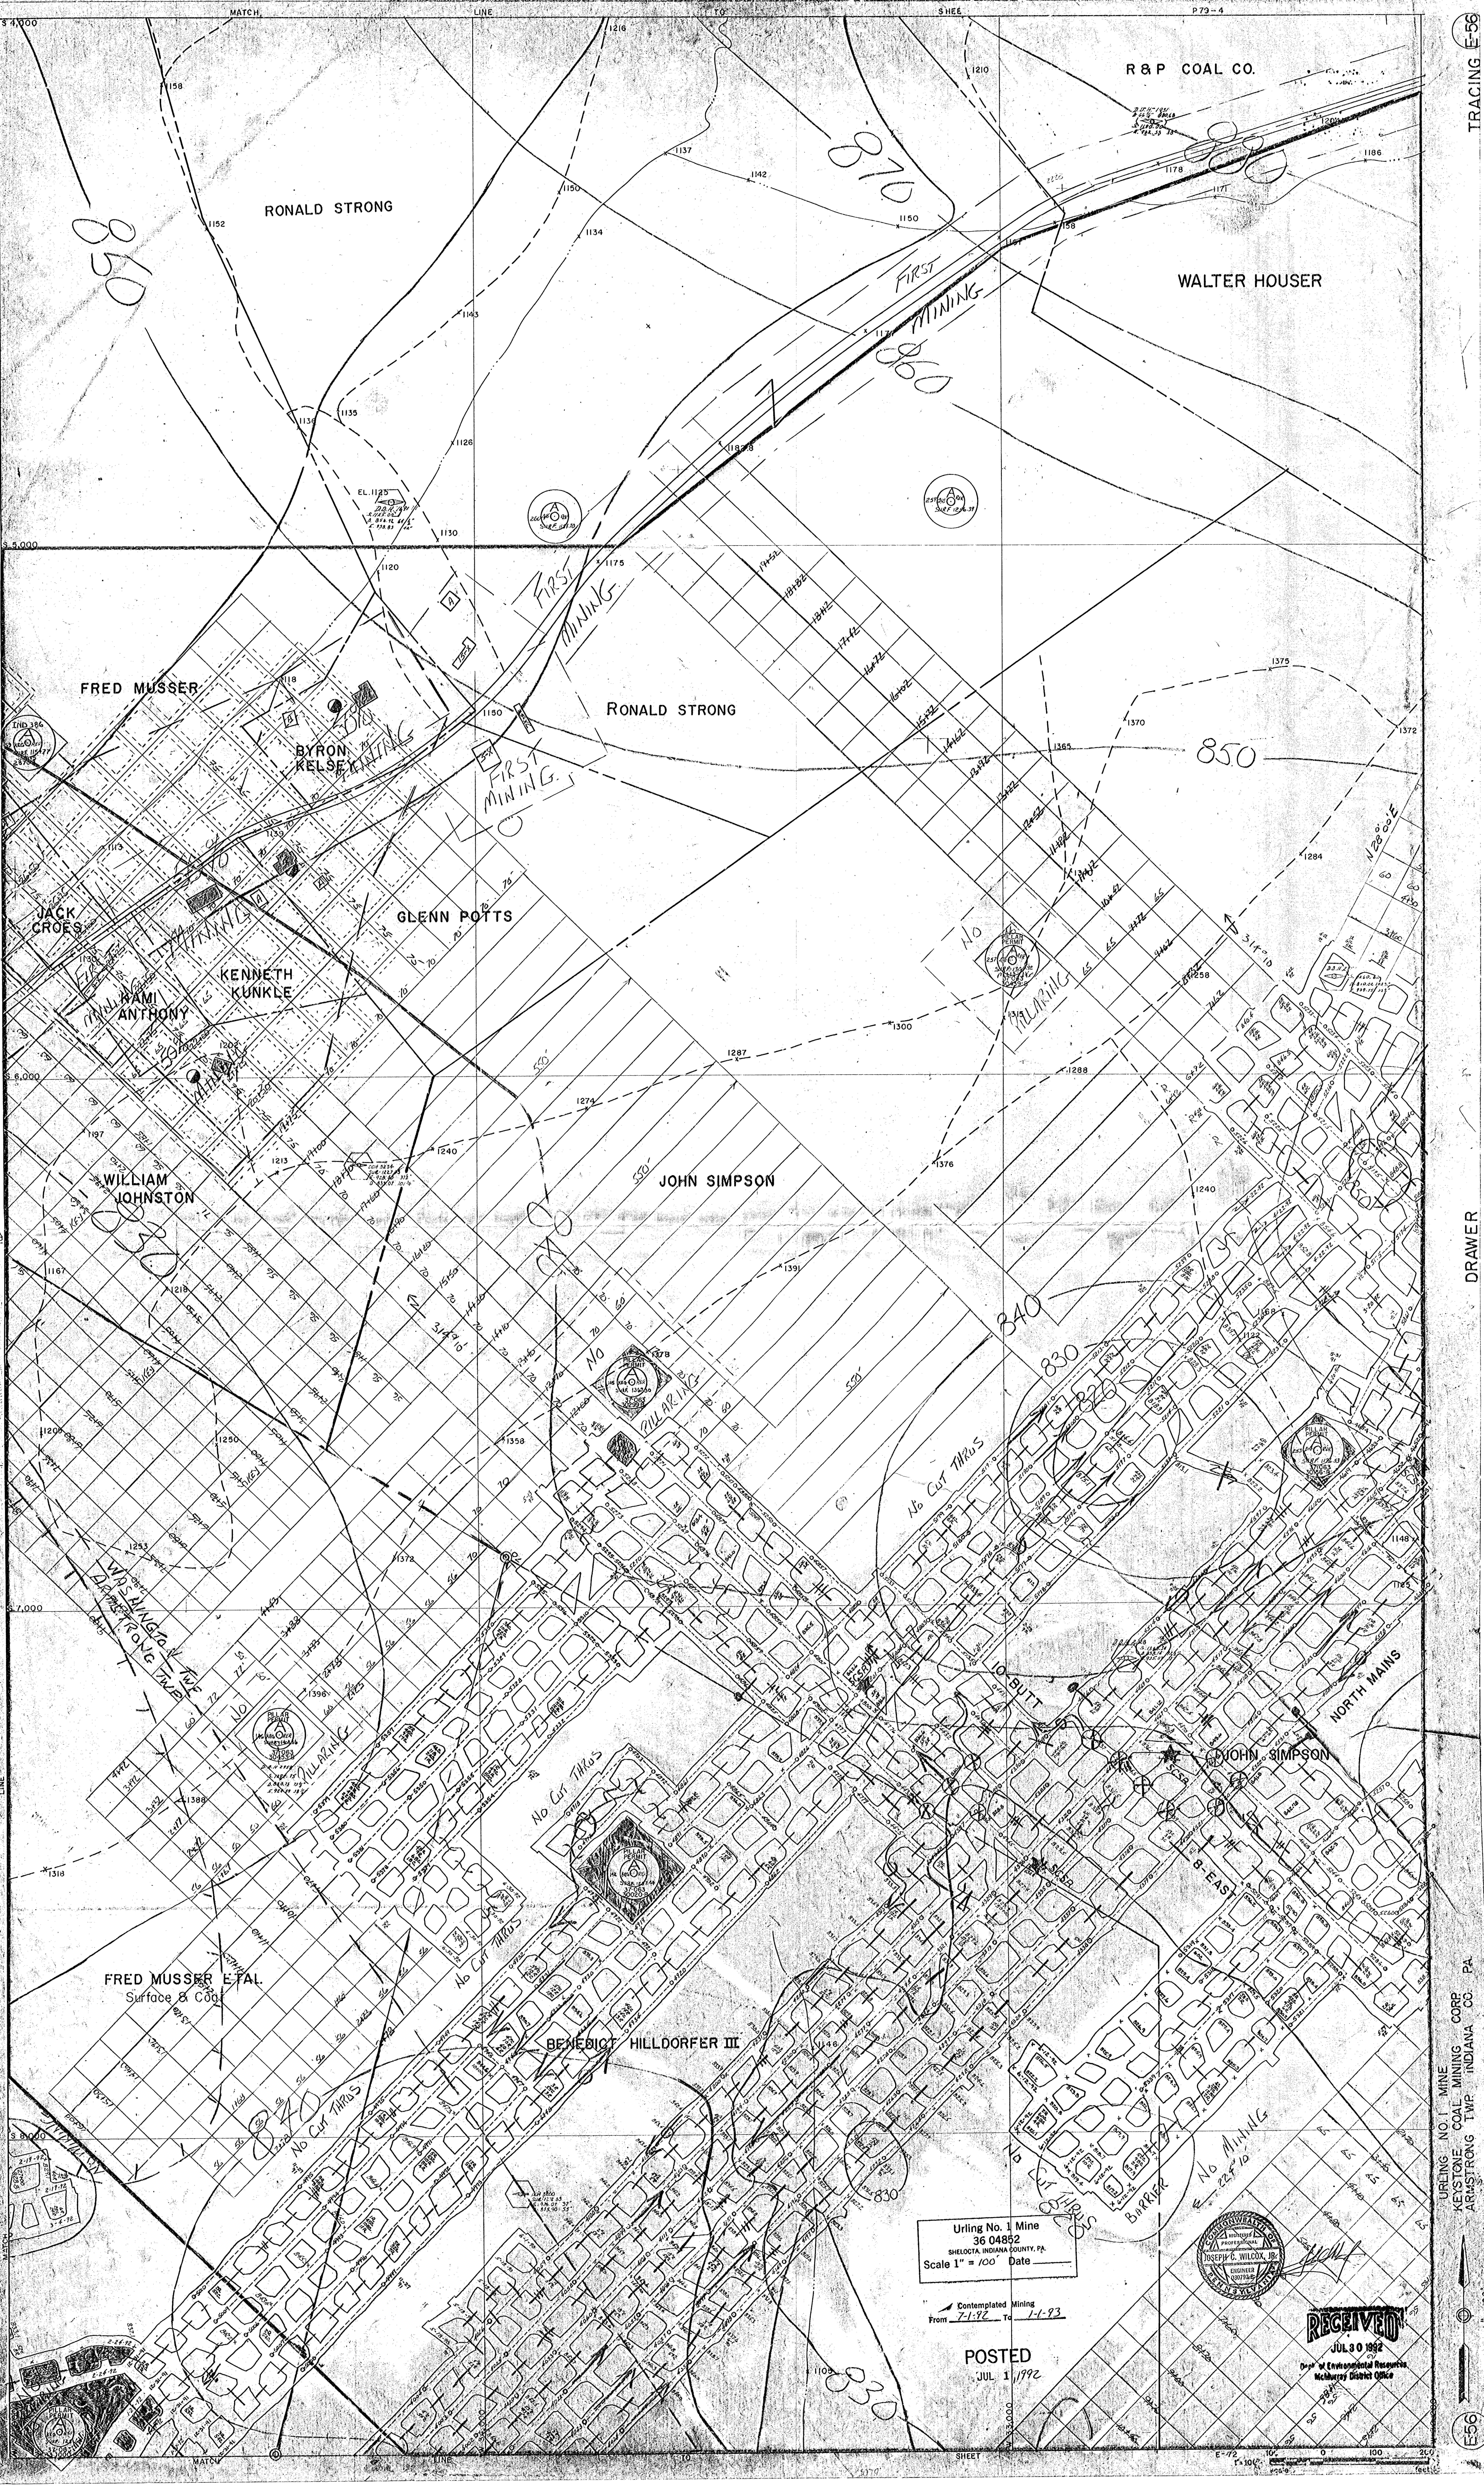

R & P COAL CO.

WALTER HOUSER

RONALD STRONG

RONALD STRONG


JOHN SIMPSON

BENEDICT HILLDORFER III

Urling No. 1 Mine
36 04852
SHELOOTA, INDIANA COUNTY, PA.
Scale 1" = 100' Date

Contemplated Mining
From 7-1-92 To 7-1-93

POSTED
JUL 1 1992

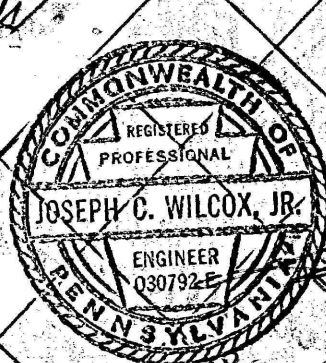

RECEIVED
JUL 30 1992
Department of Environmental Resources
McHenry District Office

TRACING E-56
DRAWER
URLING NO. 1 MINE
KEYSTONE COAL MINING CORP
ARMSTRONG TWP INDIANA CO. PA.