


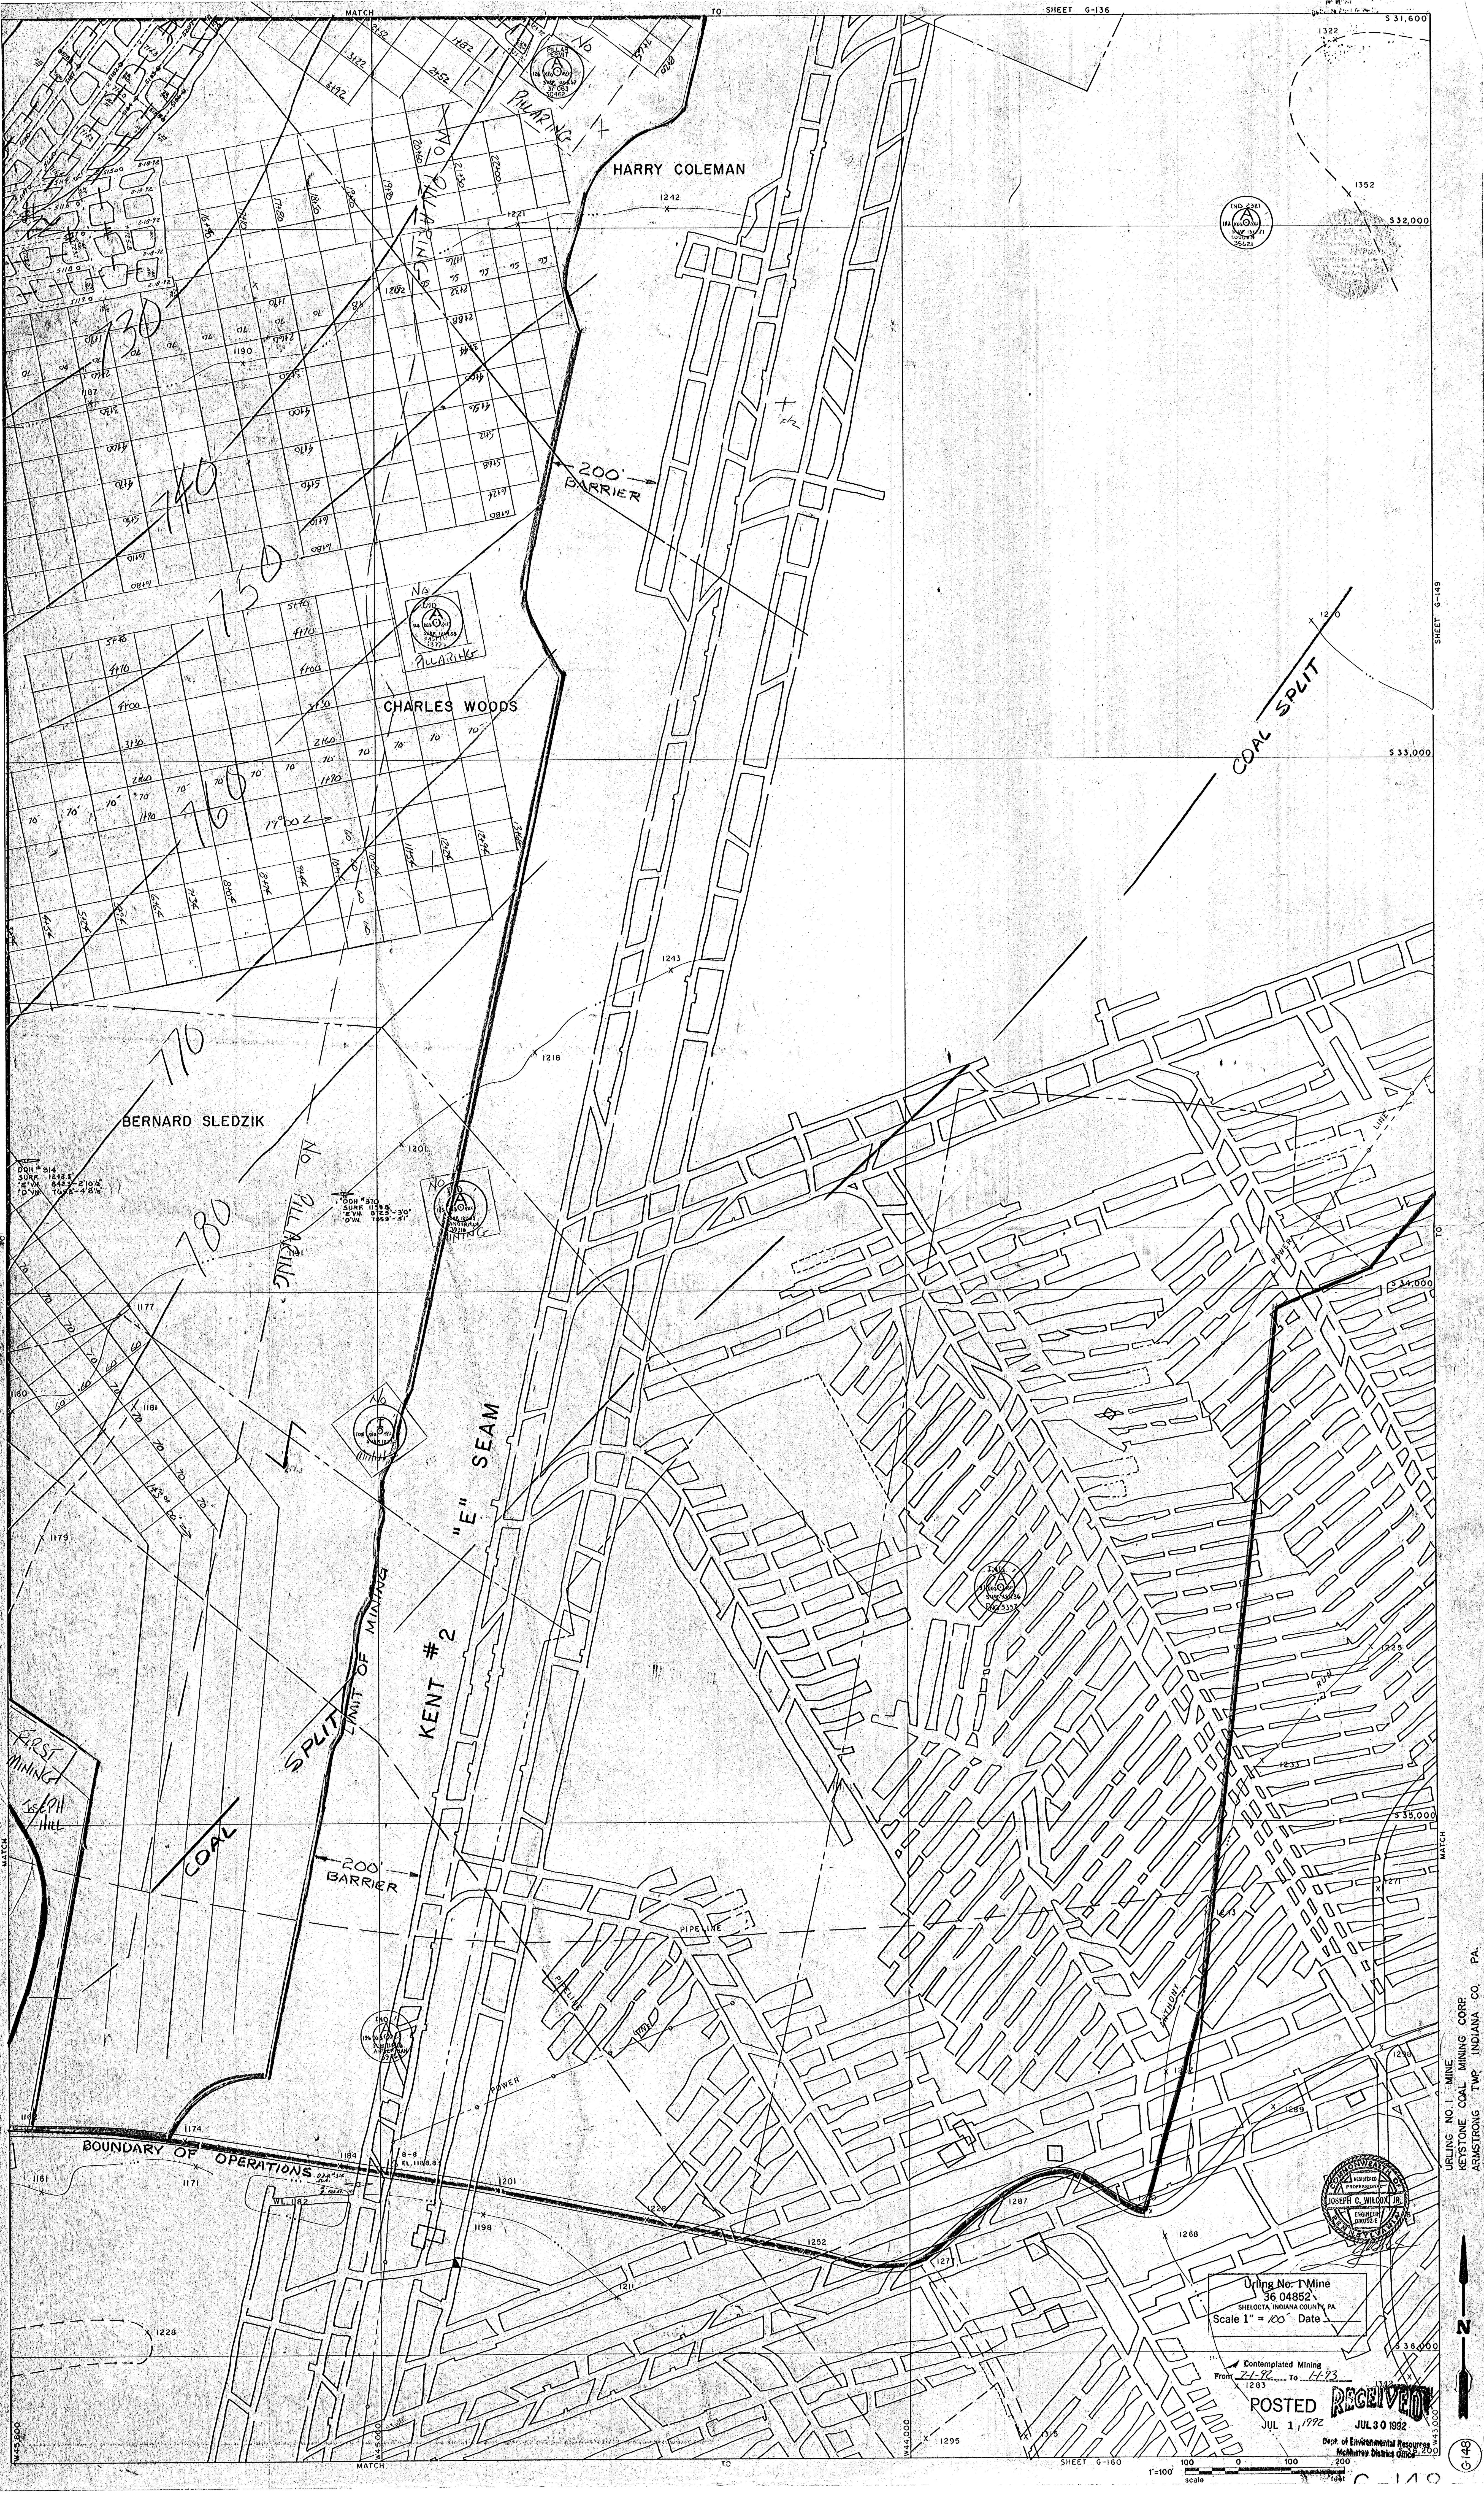

HARRY COLEMAN

CHARLES WOODS

BERNARD SLEDZIK

KENT #2
"E" SEAM

COAL SPLIT

200' BARRIER

PIPE LINE

POWER

BOUNDARY OF OPERATIONS

Urging No. 1 Mine
36 04852
SHELOCTA, INDIANA COUNTY, PA

Contemplated Mining
From 7-1-92 To 7-1-93
From 1283

POSTED RECEIVED
JUL 1 1992 JUL 30 1992
Dept. of Environmental Resources
McIntire District Office

Scale
0 100 200
1" = 100'