


BRIDGEPORT 14

CICCONI AND ANGELO MINE  
REDSTONE TWP, FAYETTE CO., PA.  
SCALE 1"=100' DEC. 1966  
Fayette Engineering Co.  
Uniontown, Pa.

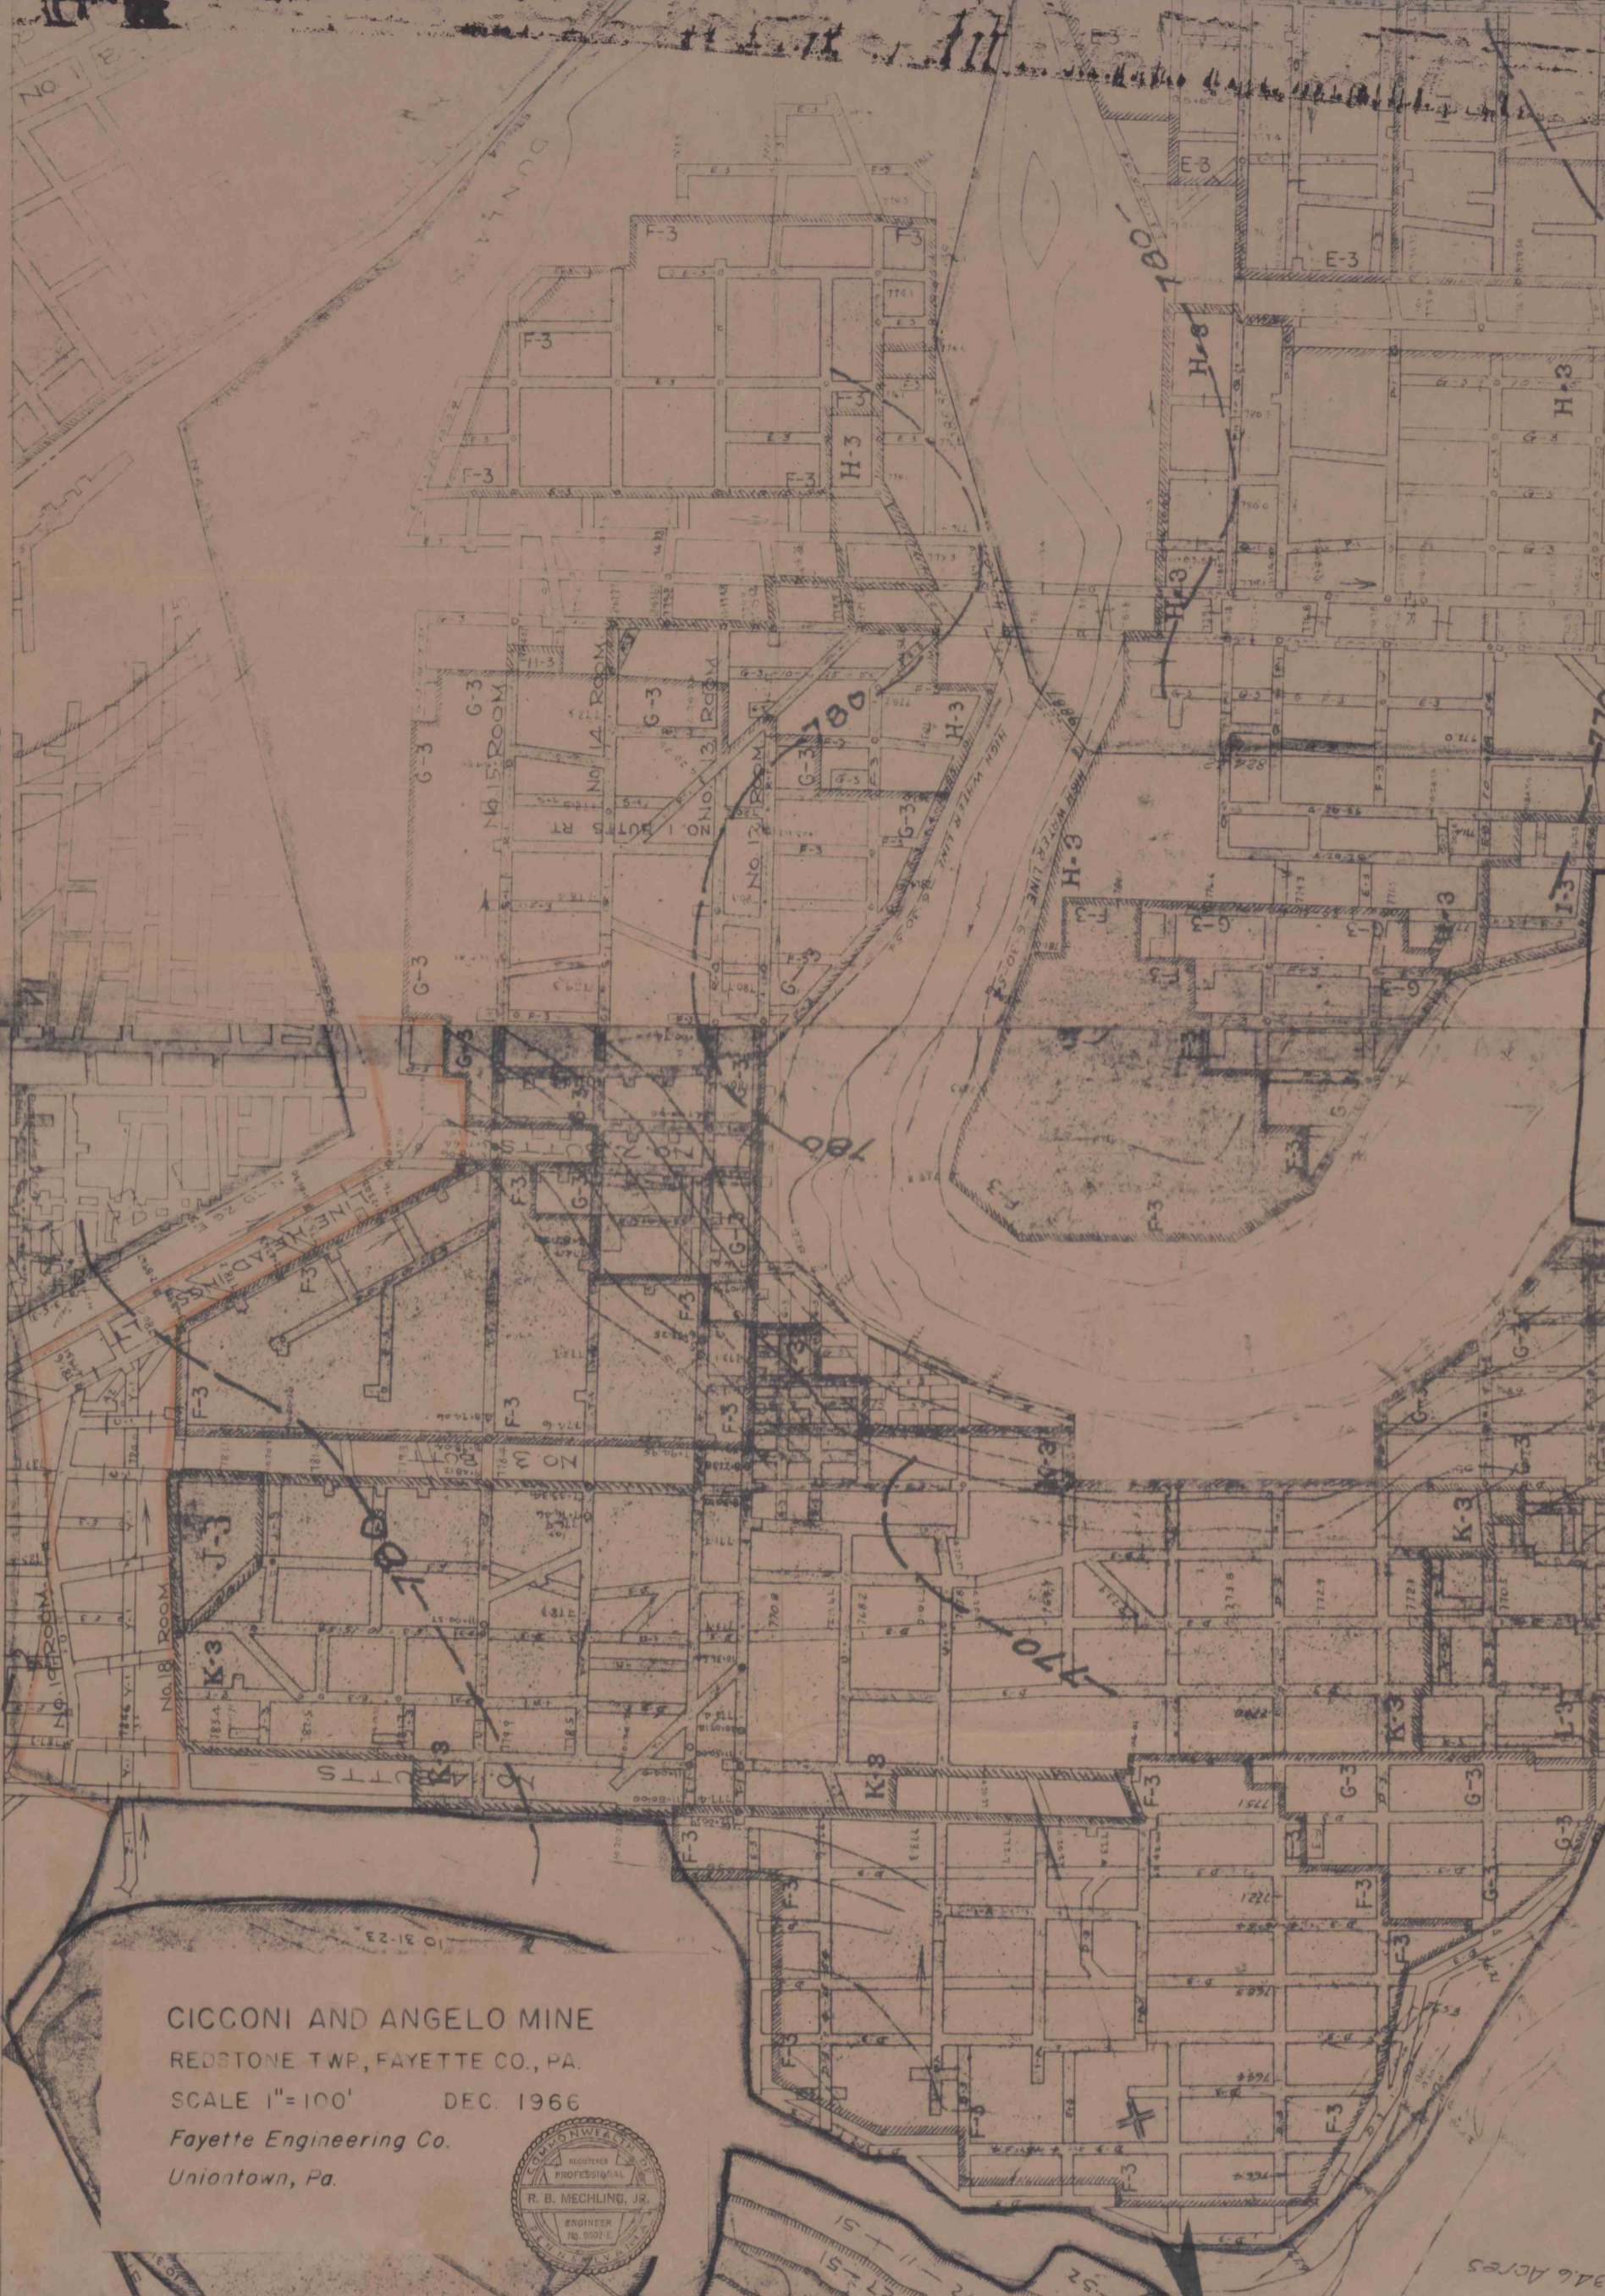

34.6 Acres