


GEO. AINSLEY SURFACE  
CARL MALINSKY COAL

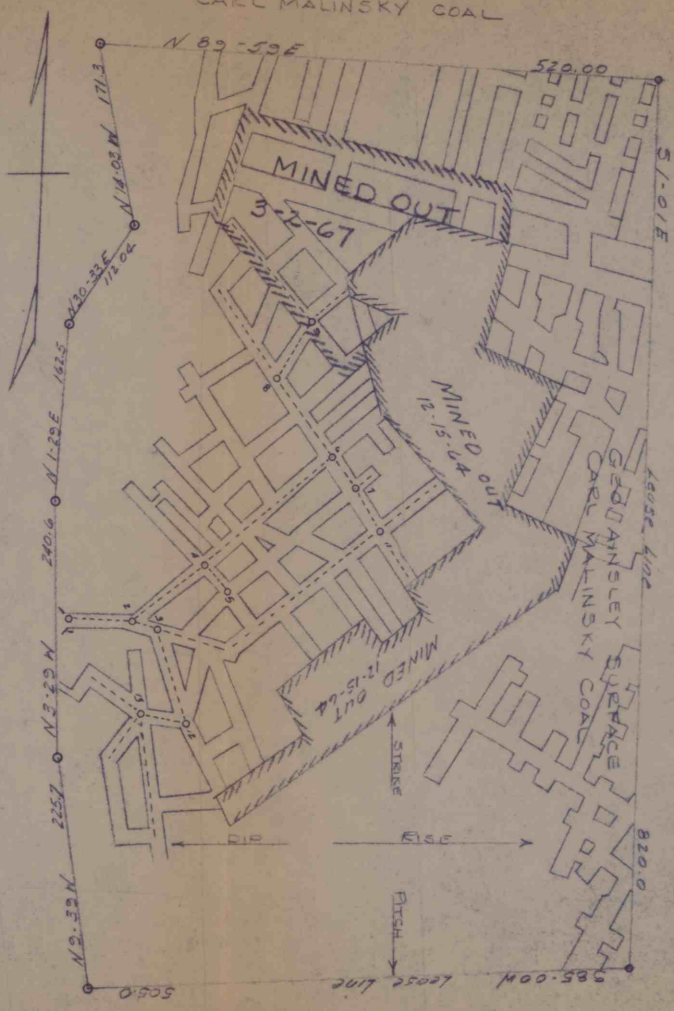

GEO. AINSLEY SURFACE  
CARL MALINSKY COAL

GEO. AINSLEY SURFACE  
CARL MALINSKY COAL

DATE	SURVEY BY
3-2-67	William A. Thistlethwaite

Malinsky Coal / CO. MINE NO. 1  
 Sewichley Coal  
 Nicholson Twp. - Fayette Co. Pa.  
 Dec. 15, 1964      Scale 1" = 100'  
 Survey by - William A. Thistlethwaite  
 Reg. Surveyor # 7770 E