

T. J. JOHNSON

T. J. JOHNSON
N 25-40W

435.51
N 25-40W

T. F. JOHNSON

1546.62



S 64-20W 20 ACRES LEASED TO WILLIS RABER BY T. J. JOHNSON 2130.41

S 64-20W 46.54 ACRES CONVEYED TO WILLIS RABER BY T. J. JOHNSON 1941.65

S 23-42W 258.56
S 61-25E 101.0
N 64-09E 511.50


S 65-57W 885.51

S 36-36E

N 30-51-30W
418.36

S 64-20-05W

S 36-24E

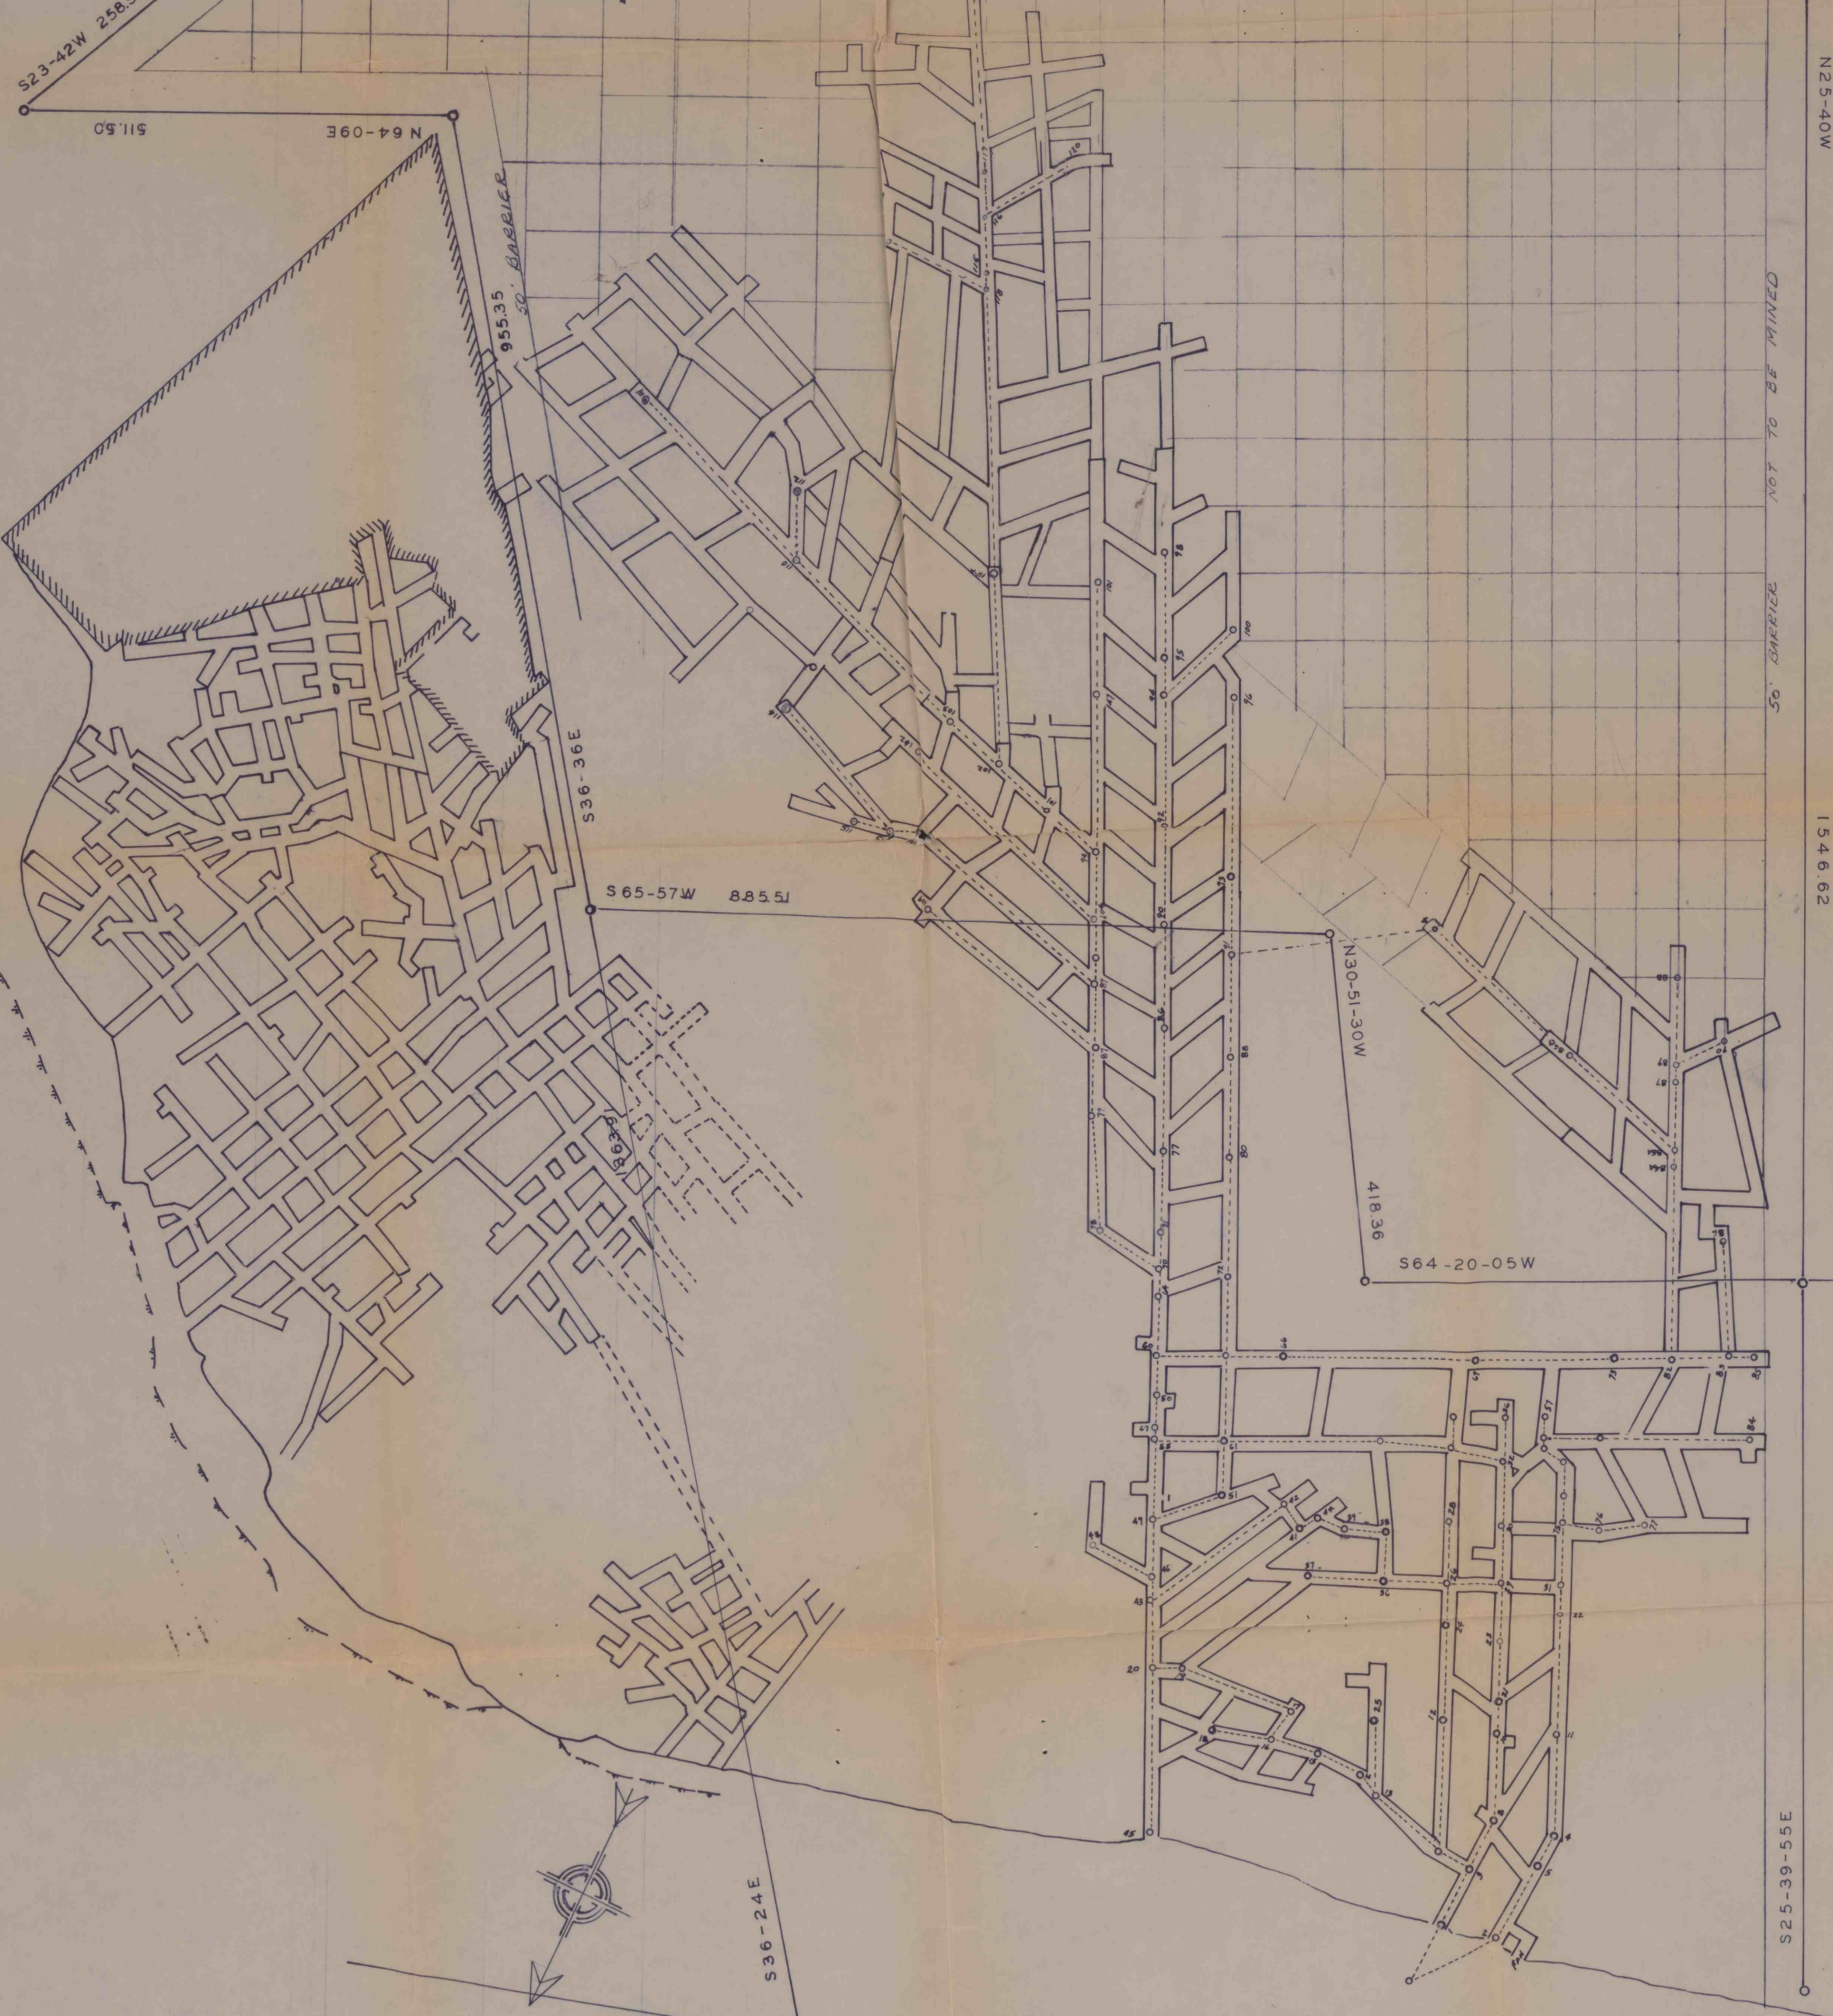

DUNKARD MINE
 RAYMOND N. CHESSE - OPERATOR
 DUNKARD TWP - GREENE CO. - PENNA.
 SCALE 1" = 100' MARCH 1964
 WILLIAM A. THISTLETHWAITE
 REGISTERED SURVEYOR NO. 7770E

SURVEY DATE
A May 1964
B Dec 1964
C Sept. 1965
D May 1966
E Sept. 1966
F Nov. 1966
G Jan 1967

