




MILTON LAPE

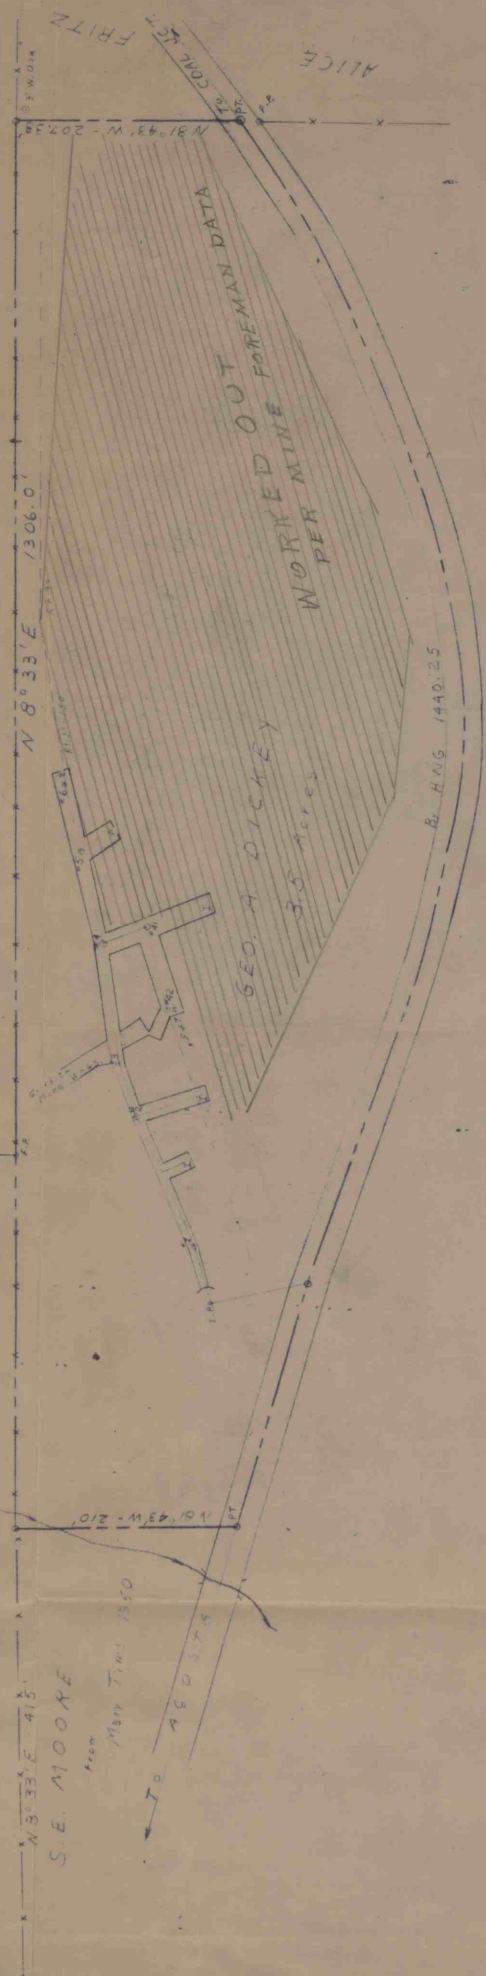

JUNIOR HARTMAN

Neri, Georges Archille
 Dickey #1
 Dickey #2 Oct 1987
 Somerset Co. District 20
 1956 Annual

THE NEILAN ENGINEERS
 PLOT of MINE WORKINGS
 ON
 GEORGE A. DICKEY TRACT
 10
 JENNER TWP., SOMERSET CO., PA.
 SURVEYED - C. McL. APRIL 1951
 PLOTTED - C. McL. SCALE - 1 in = 100 ft.