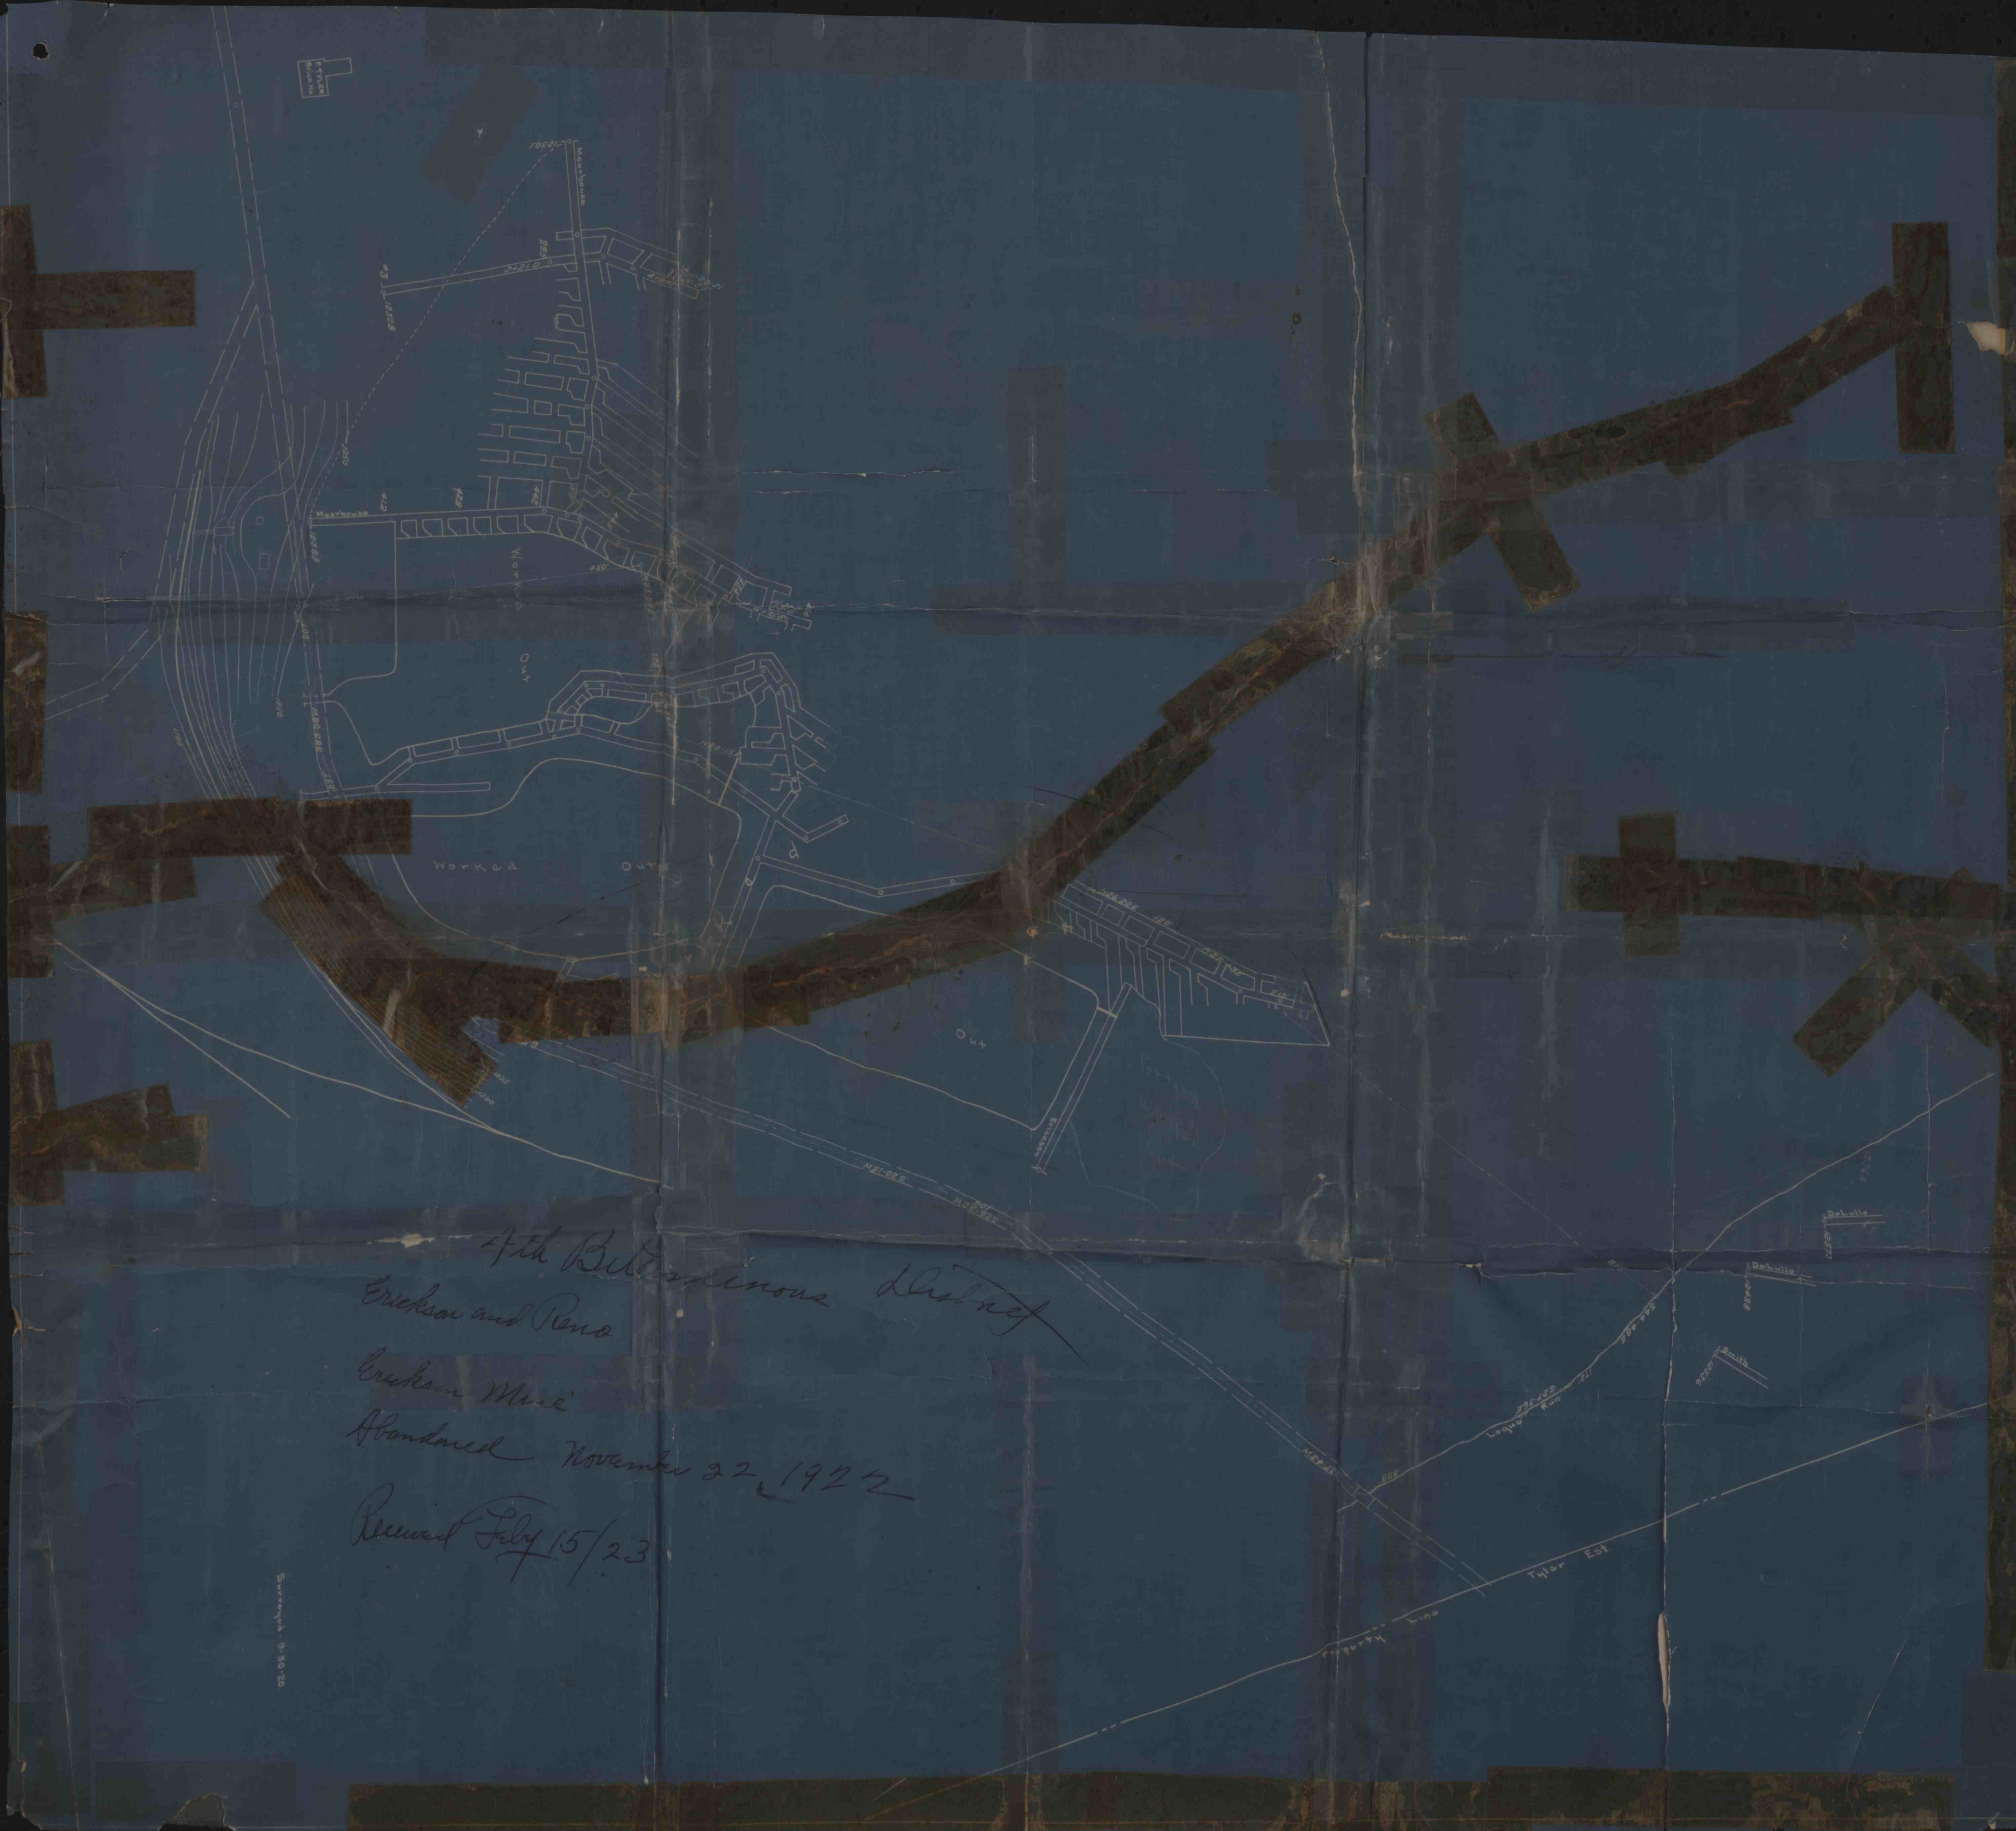
4th Bituminous District
Erickson and Reno
Erickson Mine
Abandoned November 22, 1922
Received Feby 15/23
P. TYLER Brick Ho.
Moorhouse
Moorhouse
Worked Out
Worked Out
Out
Erickson
S20-18W
Loque Run
Tyler Est
Property Line
DeLullo
DeLullo
Smith
Surveyed 9-30-20