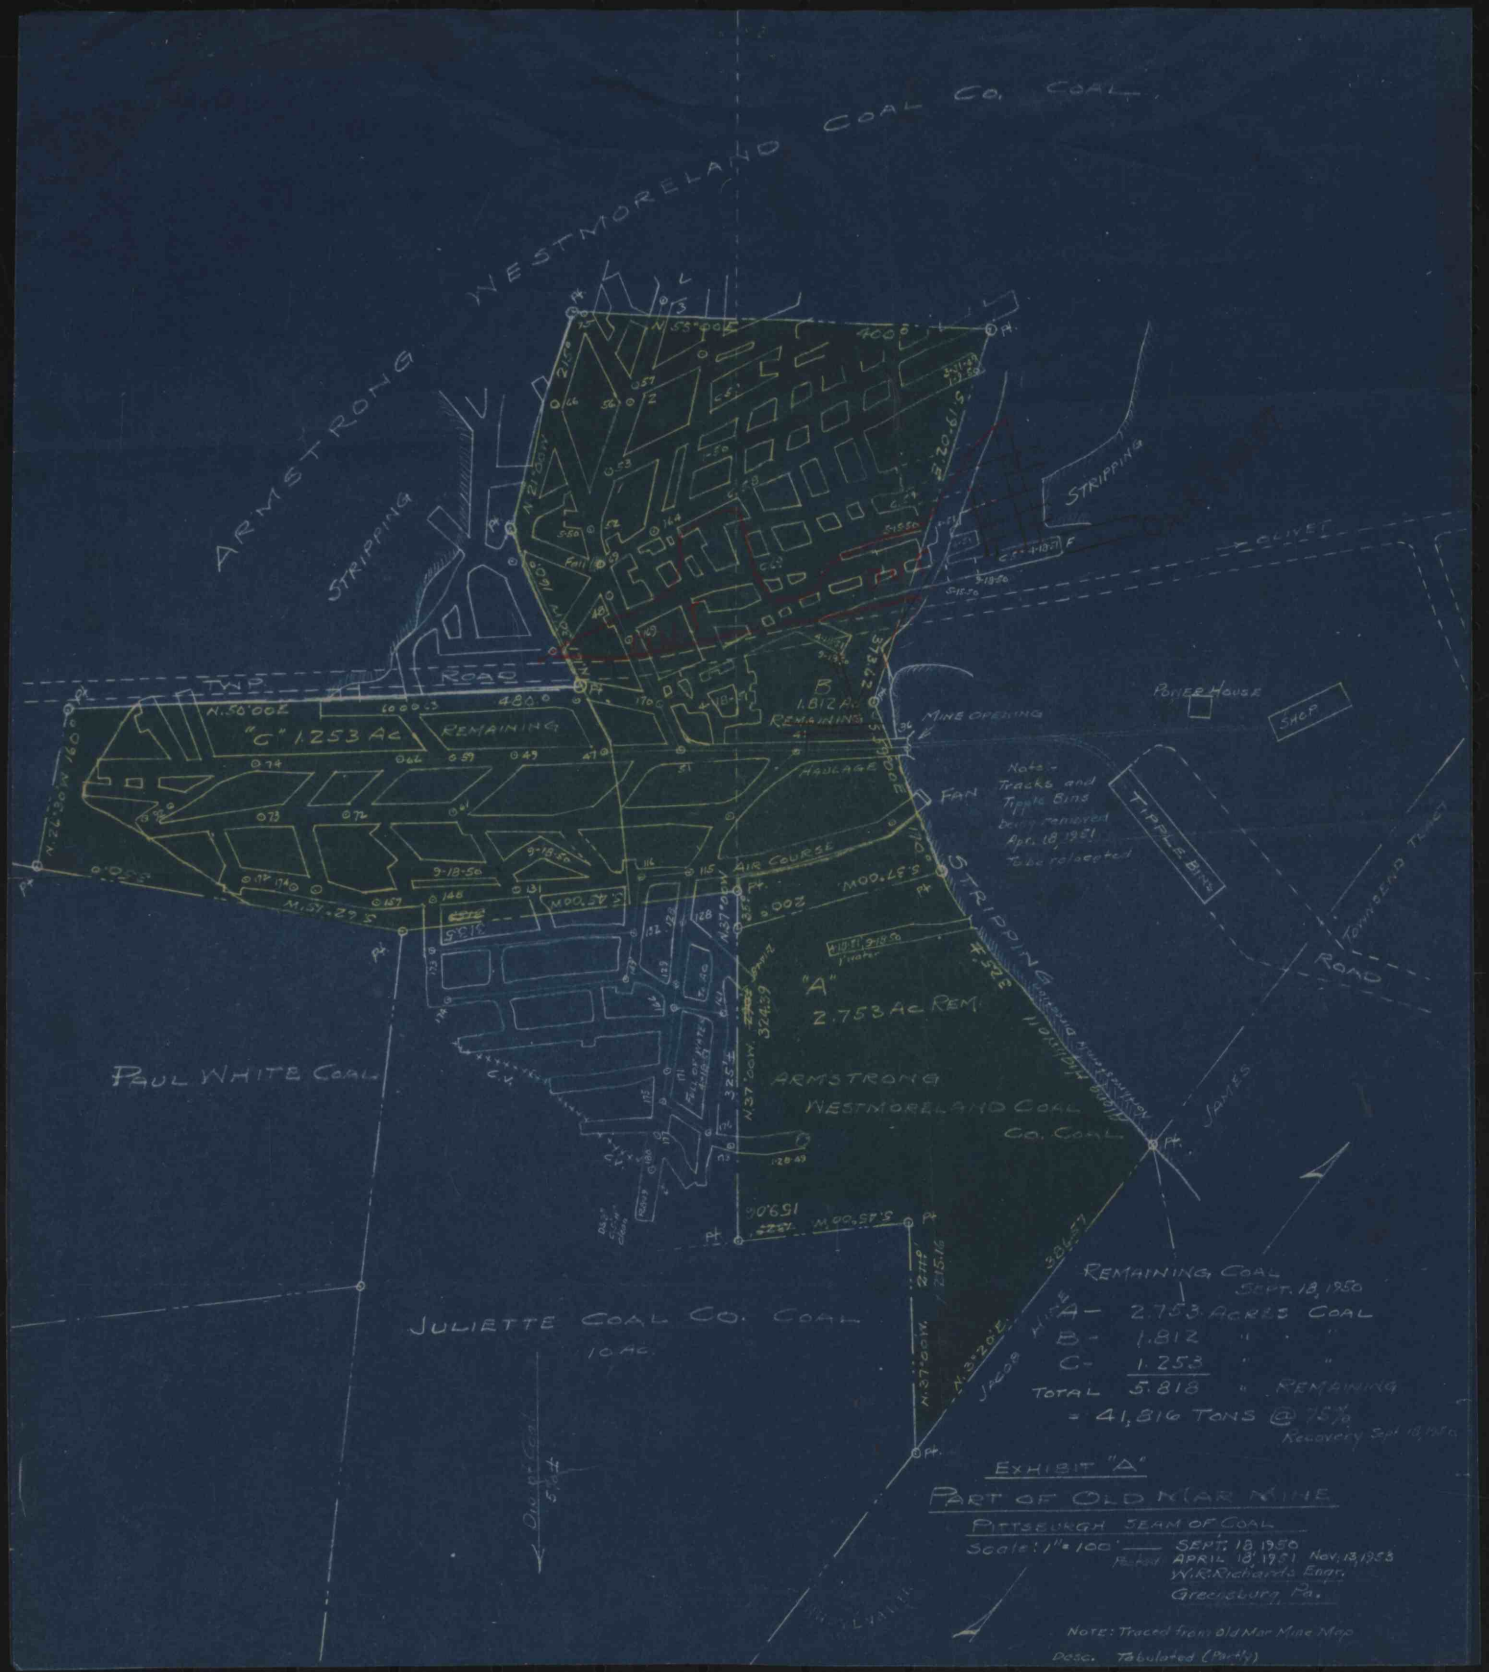
ARMSTRONG WESTMORELAND COAL CO. COAL
STRIPPING
STRIPPING
TWP. ROAD
"C" 1.253 Ac REMAINING
B 1.812 Ac REMAINING
MINE OPENING
HAULAGE
FAN
AIR COURSE
STRIPPING
"A" 2.753 Ac REM.
PAUL WHITE COAL
ARMSTRONG WESTMORELAND COAL CO. COAL
JULIETTE COAL CO. COAL
10 AC.
POWER HOUSE
SHOP
TIPPLE BINS
TOWNSEND TRACT
ROAD
JAMES
JACOB HILL
Note:- Tracks and Tipple Bins being removed Apr. 18, 1951 To be relocated
REMAINING COAL SEPT. 18, 1950
A- 2.753 ACRES COAL
B- 1.812 " "
C- 1.253 " "
TOTAL 5.818 " REMAINING
= 41,816 TONS @ 75%
Recovery Sept 18, 1950
EXHIBIT "A"
PART OF OLD MAR MINE
PITTSBURGH SEAM OF COAL
Scale: 1" = 100'
SEPT. 18, 1950
APRIL 18, 1951 Nov. 13, 1953
W.R. Richards Engr.
Greensburg, Pa.
NOTE: Traced from Old Mar Mine Map
Desc. Tabulated (Partly)