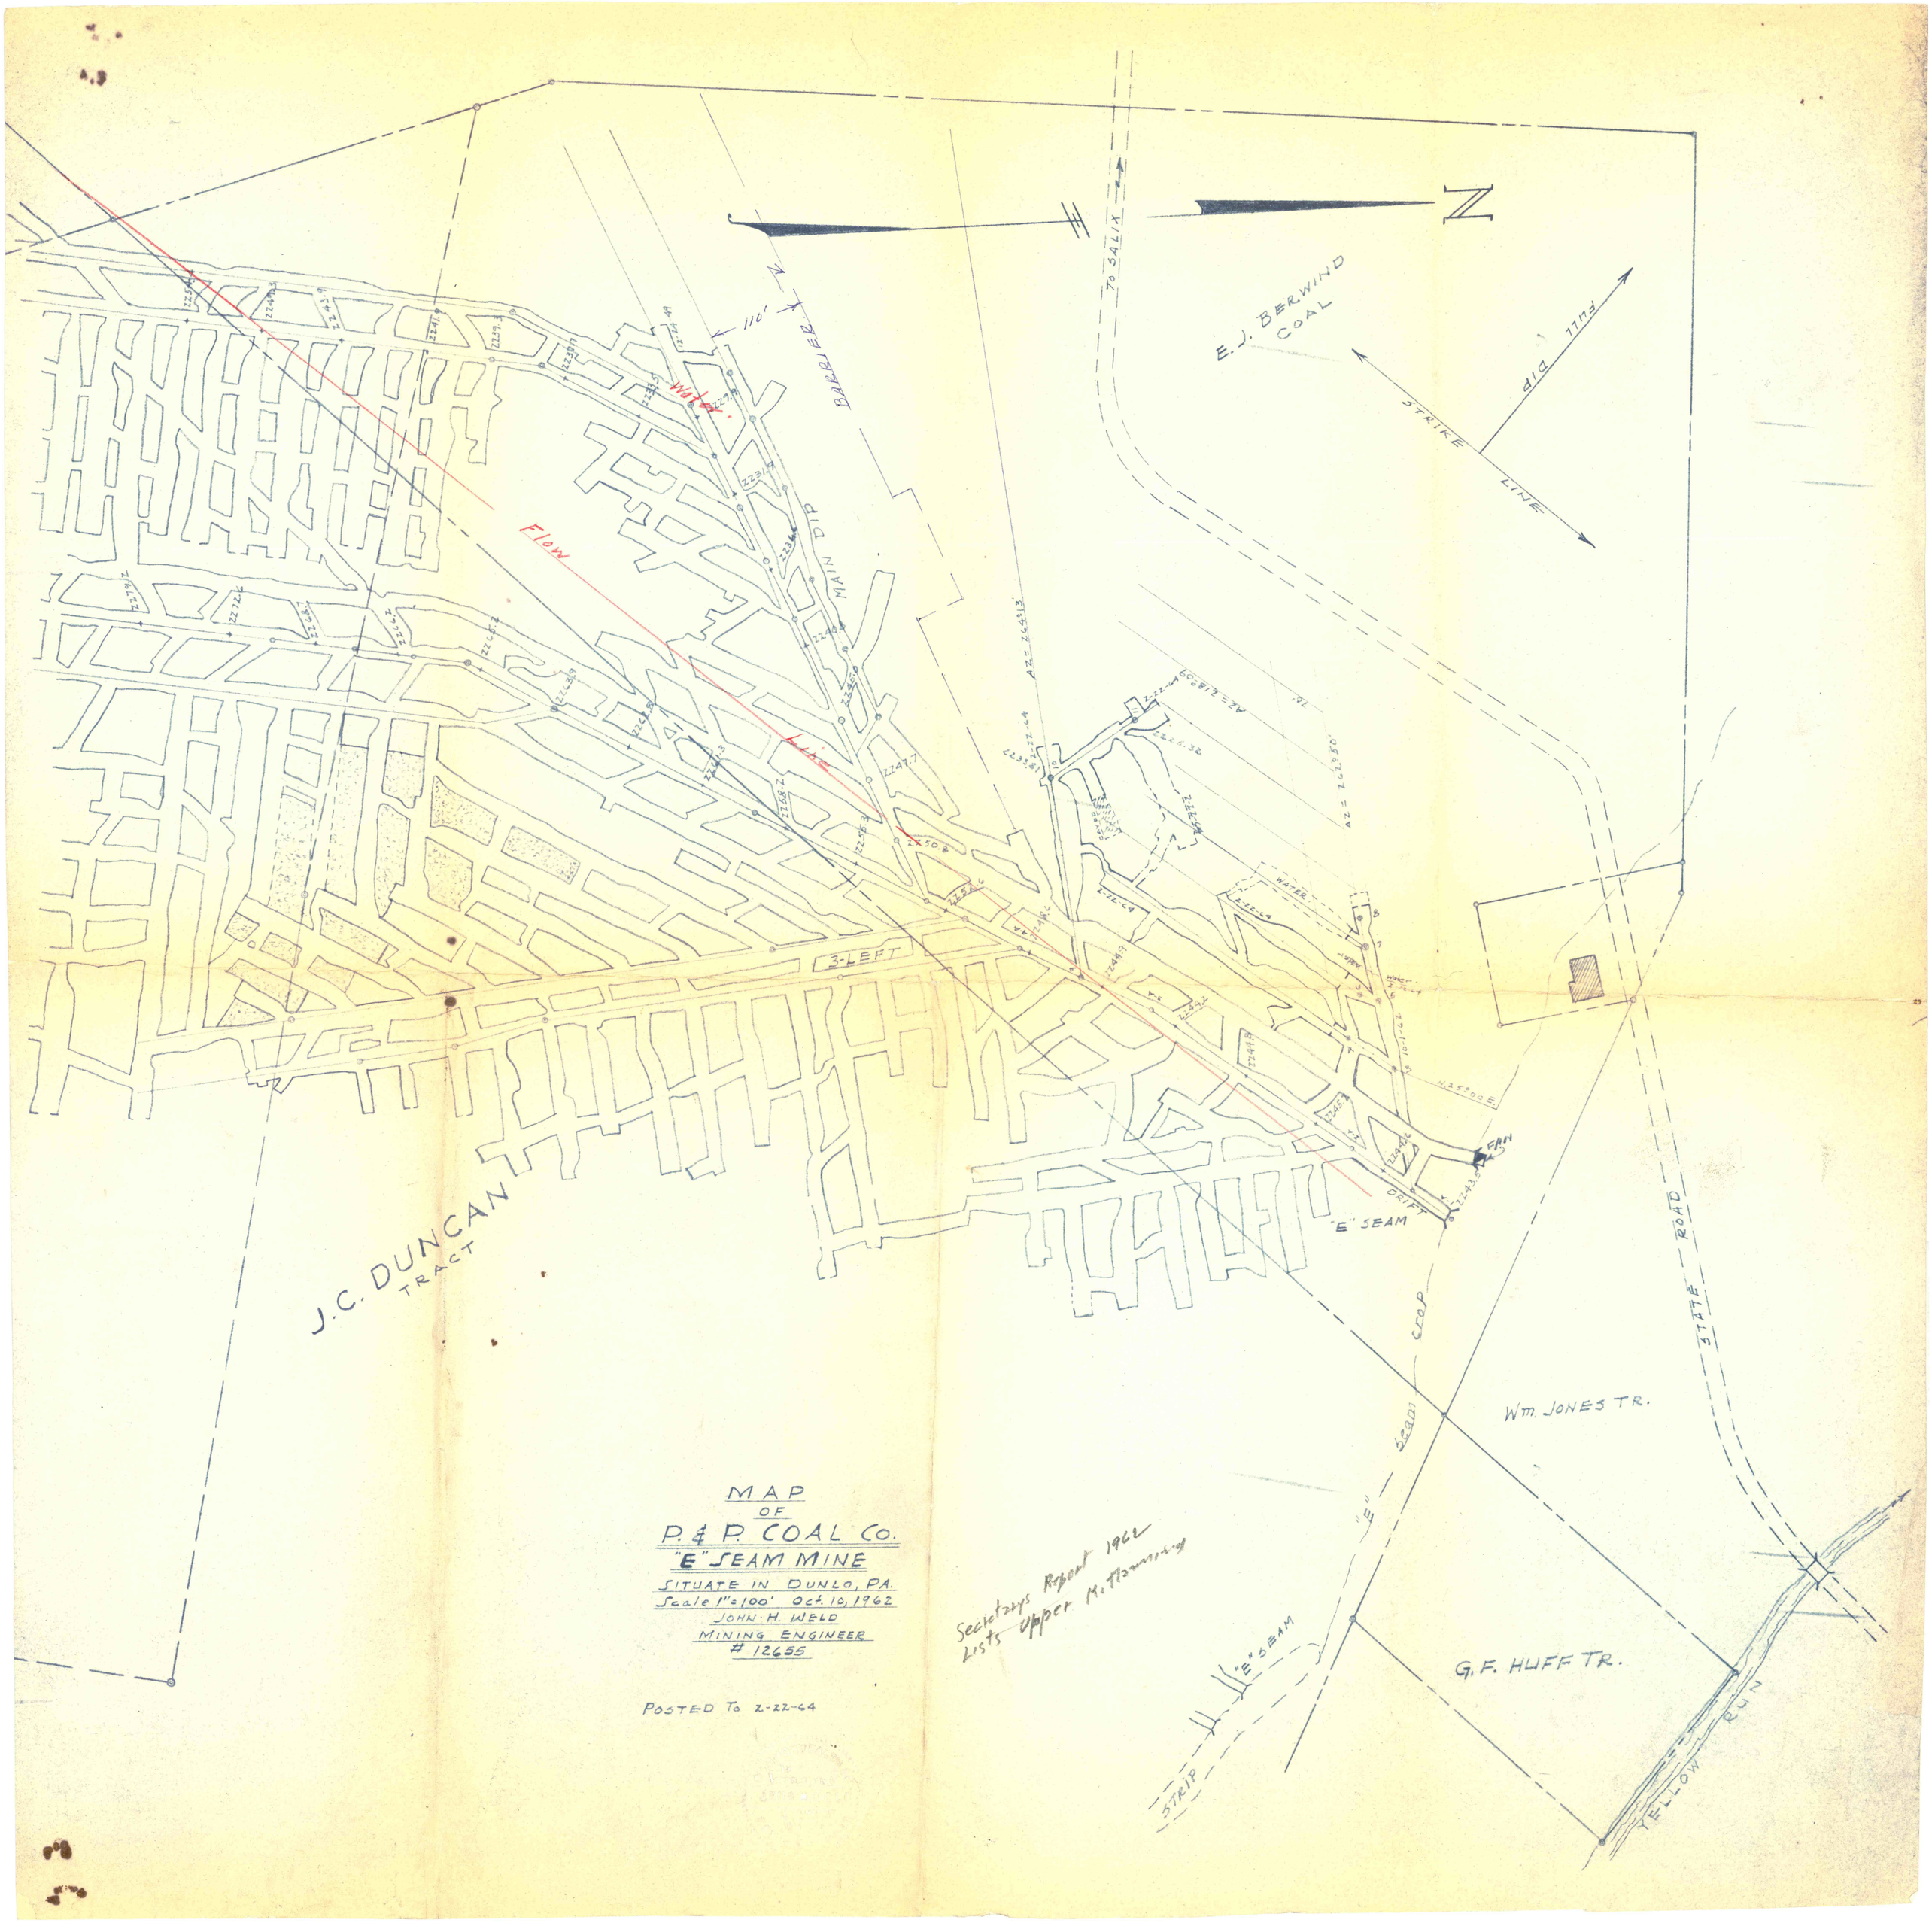

MAP
OF
P. & P. COAL Co.
"E" SEAM MINE
SITUATE IN DUNLO, PA.
Scale 1" = 100' Oct. 10, 1962
JOHN H. WELD
MINING ENGINEER
12655

POSTED TO 2-22-64

Secretarys Report 1962
Lists Upper Mitchell